

Marel Meat Processing B.V.
Industrielaan 63
5349 AE Oss
P.O. Box 292, 5340 AG Oss
the Netherlands
T: +31(0) 412 669911
F: +31(0) 412 669250
I: www.marel.com



Marel Meat Processing Inc.
2425 Hubbell Avenue
Des Moines, IA 50317
P.O. Box 1433, Des Moines, IA 50305
U.S.A.
T: +1 515 265 8181
F: +1 515 263 3333
I: www.marel.com
T: USA 800 247 8609

ELECTRICAL DIAGRAM
CONTROL SYSTEM
RC05xx

380-480V 3-WIRE

DRAWING NUMBER : 9667279

REFERENCE DRAWING NUMBER :
DIMENSIONS OF ENCLOSURE [mm]: 800 x 1400 x 400 (WxHxD)
CUSTOMER :
CUSTOMER CITY :
CUSTOMER STATE :
CUSTOMER COUNTRY :

NUMBER OF PAGES : 117
HARDWARE ENGINEER : JEL
CREATED ON : 2012.11.16

EDITED BY :
EDIT DATE : 2013.08.05 (YYYY-MM-DD)
PROJECT REVISION : D

STRUCTURE IDENTIFIER OVERVIEW

[illegible]

```
previous:
1
```

```
next:
  3
```



THIS DRAWING REMAINS PROPERTY OF MAREL ENTITY,
SPECIFIED ON PAGE 1 AND MAY NOT BE COPIED OR
REPRODUCED IN WHATEVER FORM WITHOUT PRIOR WRITTEN
CONSENT OF MAREL. FURTHER THIS DRAWING MAY NOT BE
DISCLOSED OR GIVEN TO ANY OTHER PARTY FOR INFORMATION
OR USE WITHOUT PRIOR WRITTEN CONSENT OF MAREL.

PROJ. TYPE:	RC05xx
-------------	--------

CUSTOMER:

COUNTRY:

PAGE DESCR.:	STRUCTURE IDENTIFIER OVERVIEW
=GEN	GENERAL DOCUMENTATION

PAGE REV. DATE:
2013.01.28

PAGE REV.

PROJ REV

C	SCALE: 1:1	PAGE: 2
---	---------------	------------

D	DWG. NO.	9667279
---	----------	---------

EDITED ON: 2013.07.11	BY:
CREATED ON: 2012.11.16	BY: JEL

DWG. NO. 966/279
SHEET / TOTAL : (02 / 117)

REVISION OVERVIEW

REVISION	PROJECT REVISION COMMENT	PAGE	PAGE REVISION DESCRIPTION	ENGINEER	DATE
D	ADDED RC0526	=REP/919	New page created		2013.07.11
D	ADDED RC0526	=PRSP+RC0525/1023	ADDED 206B6		2013.07.10
D	ADDED RC0526	+RC05xx/401	401B7 APPLIED FOR RC0525 AND RC0526		2013.07.10
D	ADDED RC0526	+RC05xx/302	302H6 APPLIED FOR RC0525 AND RC0526 , ADDED RC0526-302Y4 AND-302Y5		2013.07.10
D	ADDED RC0526	+RC05xx/206	206S3, 102S7 APPLIED FOR RC0525 AND RC0526 , 206B6 ONLY FOR RC0525		2013.07.10
D	ADDED RC0526	+RC05xx/102	102S6, 102S7 APPLIED FOR RC0525 AND RC0526 , 102S4 NOT FOR RC0525 AND RC0526		2013.07.10
D	ADDED RC0526	+RC05xx/6	ADDED RC0526 IN TABLE		2013.07.10
D	ADDED RC0526	=PRSP+RC0526/1034	New page created		2013.07.10
D	ADDED RC0526	=PRSP+RC0526/1033	New page created		2013.07.10
D	ADDED RC0526	=PRSP+RC0526/1032	New page created		2013.07.10
D	ADDED RC0526	=PRSP+RC0526/1031	New page created		2013.07.10
C	AS BUILT (DRAWING CORRECTIONS)	=CP+RC05xx/511	ADDED WATER DRAINAGE COVER ABOVE HMI	MVN	2013.05.22
C	AS BUILT (DRAWING CORRECTIONS)	=TB+RC05xx/543	CHANGED SIZE TERMINAL BOX 4E2 220X120X90 WAS 160X160X90	MVN	2013.05.22
C	AS BUILT (DRAWING CORRECTIONS)	=REP/752	AS BUILT (DRAWING CORRECTIONS)	JEL	2013.01.28
C	AS BUILT (DRAWING CORRECTIONS)	=GEN/3.A	New page created	JEL	2013.01.28
C	AS BUILT (DRAWING CORRECTIONS)	=REP/753	New page created	JEL	2013.01.28
C	AS BUILT (DRAWING CORRECTIONS)	=REP/752	New page created	JEL	2013.01.28
C	AS BUILT (DRAWING CORRECTIONS)	=GEN/2	CONTROLLED FUNCTION NAMES	JEL	2013.01.28
C	AS BUILT (DRAWING CORRECTIONS)	+RC05xx/200	CONTROLLED FUNCTION NAMES	JEL	2013.01.28
C	AS BUILT (DRAWING CORRECTIONS)	+RC05xx/201	CONTROLLED FUNCTION NAMES	JEL	2013.01.28
C	AS BUILT (DRAWING CORRECTIONS)	+RC05xx/203	CONTROLLED FUNCTION NAMES	JEL	2013.01.28
C	AS BUILT (DRAWING CORRECTIONS)	+RC05xx/206	CONTROLLED FUNCTION NAMES	JEL	2013.01.28
C	AS BUILT (DRAWING CORRECTIONS)	+RC05xx/301	CONTROLLED FUNCTION NAMES	JEL	2013.01.28
C	AS BUILT (DRAWING CORRECTIONS)	+RC05xx/302	CONTROLLED FUNCTION NAMES	JEL	2013.01.28
C	AS BUILT (DRAWING CORRECTIONS)	+RC05xx/202	CONTROLLED FUNCTION NAMES	JEL	2013.01.28
C	AS BUILT (DRAWING CORRECTIONS)	+RC05xx/304	CONTROLLED FUNCTION NAMES	JEL	2013.01.28
C	AS BUILT (DRAWING CORRECTIONS)	=REP/700	CONTROLLED FUNCTION NAMES	JEL	2013.01.28
C	AS BUILT (DRAWING CORRECTIONS)	=REP/752	CONTROLLED FUNCTION NAMES	JEL	2013.01.28
C	AS BUILT (DRAWING CORRECTIONS)	=REP/753	CONTROLLED FUNCTION NAMES	JEL	2013.01.28

REVISION OVERVIEW

[illegible]

previous:
3

```
ext:
  4
```



THIS DRAWING REMAINS PROPERTY OF MAREL ENTITY,
SPECIFIED ON PAGE 1 AND MAY NOT BE COPIED OR
REPRODUCED IN WHATEVER FORM WITHOUT PRIOR WRITTEN
CONSENT OF MAREL. FURTHER THIS DRAWING MAY NOT BE
DISCLOSED OR GIVEN TO ANY OTHER PARTY FOR INFORMATION
OR USE WITHOUT PRIOR WRITTEN CONSENT OF MAREL.

PROJ. TYPE:	RC05xx
CUSTOMER:	
COUNTRY:	

PAGE DESCR.: REVISION OVERVIEW
=GEN GENERAL DOCUMENTATION

PAGE REV. DATE:
2013.01.28

PAGE REV.
PR01 REV.

SCALE:	PAGE:	3.A
1:1		

EDITED ON: 2013.07.11	BY:
CREATED ON: 2012.11.16	BY: JEL

DWG. NO.	966/2/9
SHEET / TOTAL :	(04 / 117)

TABLE OF CONTENTS

Column X: An automatically generated page was edited

SHEET	PAGE	HIGHER-LEVEL FUNCTION (=)	MOUNTING LOCATION (+)	PAGE DESCRIPTION	EDITED BY	EDIT DATE	X
01	=GEN/1	GENERAL DOCUMENTATION		TITLE PAGE		2013.07.11	
02	=GEN/2	GENERAL DOCUMENTATION		STRUCTURE IDENTIFIER OVERVIEW		2013.07.11	
03	=GEN/3	GENERAL DOCUMENTATION		REVISION OVERVIEW		2013.07.11	
04	=GEN/3.A	GENERAL DOCUMENTATION		REVISION OVERVIEW		2013.07.11	
05	=GEN/4	GENERAL DOCUMENTATION		TABLE OF CONTENTS		2013.07.11	
06	=GEN/4.A	GENERAL DOCUMENTATION		TABLE OF CONTENTS		2013.07.11	
07	=GEN/4.B	GENERAL DOCUMENTATION		TABLE OF CONTENTS		2013.07.11	
08	=GEN/4.C	GENERAL DOCUMENTATION		TABLE OF CONTENTS		2013.07.11	
09	=GEN/5	GENERAL DOCUMENTATION		PROJECT SPECIFICATION		2013.07.11	
10	+RC05xx/5.A		GENERAL PRESS	TERMINAL STRIP EXPLANATION		2013.07.11	
11	+RC05xx/6		GENERAL PRESS	MAIN CURRENT / MAIN SWITCH		2013.07.11	
12	+RC05xx/7		GENERAL PRESS	MAIN CURRENT / MOTOR		2013.07.11	
13	+RC05xx/8		GENERAL PRESS	MAIN CURRENT / MOTOR		2013.07.11	
14	+RC05xx/9		GENERAL PRESS	MAIN CURRENT / 230VAC DISTRIBUTION		2013.07.11	
15	+RC05xx/10		GENERAL PRESS	MAIN CURRENT / 24VDC DISTRIBUTION		2013.07.11	
16	+RC05xx/100		GENERAL PRESS	GUARD E-STOP CIRCUIT / RELAY		2013.07.11	
17	+RC05xx/101		GENERAL PRESS	GUARD E-STOP CIRCUIT / EXCHANGE		2013.07.11	
18	+RC05xx/102		GENERAL PRESS	GUARD CIRCUIT / PROTECTION DEVICES		2013.07.11	
19	+RC05xx/102.A		GENERAL PRESS	GUARD CIRCUIT / PROTECTION DEVICES		2013.07.11	
20	+RC05xx/103		GENERAL PRESS	CONTROL CURRENT 230VAC / GENERAL MOTORS		2013.07.11	
21	+RC05xx/104		GENERAL PRESS	CONTROL CURRENT 24VDC / VALVES BREAKER		2013.07.11	
22	+RC05xx/105		GENERAL PRESS	CONTROL CURRENT 24VDC / PROPORTIONAL VALVE		2013.07.11	
23	+RC05xx/200		GENERAL PRESS	PLC CONFIGURAION / OVERVIEW		2013.07.11	
24	+RC05xx/201		GENERAL PRESS	CONTROL CURRENT 24VDC / DIGITAL INPUTS		2013.07.11	
25	+RC05xx/202		GENERAL PRESS	CONTROL CURRENT 24VDC / DIGITAL INPUTS		2013.07.11	
26	+RC05xx/203		GENERAL PRESS	CONTROL CURRENT 24VDC / DIGITAL INPUTS		2013.07.11	
27	+RC05xx/204		GENERAL PRESS	CONTROL CURRENT 24VDC / DIGITAL INPUTS		2013.07.11	
28	+RC05xx/205		GENERAL PRESS	CONTROL CURRENT 24VDC / DIGITAL INPUTS		2013.07.11	
29	+RC05xx/206		GENERAL PRESS	CONTROL CURRENT 24VDC / DIGITAL INPUTS		2013.07.11	
30	+RC05xx/207		GENERAL PRESS	CONTROL CURRENT 24VDC / DIGITAL INPUTS		2013.07.11	
31	+RC05xx/208		GENERAL PRESS	CONTROL CURRENT 24VDC / DIGITAL INPUTS		2013.07.11	
32	+RC05xx/301		GENERAL PRESS	CONTROL CURRENT 24VDC / DIGITAL OUTPUTS		2013.07.11	
33	+RC05xx/302		GENERAL PRESS	CONTROL CURRENT 24VDC / DIGITAL OUTPUTS		2013.07.11	

TABLE OF CONTENTS

Column X: An automatically generated page was edited

SHEET	PAGE	HIGHER-LEVEL FUNCTION (=)	MOUNTING LOCATION (+)	PAGE DESCRIPTION	EDITED BY	EDIT DATE	X
34	+RC05xx/303		GENERAL PRESS	CONTROL CURRENT 24VDC / DIGITAL OUTPUTS		2013.07.11	
35	+RC05xx/304		GENERAL PRESS	CONTROL CURRENT 24VDC / DIGITAL OUTPUTS		2013.07.11	
36	+RC05xx/305		GENERAL PRESS	CONTROL CURRENT 24VDC / DIGITAL OUTPUTS		2013.07.11	
37	+RC05xx/315		GENERAL PRESS	CONTROL CURRENT 24VDC / DIGITAL OUTPUTS		2013.07.11	
38	+RC05xx/401		GENERAL PRESS	CONTROL CURRENT 24VDC / ANALOG INPUTS		2013.07.11	
39	+RC05xx/402		GENERAL PRESS	CONTROL CURRENT 24VDC / ANALOG OUTPUTS		2013.07.11	
40	+RC05xx/451		GENERAL PRESS	CONTROL CURRENT 230VAC / COMMUNICATION PLC HMI		2013.07.11	
41	=CP+RC05xx/511	CONTROL PANEL	GENERAL PRESS	PANEL LAYOUT / DOOR		2013.07.11	
42	=CP+RC05xx/512	CONTROL PANEL	GENERAL PRESS	PANEL LAYOUT / MOUNTINGPLATE		2013.07.11	
43	=CP+RC05xx/513	CONTROL PANEL	GENERAL PRESS	PANEL LAYOUT / TEXT PLATES		2013.07.11	
44	=CP+RC0522/515	CONTROL PANEL	DMM50, PRESS	ENCLOSURE LEGEND		2013.07.11	
45	=CP+RC0522/515.A	CONTROL PANEL	DMM50, PRESS	ENCLOSURE LEGEND		2013.07.11	
46	=CB+RC05xx/521	CONTROL BOX	GENERAL PRESS	PANEL LAYOUT / CONTROL BOX SERVICE		2013.07.11	
47	=CB+RC05xx/522	CONTROL BOX	GENERAL PRESS	PANEL LAYOUT / CONTROL BOX OPERATOR		2013.07.11	
48	=CB+RC0525/6/523	CONTROL BOX		PANEL LAYOUT / CONTROL BOX OPERATOR		2013.07.11	
49	=CB+RC0525/6/524	CONTROL BOX		ENCLOSURE LEGEND		2013.07.11	
50	=TB+RC05xx/541	TERMINAL BOX	GENERAL PRESS	PANEL LAYOUT / TERMINAL BOX 4E1		2013.07.11	
51	=TB+RC05xx/543	TERMINAL BOX	GENERAL PRESS	PANEL LAYOUT / TERMINAL BOX 4E2		2013.07.11	
52	=REP/700	REPORTS		TERMINAL-STRIP OVERVIEW		2013.07.11	
53	=REP/701	REPORTS		TERMINAL-CONNECT.DIAGRAM =CP+RC05xx-X1A		2013.07.11	
54	=REP/702	REPORTS		TERMINAL-CONNECT.DIAGRAM =CP+RC05xx-X2A		2013.07.11	
55	=REP/703	REPORTS		TERMINAL-CONNECT.DIAGRAM =CP+RC05xx-X2B		2013.07.11	
56	=REP/704	REPORTS		TERMINAL-CONNECT.DIAGRAM =CP+RC05xx-X2C		2013.07.11	
57	=REP/705	REPORTS		TERMINAL-CONNECT.DIAGRAM =CP+RC05xx-X2D		2013.07.11	
58	=REP/706	REPORTS		TERMINAL-CONNECT.DIAGRAM =CP+RC05xx-X2E		2013.07.11	
59	=REP/707	REPORTS		TERMINAL-CONNECT.DIAGRAM =CP+RC05xx-X3A		2013.07.11	
60	=REP/708	REPORTS		TERMINAL-CONNECT.DIAGRAM =CP+RC05xx-X3B		2013.07.11	
61	=REP/709	REPORTS		TERMINAL-CONNECT.DIAGRAM =CP+RC05xx-X3C		2013.07.11	
62	=REP/710	REPORTS		TERMINAL-CONNECT.DIAGRAM =CP+RC05xx-X4A		2013.07.11	
63	=REP/711	REPORTS		TERMINAL-CONNECT.DIAGRAM =CP+RC05xx-X4B		2013.07.11	
64	=REP/712	REPORTS		TERMINAL-CONNECT.DIAGRAM =CP+RC05xx-X5A		2013.07.11	
65	=REP/713	REPORTS		TERMINAL-CONNECT.DIAGRAM =CP+RC05xx-X6A		2013.07.11	
66	=REP/714	REPORTS		TERMINAL-CONNECT.DIAGRAM =CP+RC05xx-X7A		2013.07.11	

TABLE OF CONTENTS

Column X: An automatically generated page was edited

SHEET	PAGE	HIGHER-LEVEL FUNCTION (=)	MOUNTING LOCATION (+)	PAGE DESCRIPTION	EDITED BY	EDIT DATE	X
67	=REP/716	REPORTS		TERMINAL-CONNECT.DIAGRAM =CB+RC05xx-X2A.2		2013.07.11	
68	=REP/717	REPORTS		TERMINAL-CONNECT.DIAGRAM =CB+RC05xx-X3A.2		2013.07.11	
69	=REP/718	REPORTS		TERMINAL-CONNECT.DIAGRAM =CB+RC05xx-X4A.2		2013.07.11	
70	=REP/719	REPORTS		TERMINAL-CONNECT.DIAGRAM =TB+RC05xx-X2A.1		2013.07.11	
71	=REP/720	REPORTS		TERMINAL-CONNECT.DIAGRAM =TB+RC05xx-X2A.3		2013.07.11	
72	=REP/721	REPORTS		TERMINAL-CONNECT.DIAGRAM =TB+RC05xx-X3A.1		2013.07.11	
73	=REP/722	REPORTS		TERMINAL-CONNECT.DIAGRAM =TB+RC05xx-X3A.3		2013.07.11	
74	=REP/723	REPORTS		TERMINAL-CONNECT.DIAGRAM =TB+RC05xx-X4A.1		2013.07.11	
75	=REP/723.A	REPORTS		TERMINAL-CONNECT.DIAGRAM =TB+RC05xx-X4A.1		2013.07.11	
76	=REP/724	REPORTS		TERMINAL-CONNECT.DIAGRAM =TB+RC05xx-X5A.1		2013.07.11	
77	=REP/752	REPORTS		PIN-CONNECTION DIAGRAM =CB+RC05xx-4X3.1		2013.07.11	
78	=REP/753	REPORTS		PIN-CONNECTION DIAGRAM =F+RC05xx-4X3		2013.07.11	
79	=REP/800	REPORTS		CABLE OVERVIEW		2013.07.11	
80	=REP/800.A	REPORTS		CABLE OVERVIEW		2013.07.11	
81	=REP/901	REPORTS		PARTS LIST		2013.07.11	
82	=REP/902	REPORTS		PARTS LIST		2013.07.11	
83	=REP/903	REPORTS		PARTS LIST		2013.07.11	
84	=REP/904	REPORTS		PARTS LIST		2013.07.11	
85	=REP/905	REPORTS		PARTS LIST		2013.07.11	
86	=REP/906	REPORTS		PARTS LIST		2013.07.11	
87	=REP/907	REPORTS		PARTS LIST		2013.07.11	
88	=REP/908	REPORTS		PARTS LIST		2013.07.11	
89	=REP/909	REPORTS		PARTS LIST		2013.07.11	
90	=REP/910	REPORTS		PARTS LIST		2013.07.11	
91	=REP/911	REPORTS		PARTS LIST		2013.07.11	
92	=REP/912	REPORTS		PARTS LIST		2013.07.11	
93	=REP/913	REPORTS		PARTS LIST		2013.07.11	
94	=REP/914	REPORTS		PARTS LIST		2013.07.11	
95	=REP/915	REPORTS		PARTS LIST		2013.07.11	
96	=REP/916	REPORTS		PARTS LIST		2013.07.11	
97	=REP/917	REPORTS		PARTS LIST		2013.07.11	
	=REP/919	REPORTS		PARTS LIST		2013.07.11	
99	=PRSP+RC05xx/1001	PROJECT SPECIFICATIONS	GENERAL PRESS	MAIN CURRENT / OVERVIEW TO =CP-4E0		2013.07.11	

TABLE OF CONTENTS

Column X: An automatically generated page was edited

[illegible]

previous:
4.B

next:
5



THIS DRAWING REMAINS PROPERTY OF MAREL ENTITY,
SPECIFIED ON PAGE 1 AND MAY NOT BE COPIED OR
REPRODUCED IN WHATEVER FORM WITHOUT PRIOR WRITTEN
CONSENT OF MAREL. FURTHER THIS DRAWING MAY NOT BE
DISCLOSED OR GIVEN TO ANY OTHER PARTY FOR INFORMATION
OR USE WITHOUT PRIOR WRITTEN CONSENT OF MAREL.

PROJ. TYPE:	RC05xx
CUSTOMER:	
COUNTRY:	

PAGE DESCR.:	TABLE OF CONTENTS
=GEN	GENERAL DOCUMENTATION

PAGE REV. DATE:	PAGE REV.	
	PROJ. REV.	D
EDITED ON: 2013.07.11 BY: CREATED ON: 2012.11.16 BY: JEL		


SCALE: 1:1 PAGE: 4.C


DWG. NO. 9667279

SHEET / TOTAL : (08 / 117)

PROJECT SPECIFICATION

WIRE SPECIFICATION		COLOUR	MINIMUM CROSS-SECTION AREA		COLOUR-CODING EXPLANATION	
MAIN CURRENT	: 200-600VAC	: BLACK	: AWG 14	(2.5 mm²)	WH	= WHITE
MAIN CURRENT	: 0-230VAC PHASE	: BLACK	: AWG 16	(1.5 mm²)	BN	= BROWN
		NEUTRAL : LIGHT BLUE	: AWG 16	(1.5 mm²)	GN	= GREEN
A.C. CONTROL CURRENTS	: L	: RED	: AWG 16	(1.0 mm²)	YE	= YELLOW
	: N	: RED	: AWG 16	(1.0 mm²)	GY	= GRAY
	: SWITCHED CIRCUIT	: RED	: AWG 22	(0.5 mm²)	PK	= PINK
D.C. CONTROL CURRENTS	: +	: BLUE	: AWG 16	(1.0 mm²)	BU	= BLUE
	: -	: BLUE	: AWG 16	(1.0 mm²)	RD	= RED
	SWITCHED CIRCUIT	: BLUE	: AWG 22	0.5 mm²	BK	= BLACK
SAFETY CIRCUITS		: WHITE	: AWG 16	(1.0 mm²)	VT	= VIOLET
MEASURING AND REGULATION SIGNALS		: WHITE	: AWG 22	(0.5 mm²)	OG	= ORANGE
EARTH		: GREEN/YELLOW	: AWG 16	(1.0 mm²)	TQ	= TURQOISE
CONTROL CIRCUITS FOR INTERLOCKING		: ORANGE	: AWG 16	(1.0 mm²)	TT	= TRANSPARENT
					BG	= BEIGE
					GNYE	= GREEN/YELLOW
					PUSH-BUTTONS EXPLANATION	
					COLOUR	FUNCTION
					WHITE	START / ON
					BLACK	STOP / OFF
					RED	EMERGENCY STOP
					YELLOW	JOG
					BLUE	RESET
					SIGNAL LAMPS EXPLANATION	
					COLOUR	FUNCTION
MAIN CURRENT		: 200-600VAC	: L1 UPTO AND INCLUDING L49		WHITE	RUNNING
			: N1 UPTO AND INCLUDING N49		GREEN	STAND-BY
CONTROL CURRENT		: 0-230VAC	: L50 UPTO AND INCLUDING L99		RED	SAFETY FAILURE
			: N50 UPTO AND INCLUDING N99		YELLOW	WARNING / TH. FAILURE
CONTROL CURRENT		: 24VAC	: VPL / VPN		BLUE	OPERATOR ACTION REQUIRED
CONTROL CURRENT		: 24VDC	: + / -			

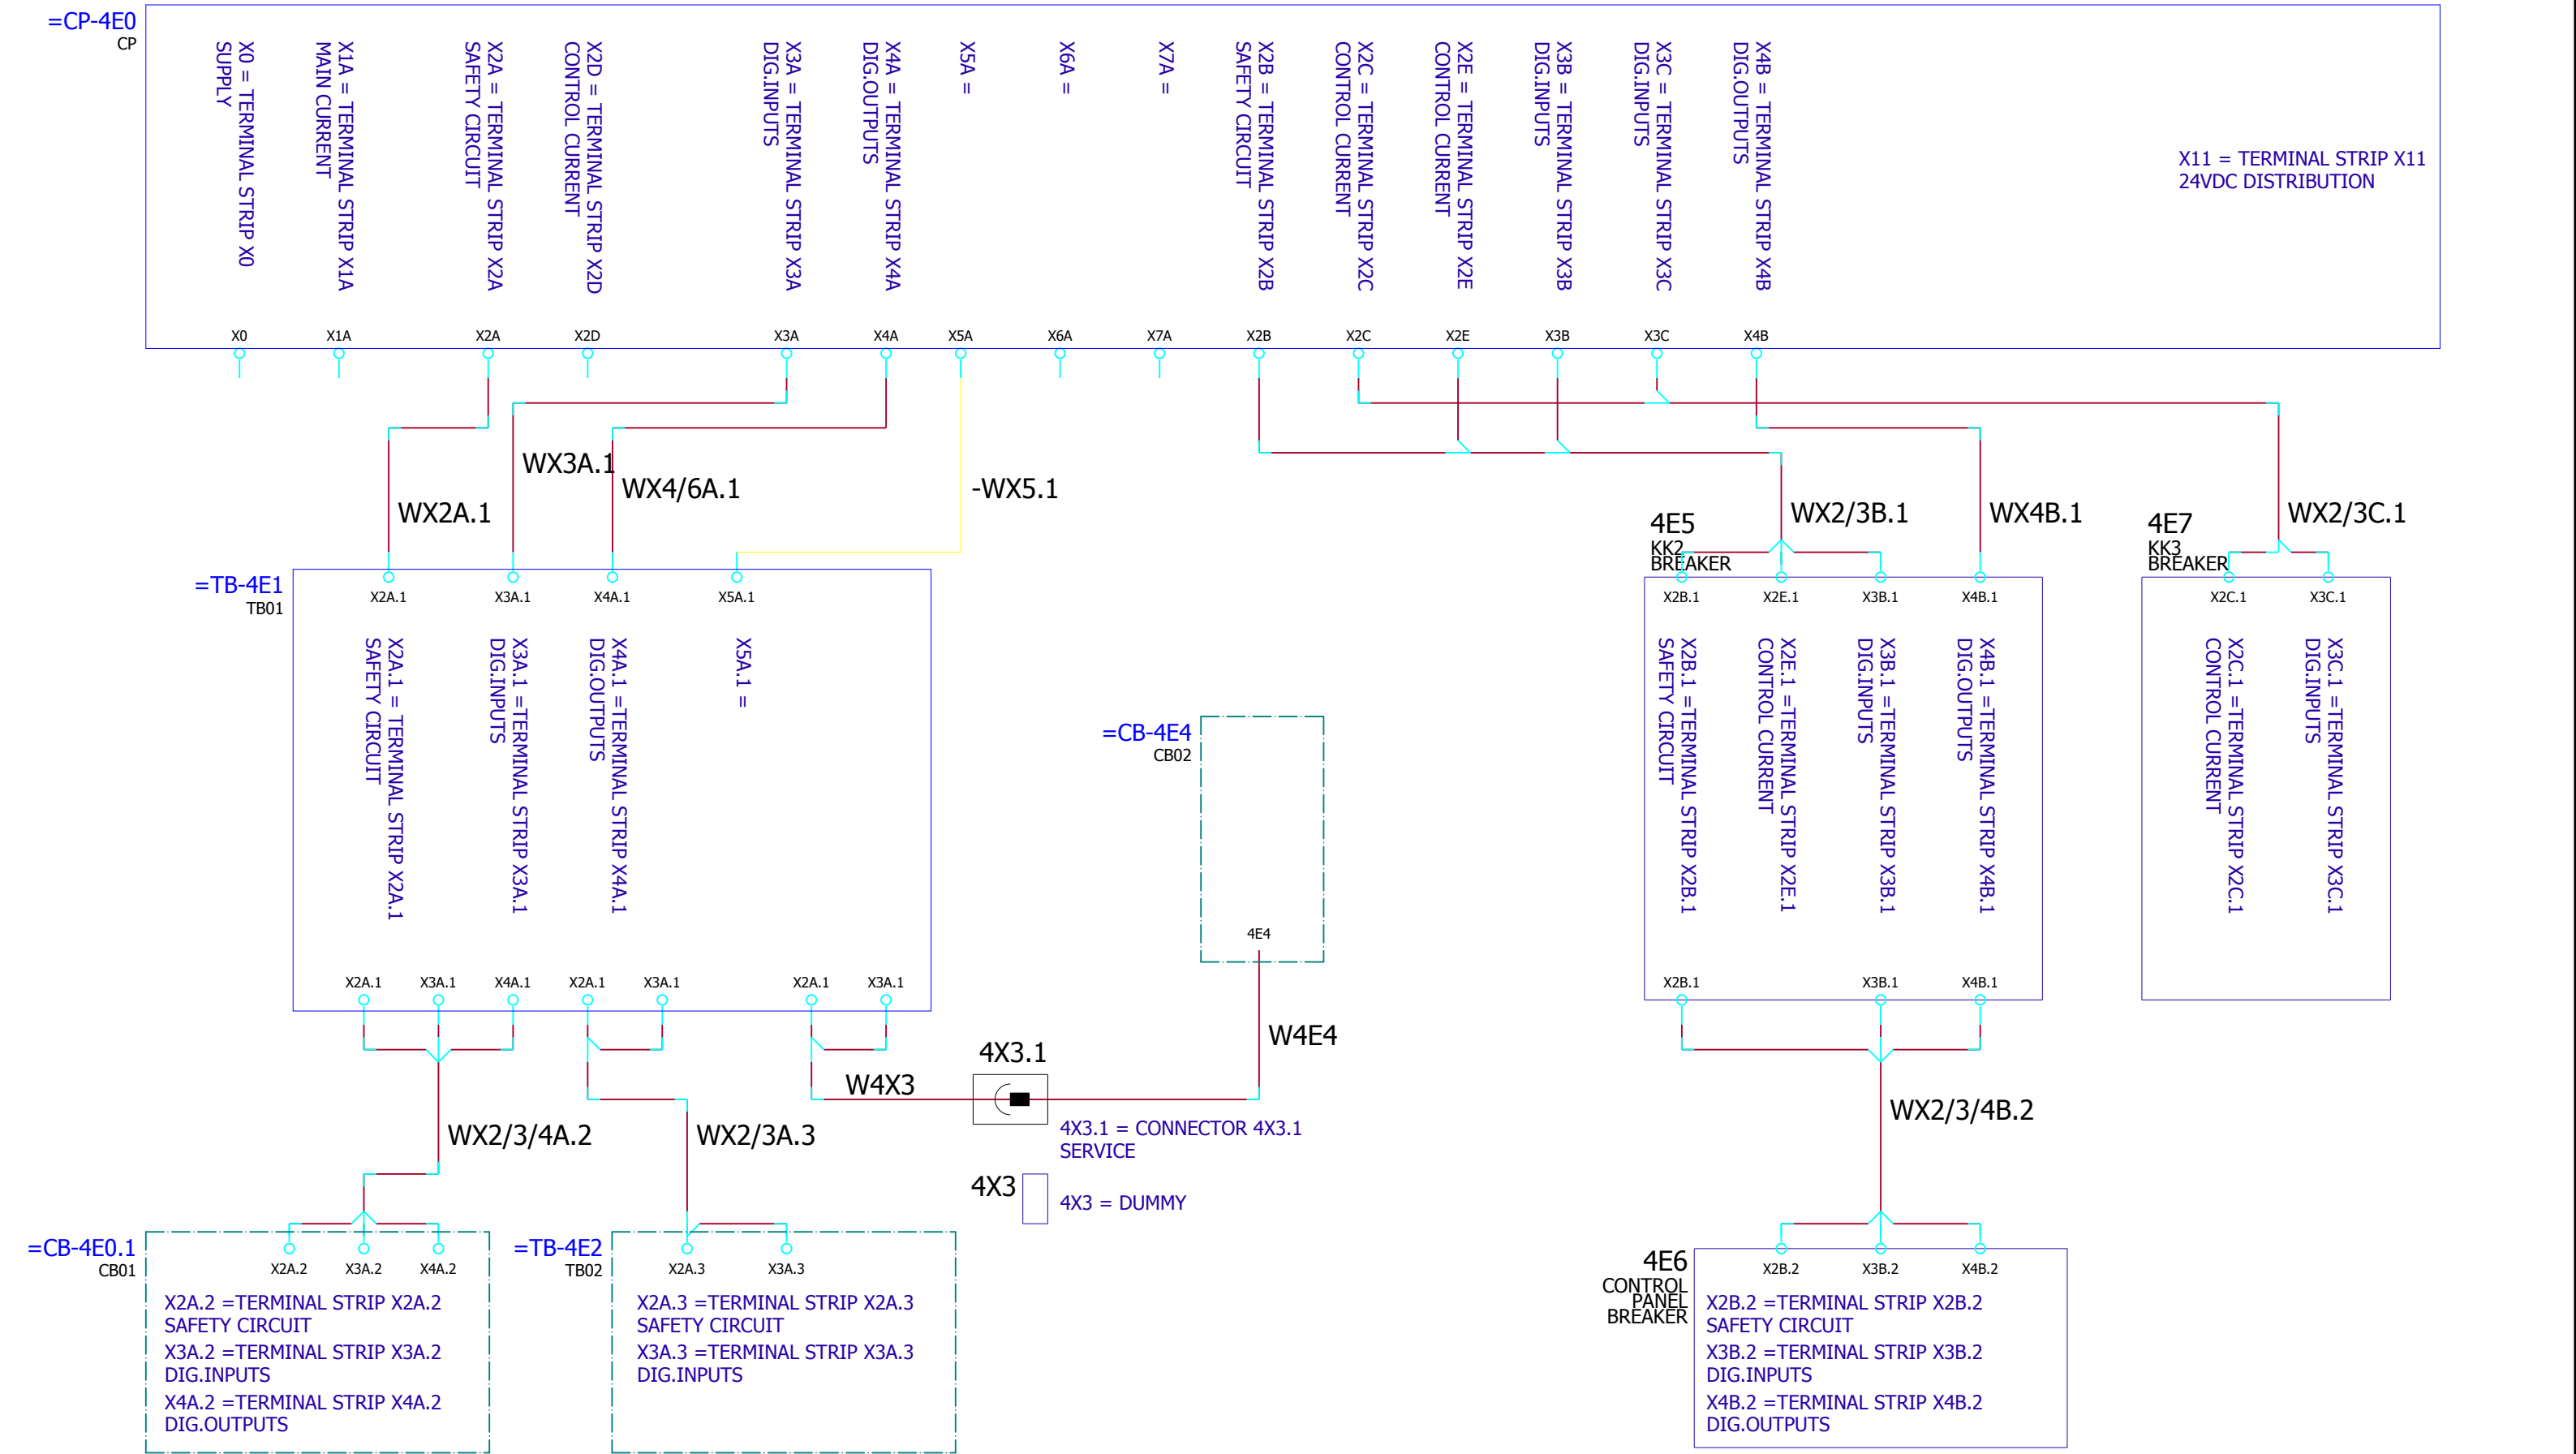


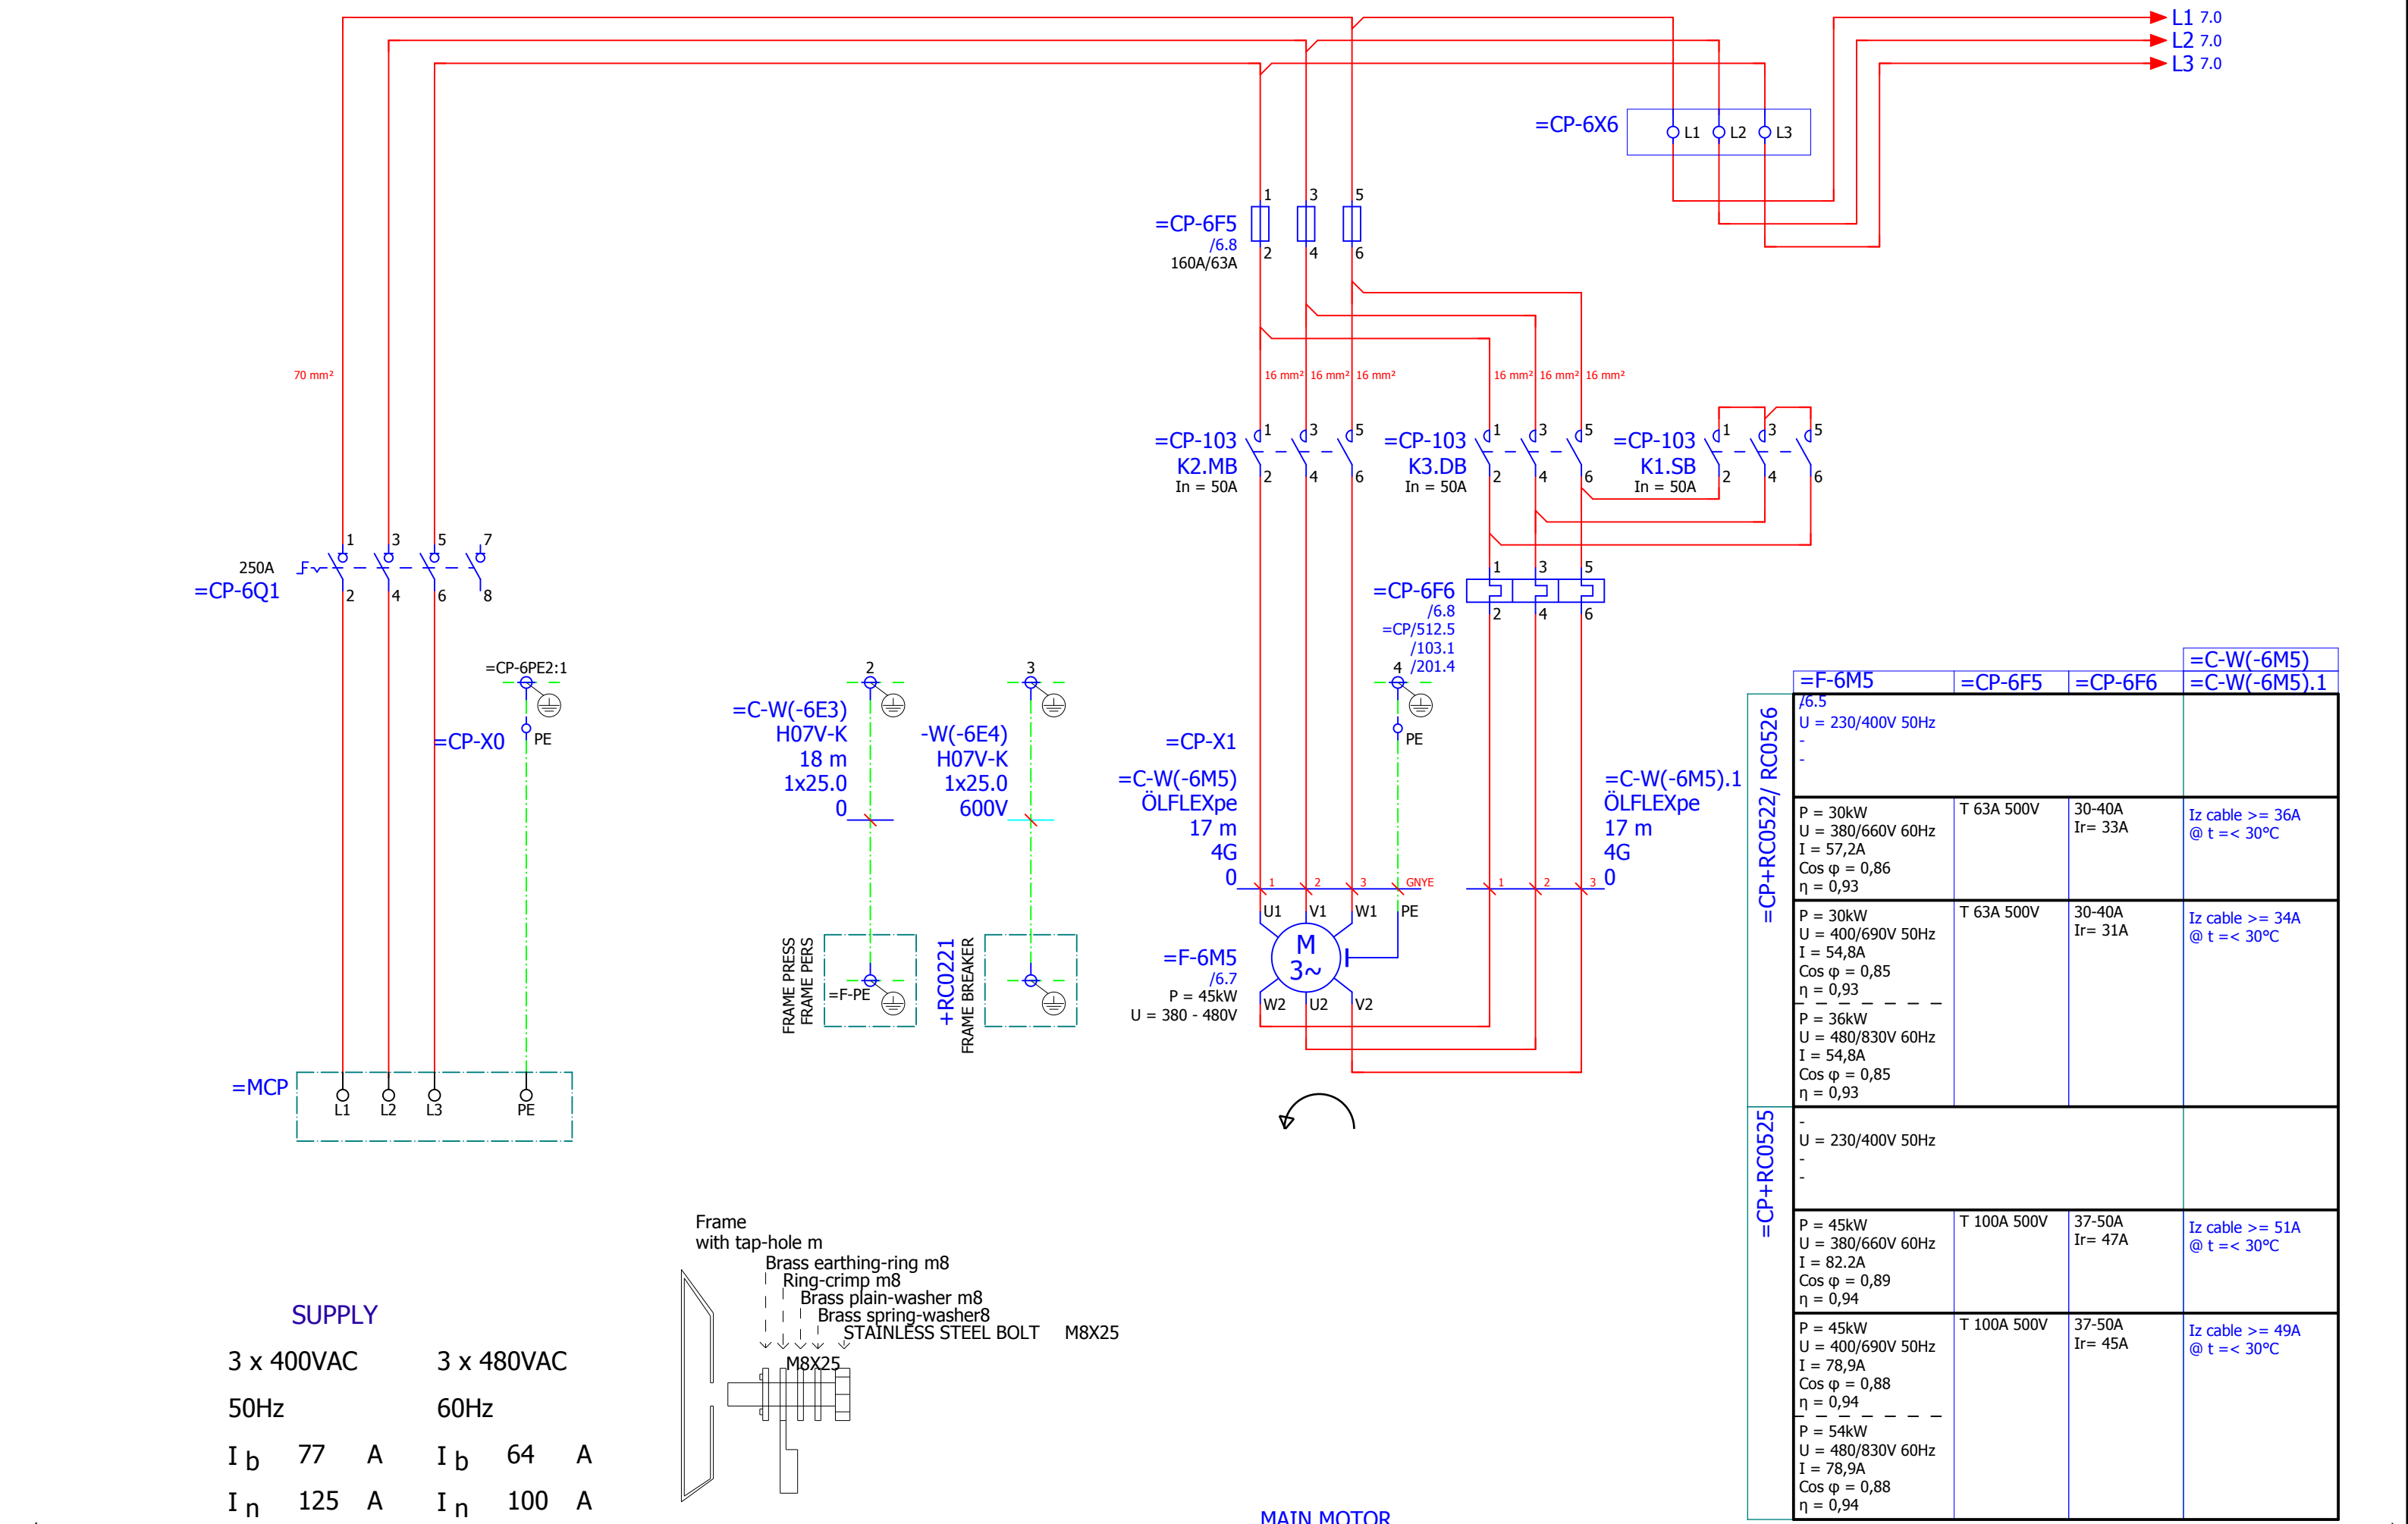

=F-6M5		=CP-6F5	=CP-6F6	=C-W(-6M5)
/6.5				=C-W(-6M5).1
U = 230/400V 50Hz				
P = 30kW		T 63A 500V	30-40A	Iz cable >= 36A
U = 380/660V 60Hz			Ir= 33A	@ t <= 30°C
I = 57,2A				
Cos φ = 0,86				
η = 0,93				
P = 30kW		T 63A 500V	30-40A	Iz cable >= 34A
U = 400/690V 50Hz			Ir= 31A	@ t <= 30°C
I = 54,8A				
Cos φ = 0,85				
η = 0,93				
P = 36kW				
U = 480/830V 60Hz				
I = 54,8A				
Cos φ = 0,85				
η = 0,93				
U = 230/400V 50Hz				
P = 45kW		T 100A 500V	37-50A	Iz cable >= 51A
U = 380/660V 60Hz			Ir= 47A	@ t <= 30°C
I = 82,2A				
Cos φ = 0,89				
η = 0,94				
P = 45kW		T 100A 500V	37-50A	Iz cable >= 49A
U = 400/690V 50Hz			Ir= 45A	@ t <= 30°C
I = 78,9A				
Cos φ = 0,88				
η = 0,94				
P = 54kW				
U = 480/830V 60Hz				
I = 78,9A				
Cos φ = 0,88				
η = 0,94				

previous:
5.A

next:
7

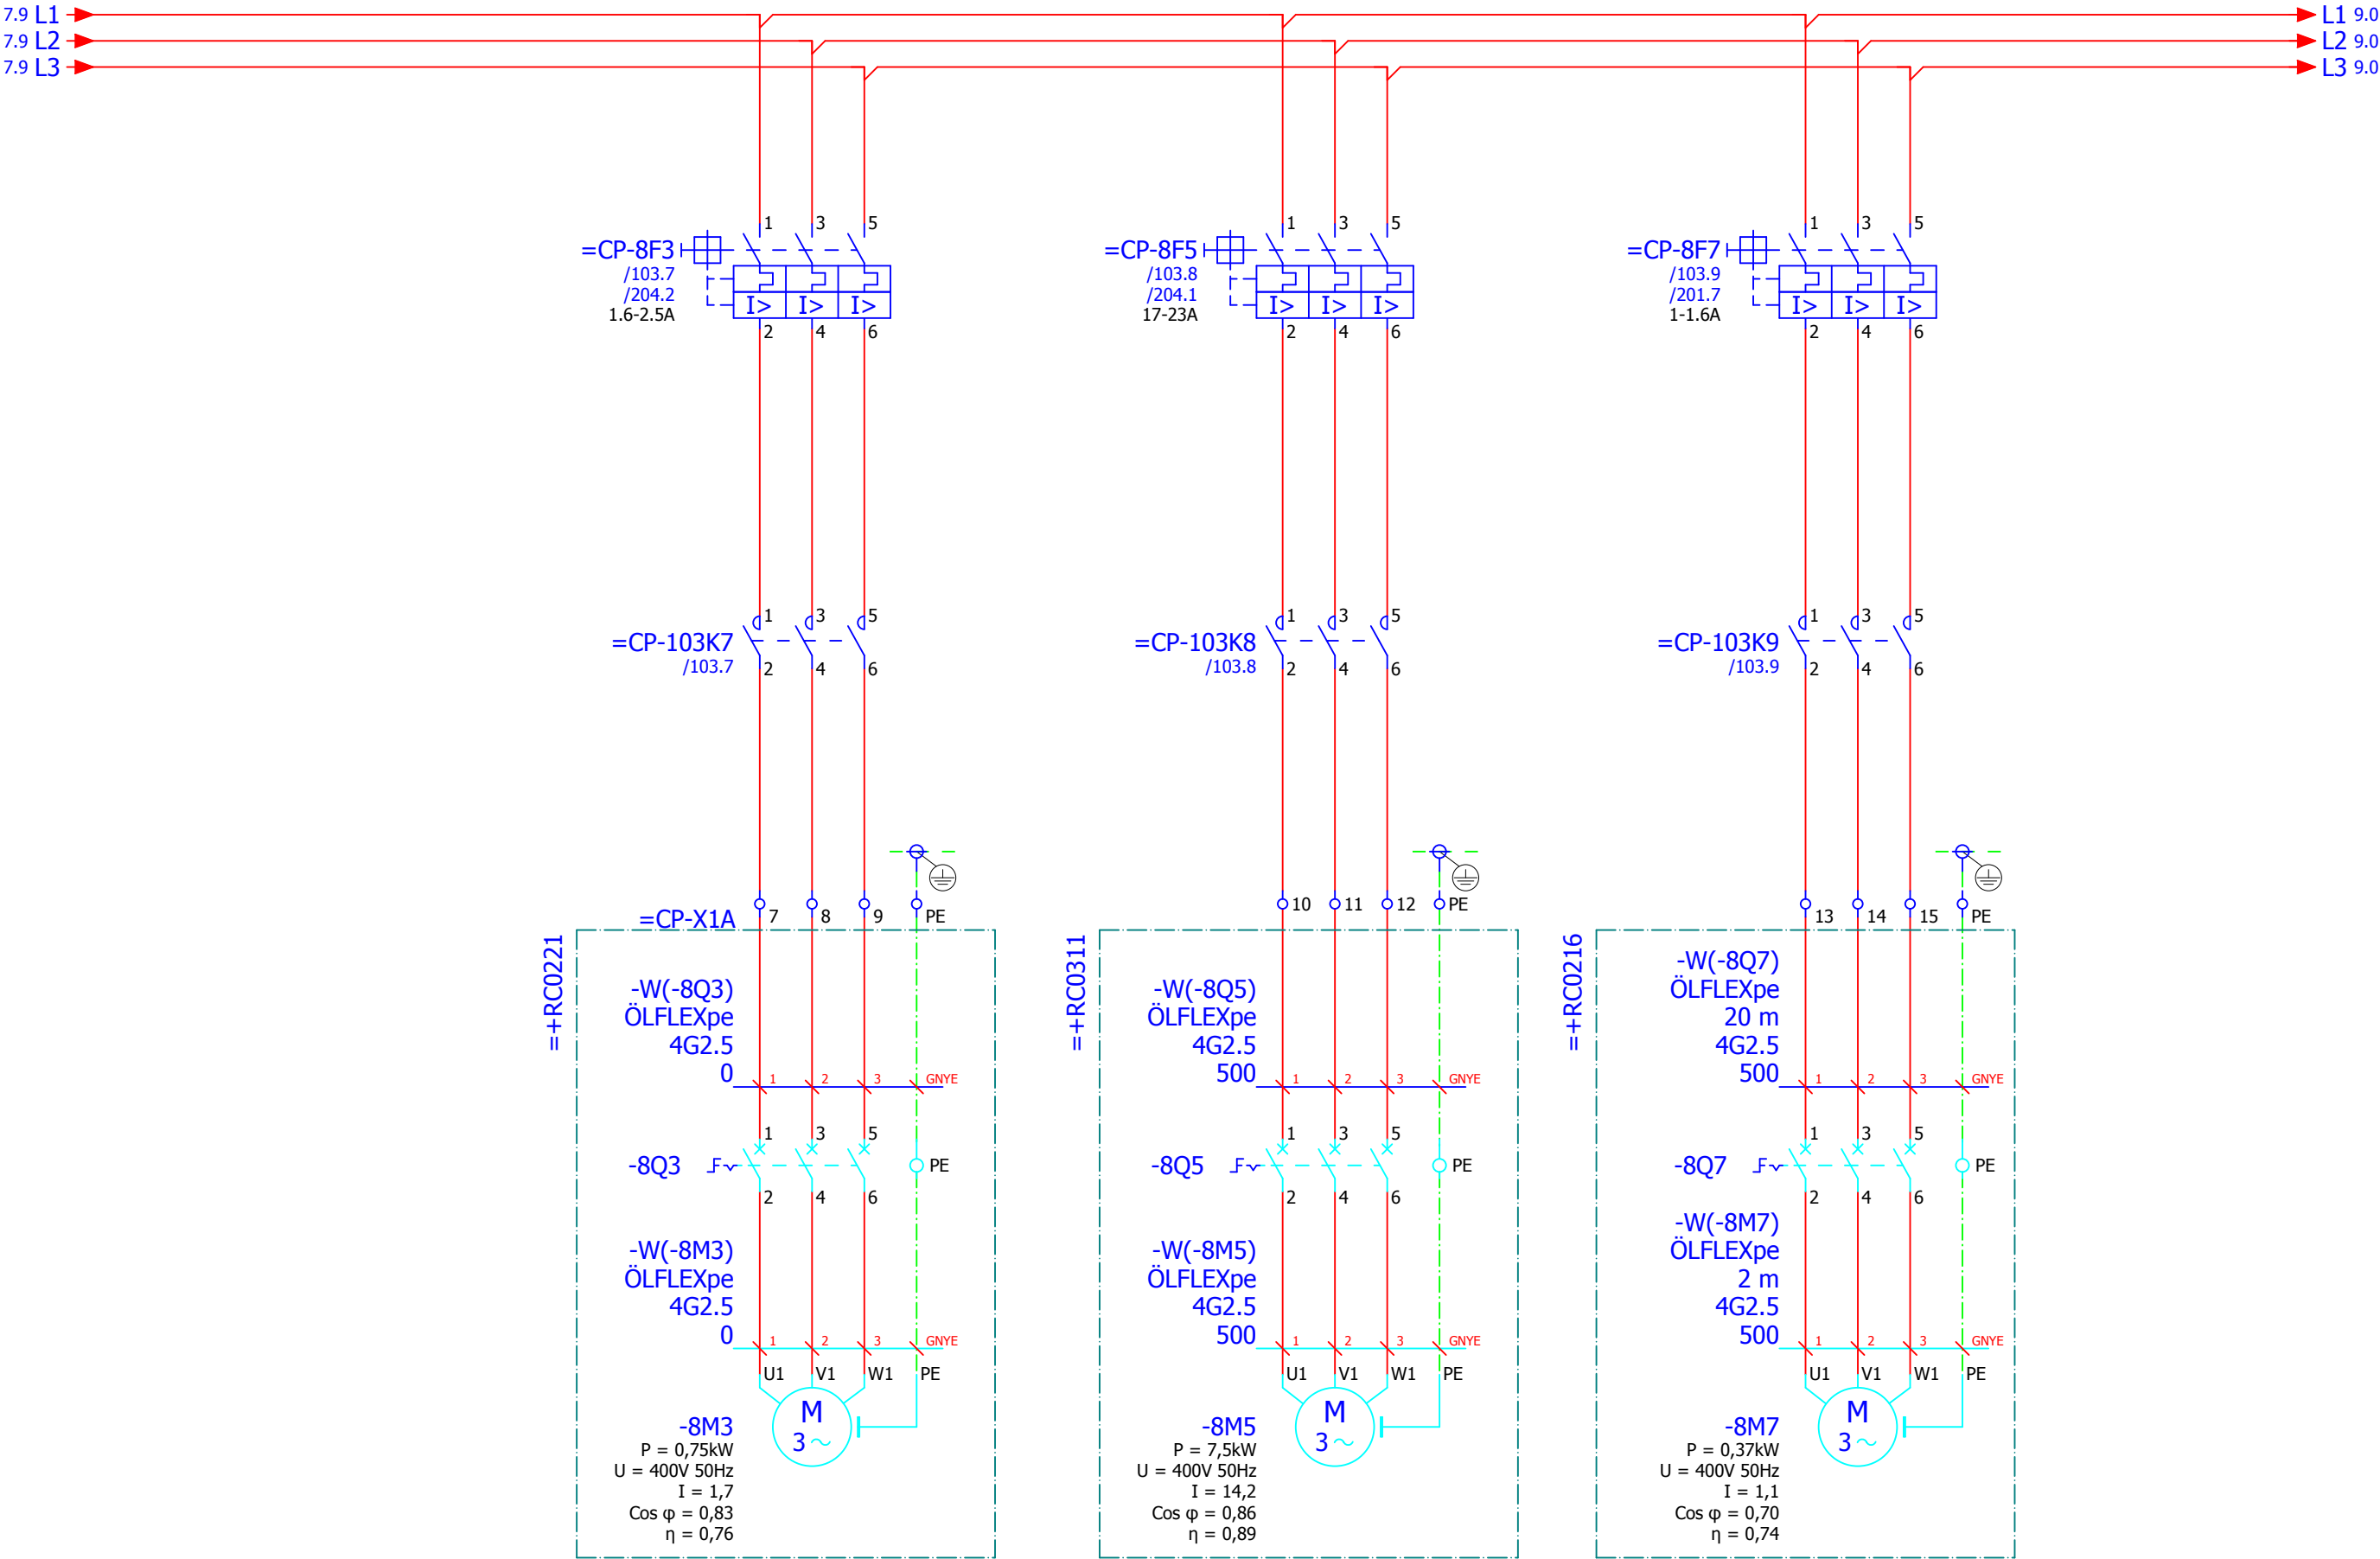


CONVEYOR B40
INFEED BREAKER
OPTIONAL

HYDRO UNIT
BREAKER

CONVEYOR B37
INFEED PRESS
OPTIONAL


previous:
7

next:
9

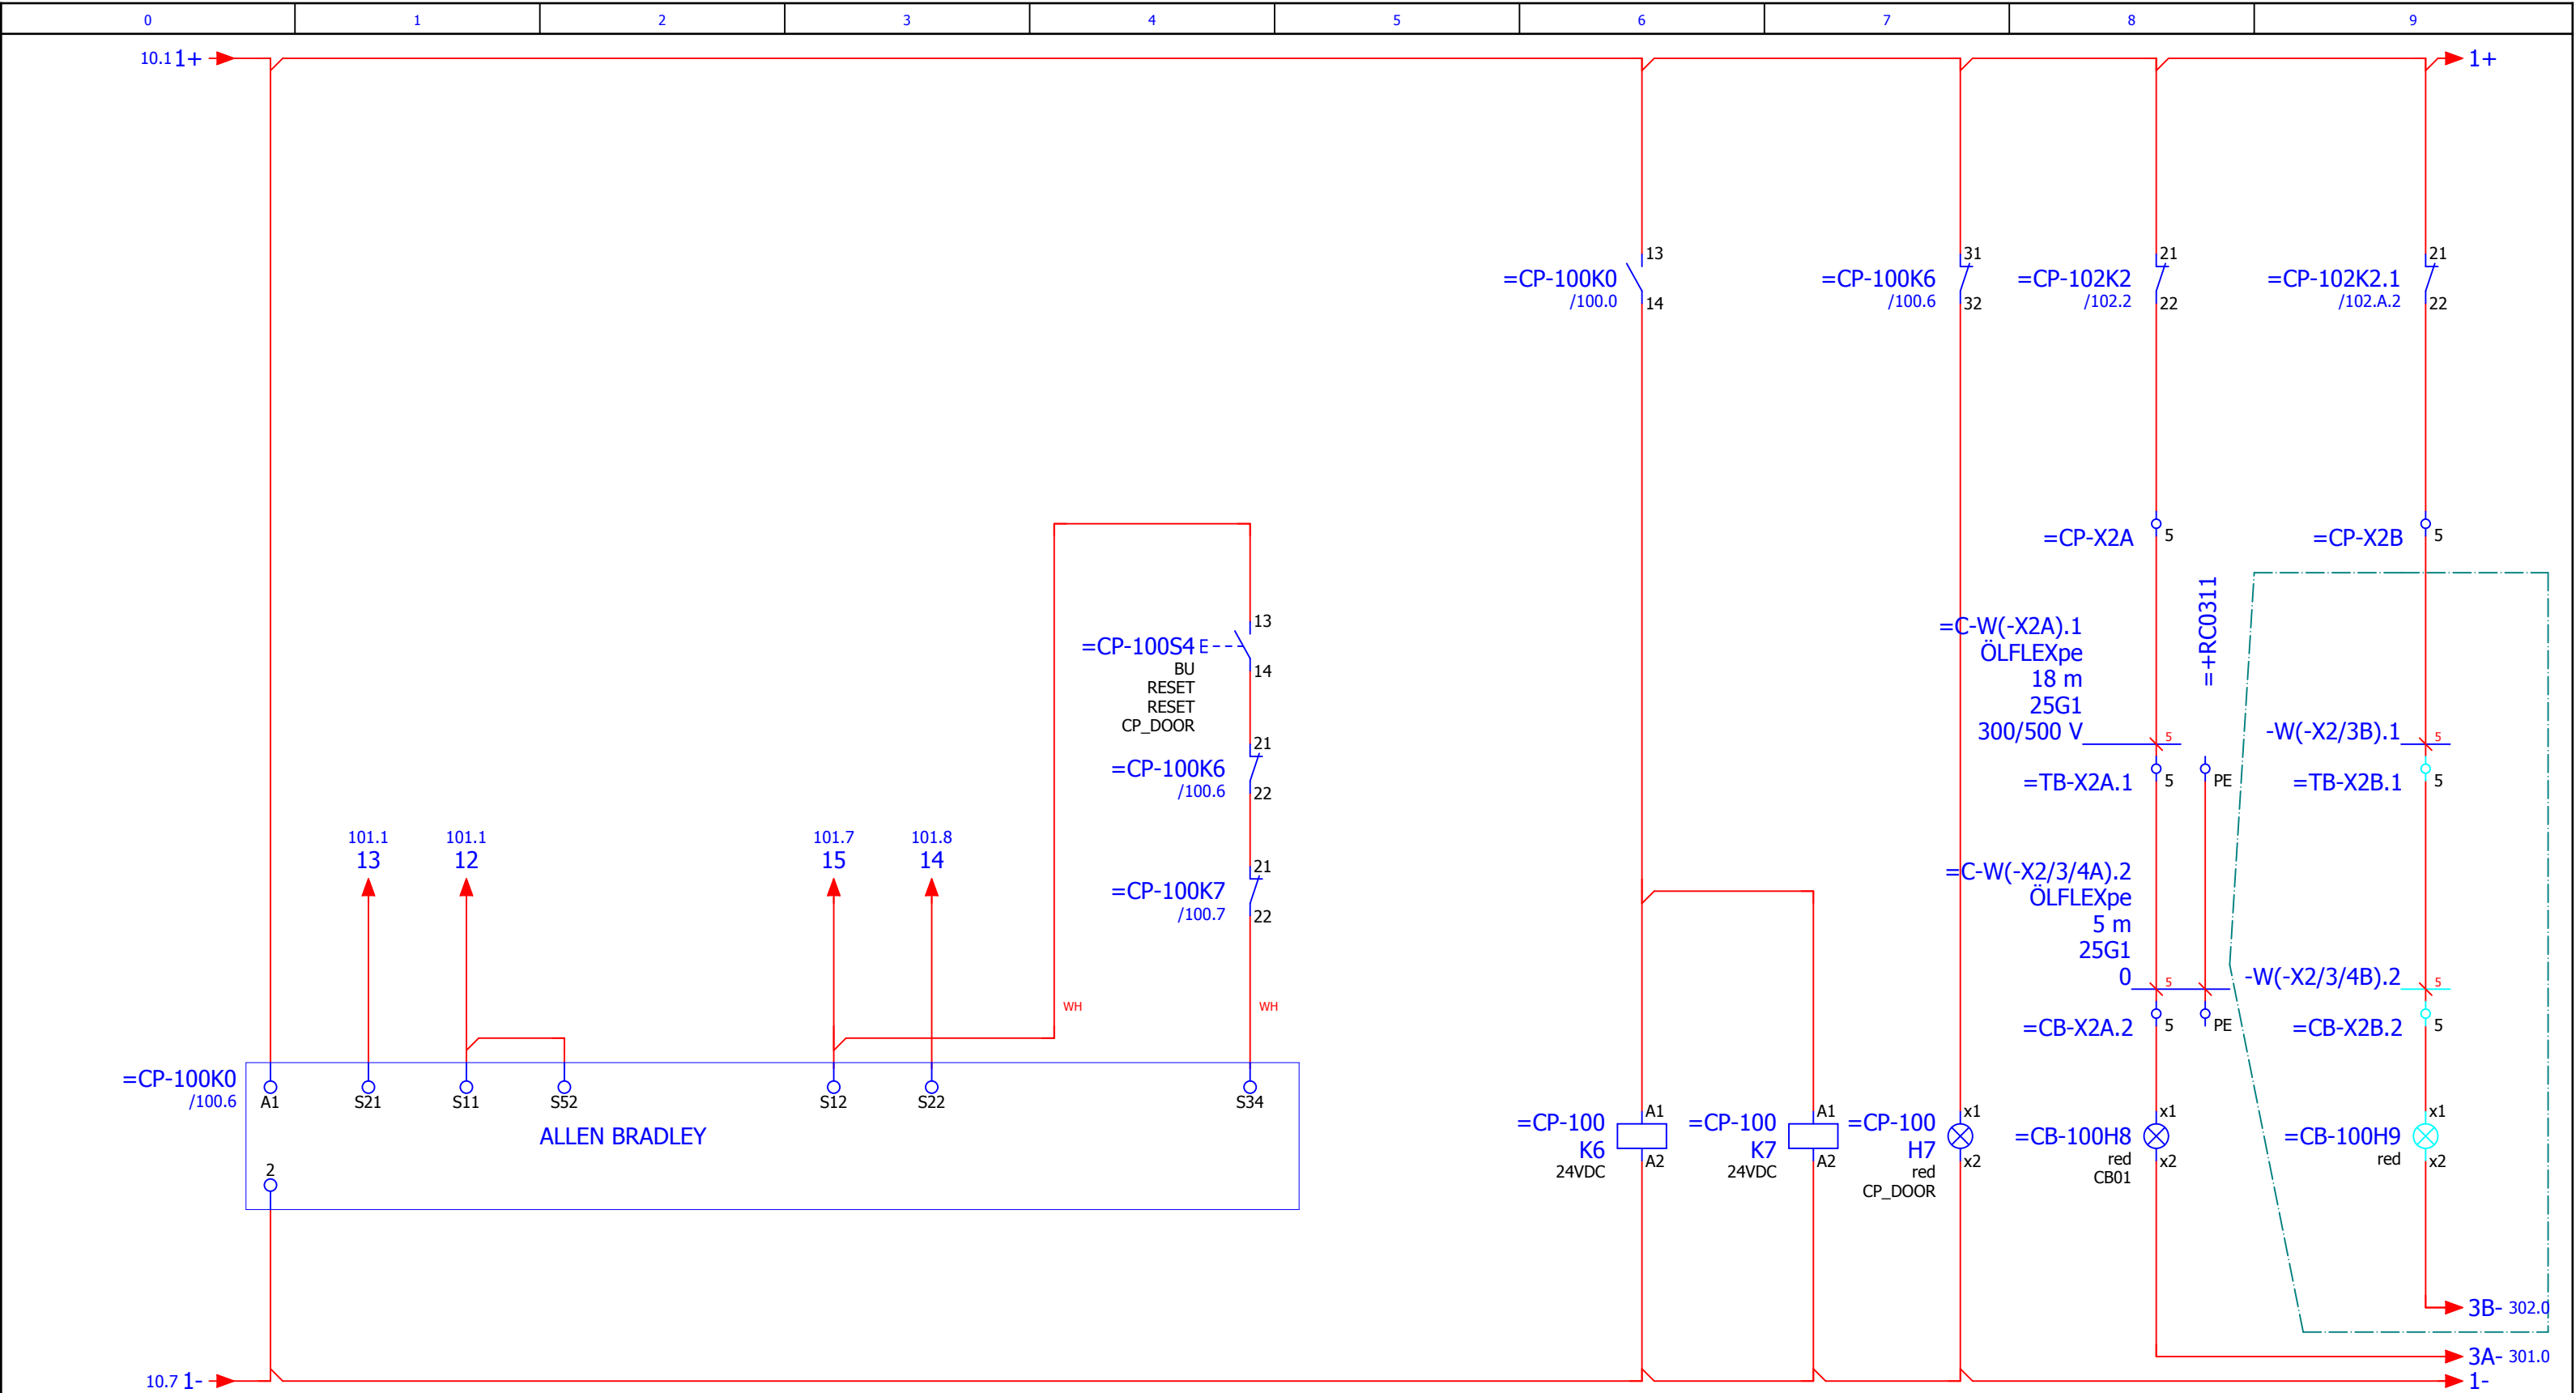


13 - 14 /10.2
21 - 22 /100.4
31 - 32 /100.7
43 - 44 /10.3
03 - 04 /201.1


13 - 14 /10.2
21 - 22 /100.4
31 - 32
43 - 44 /10.3
03 - 04


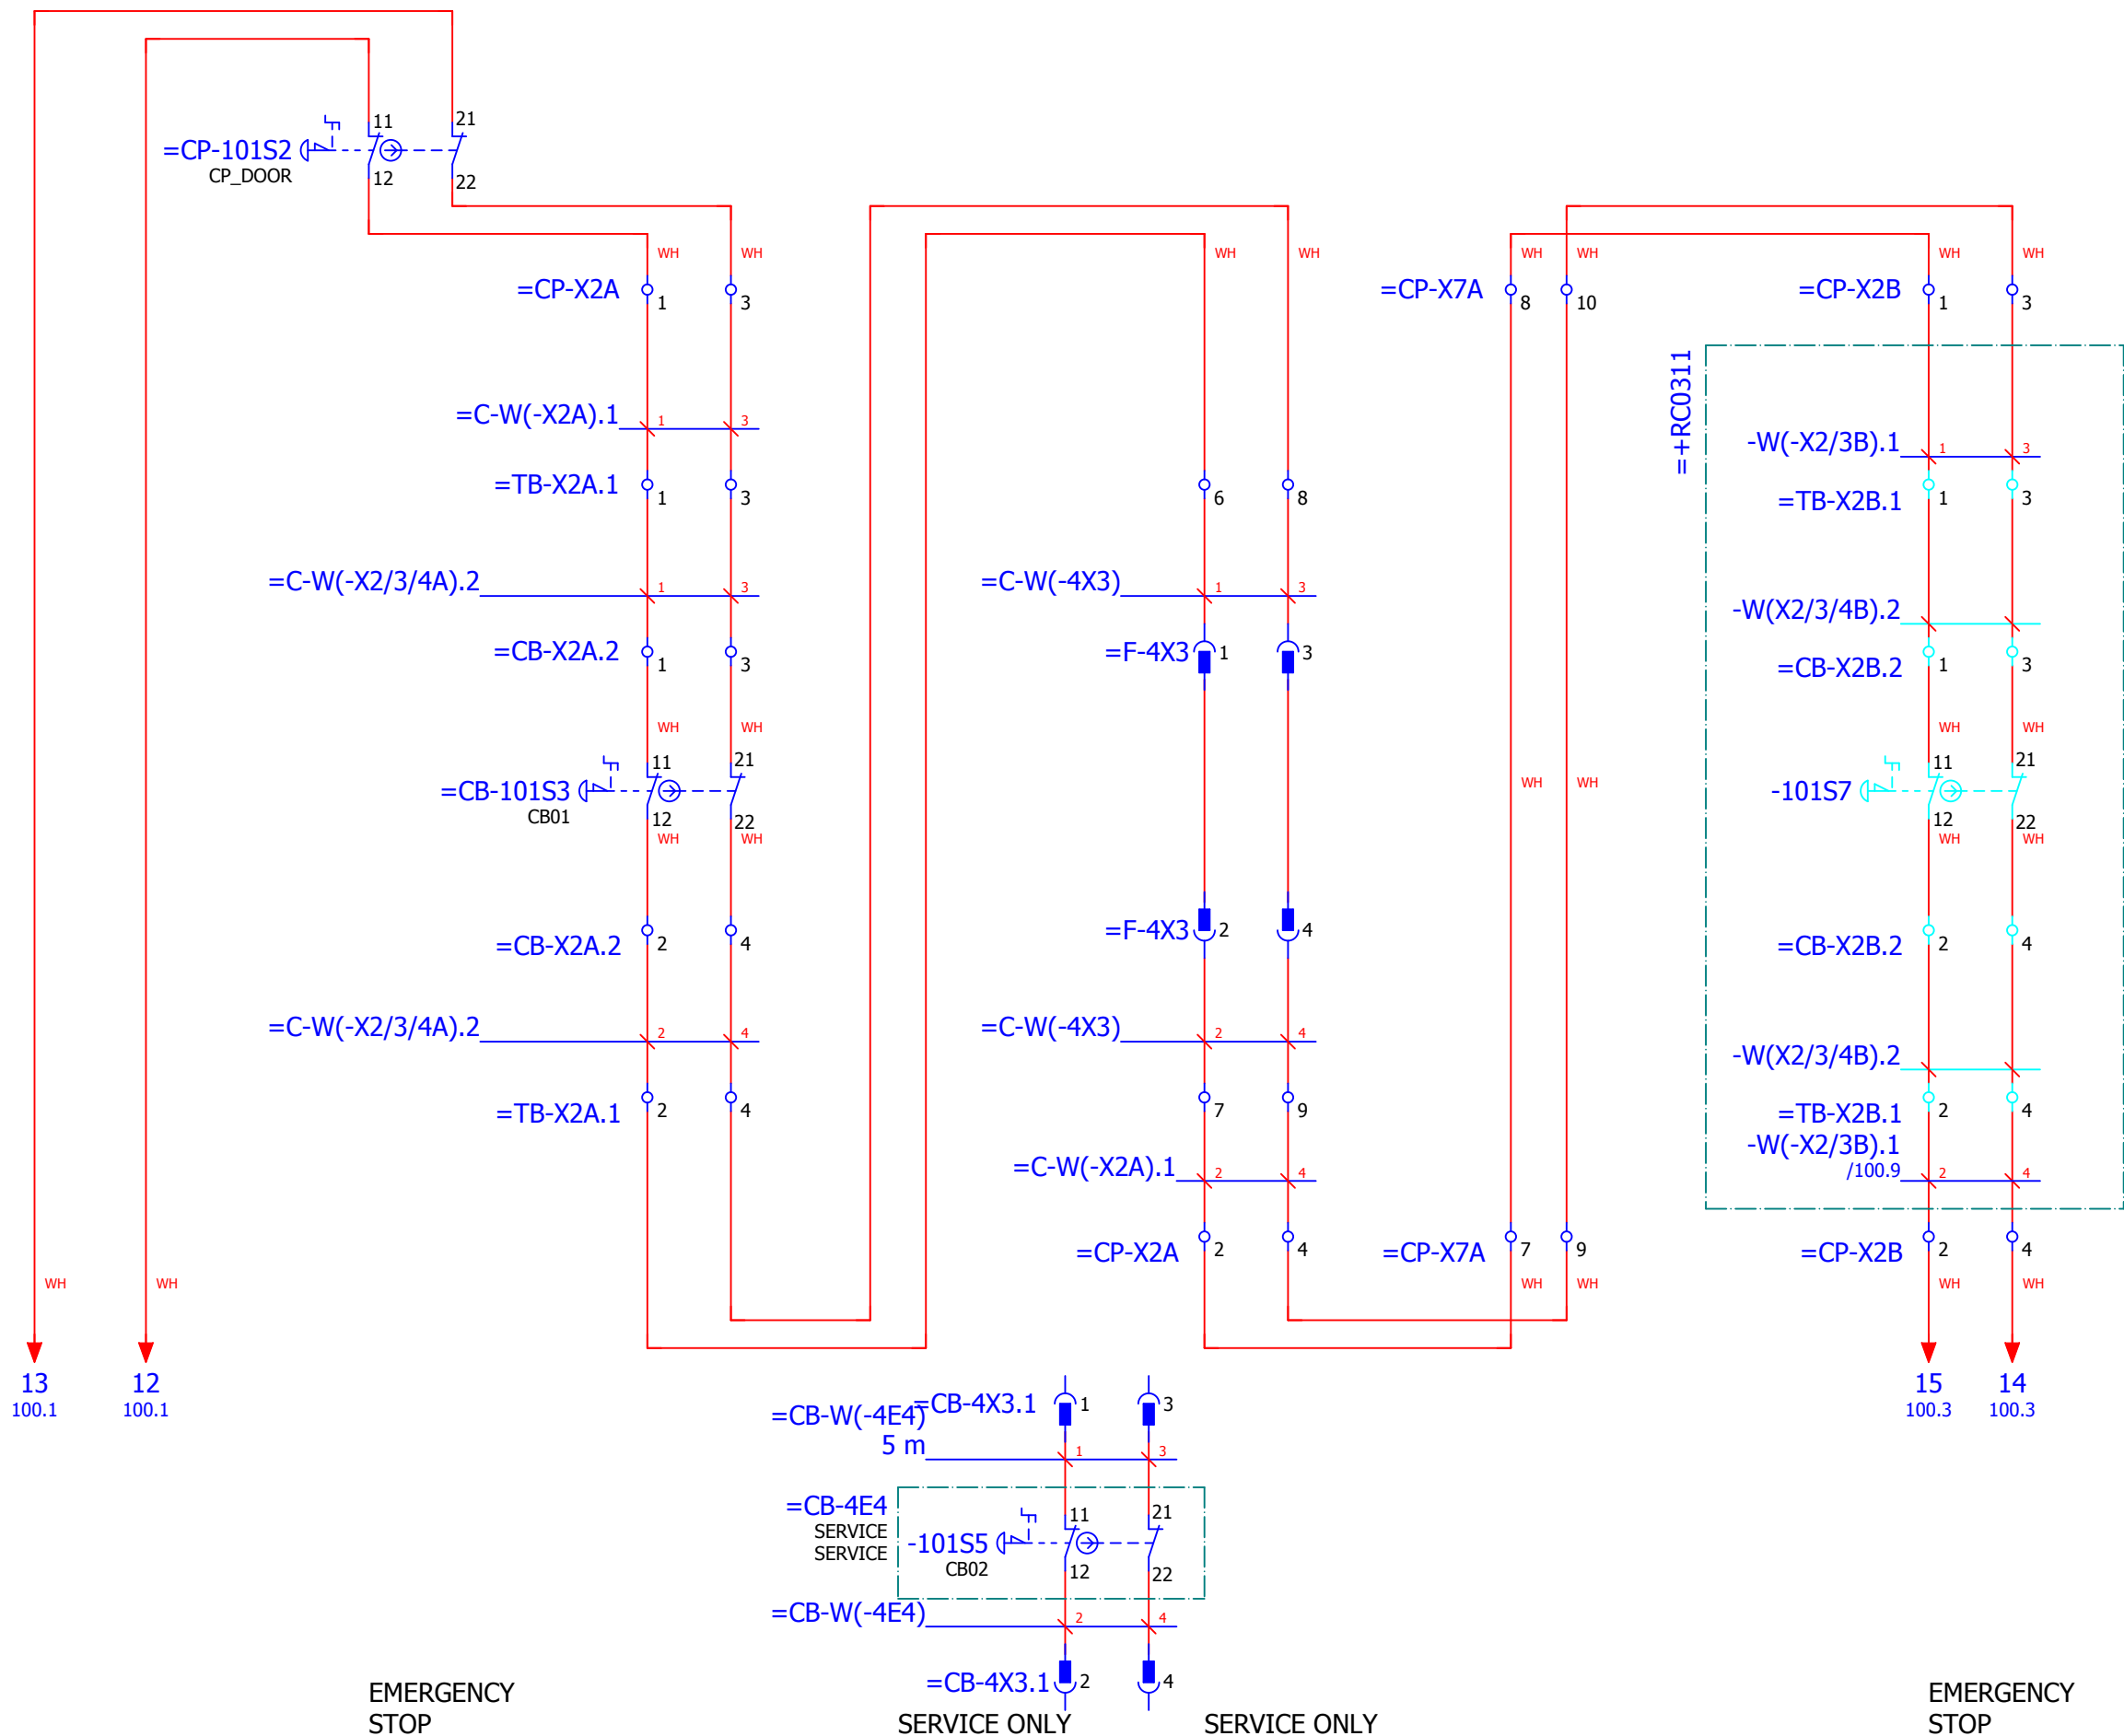


previous:
100

next:
102

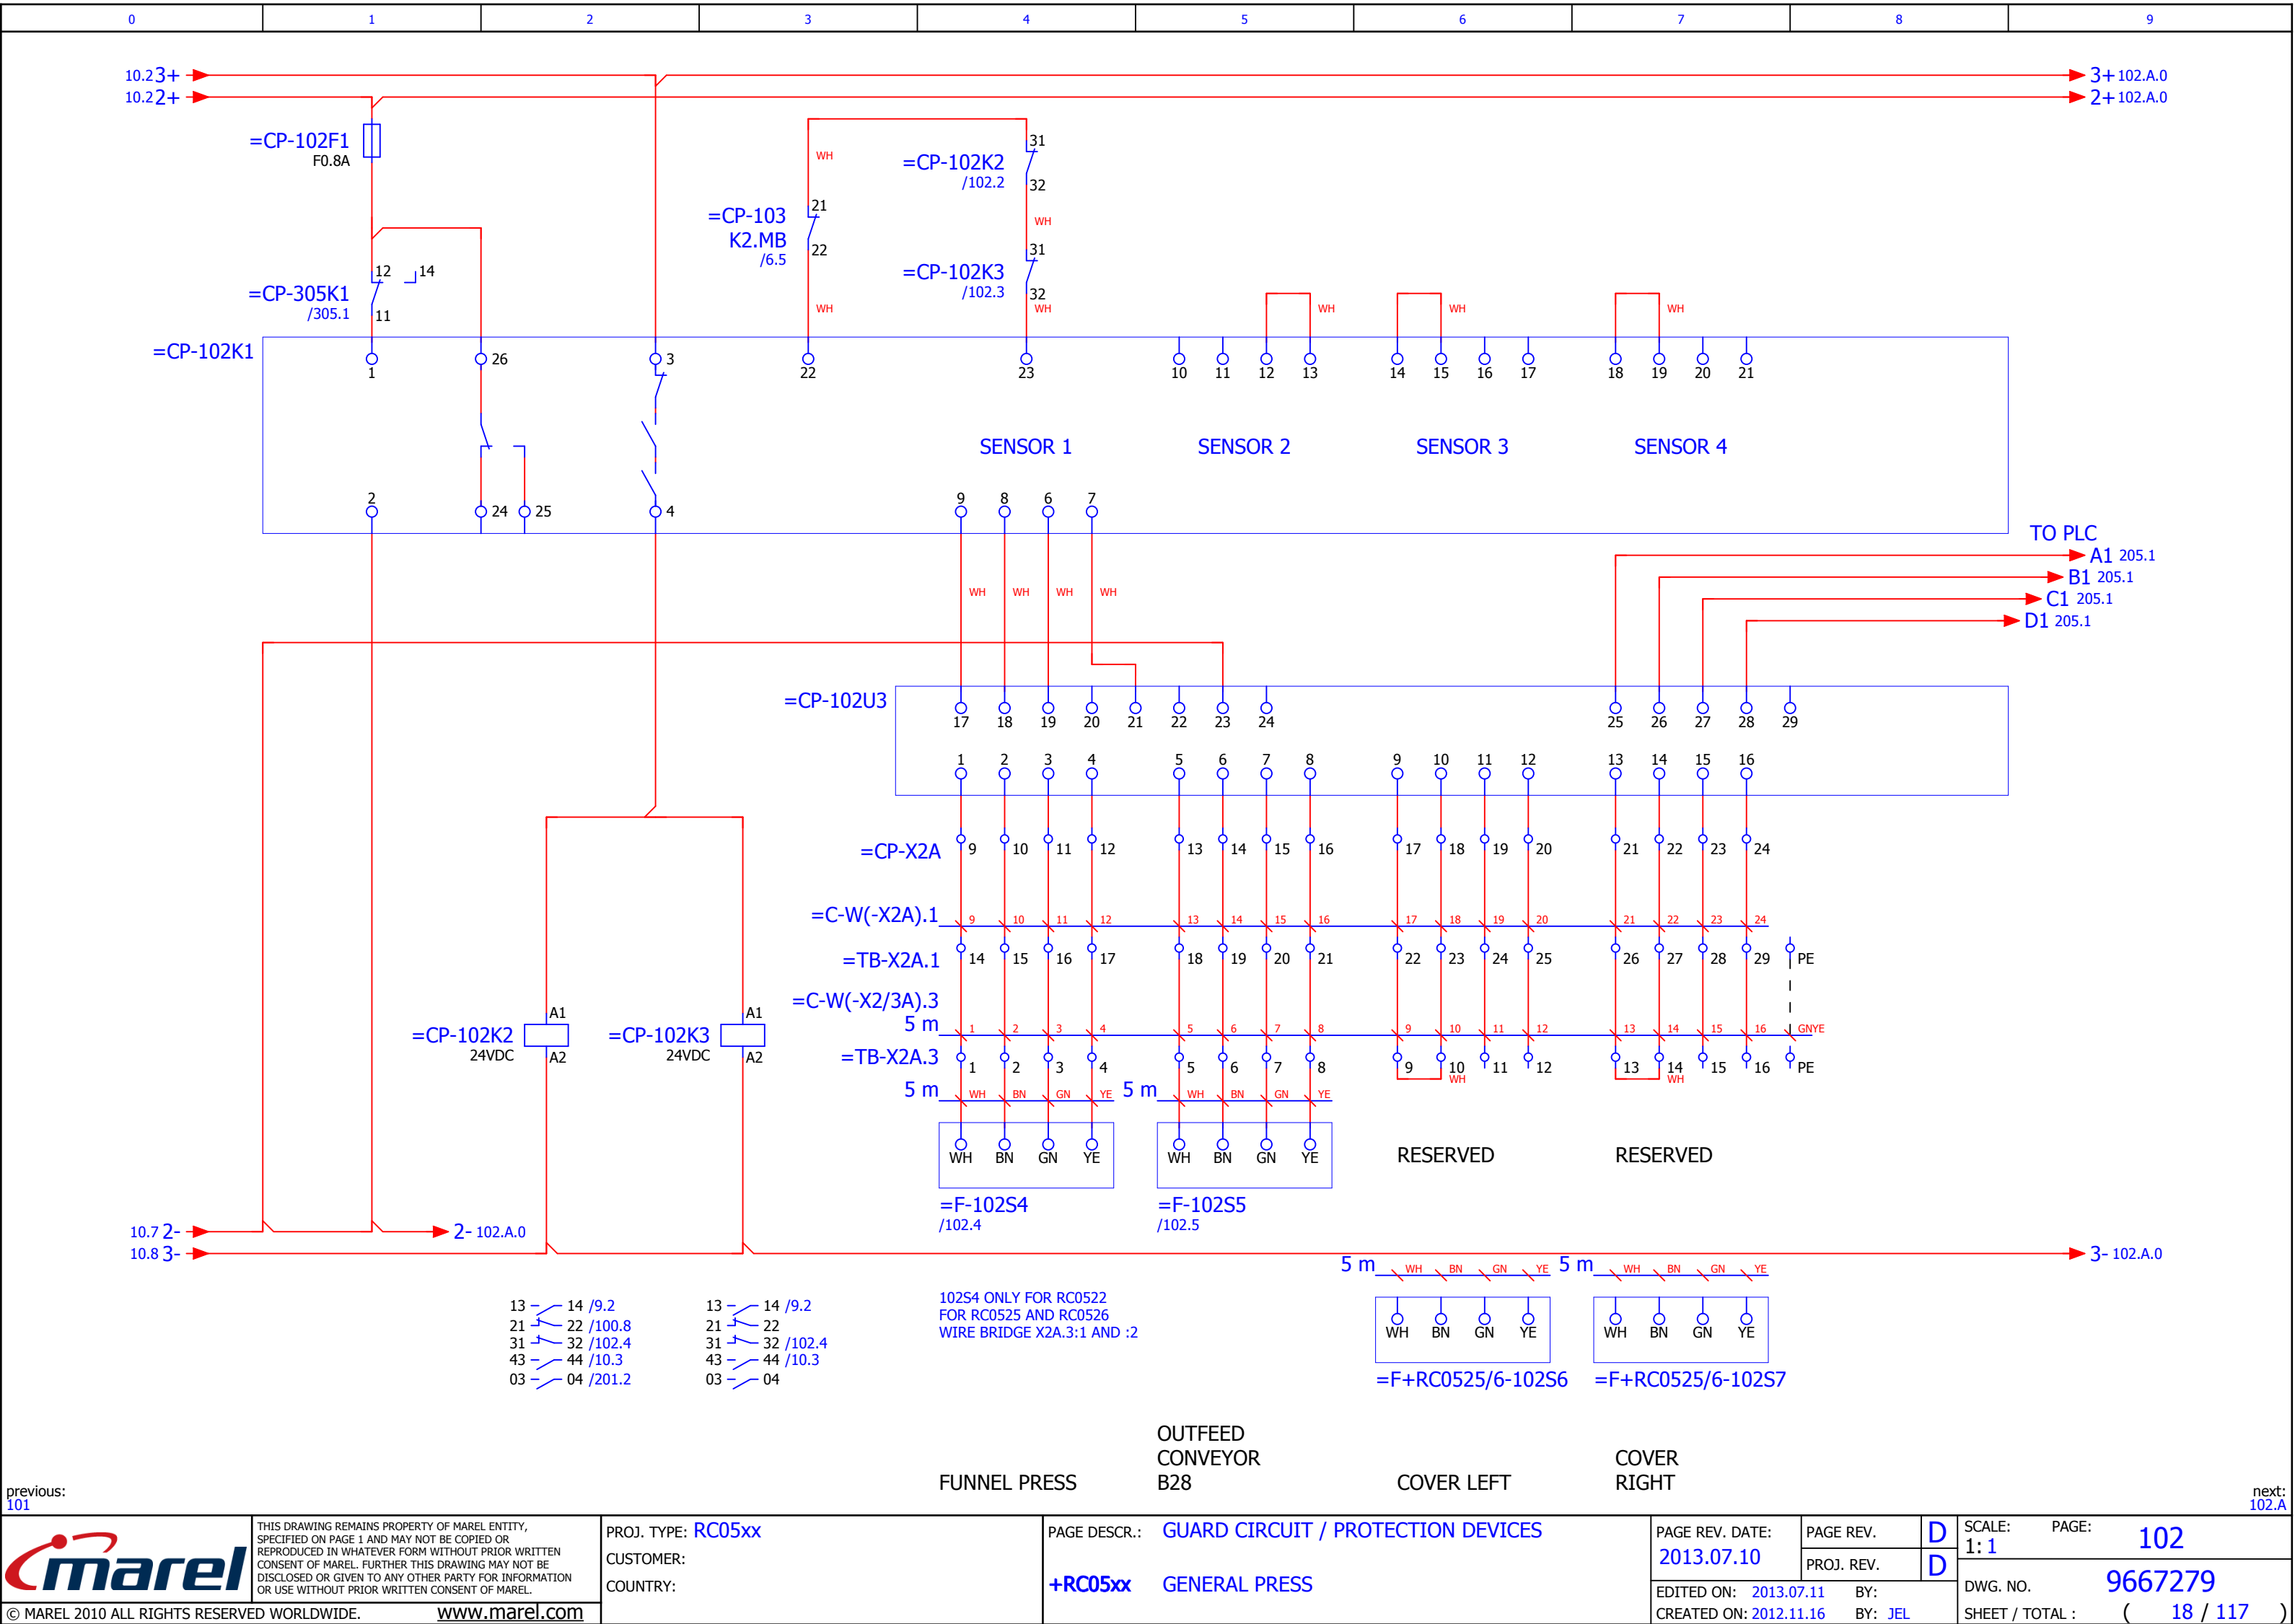

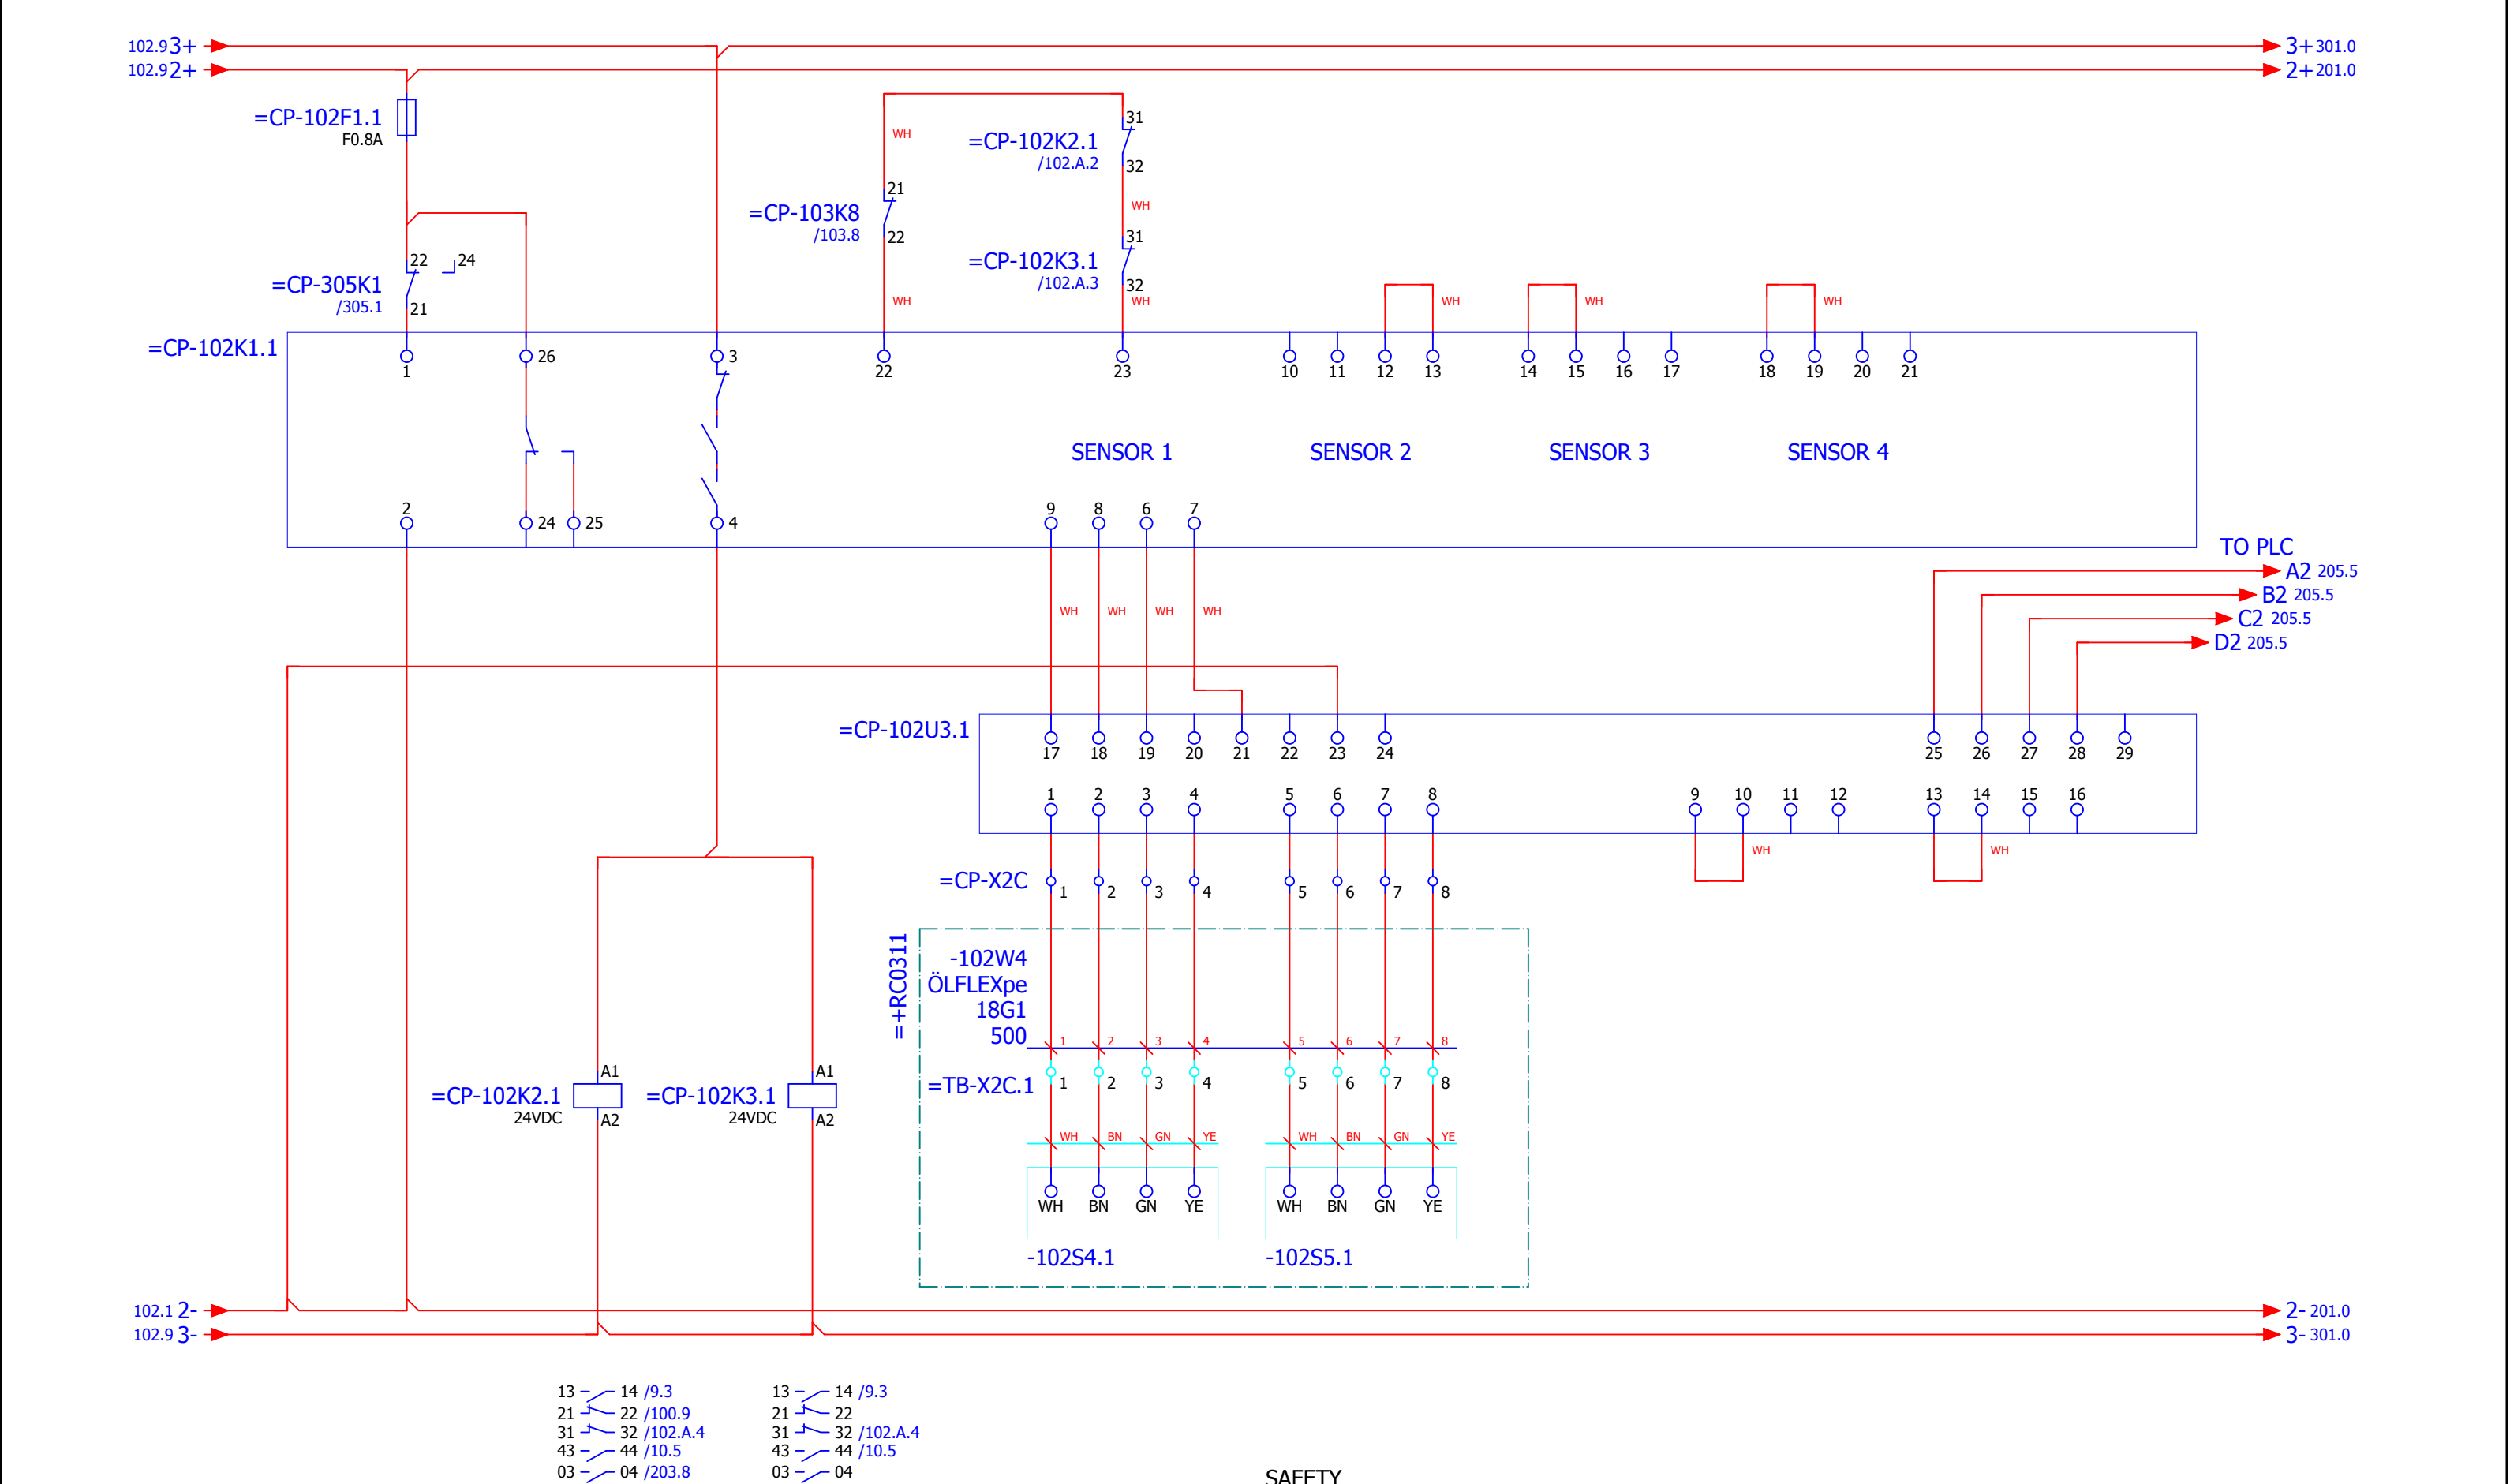

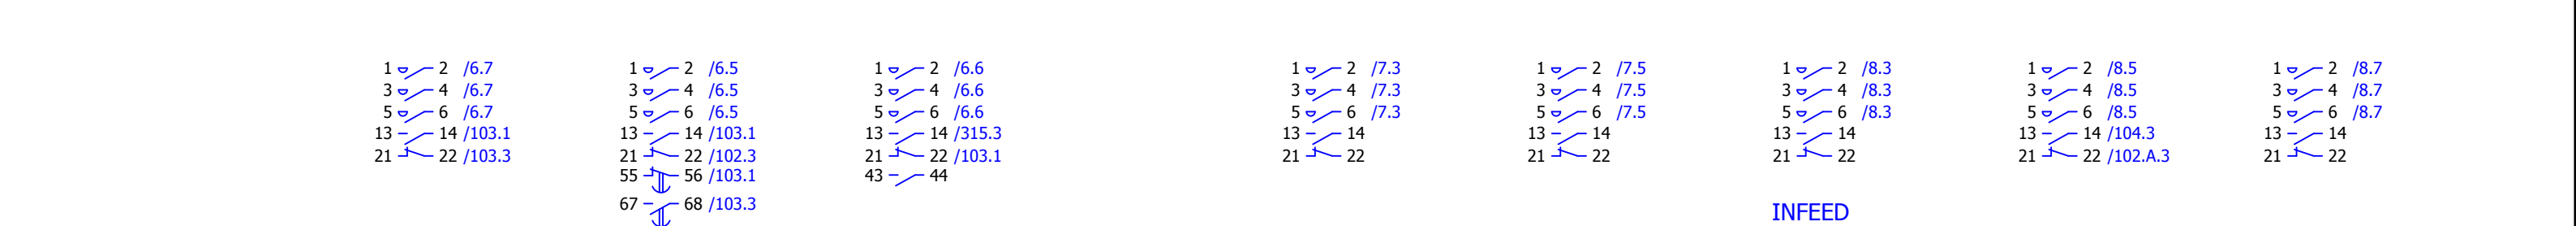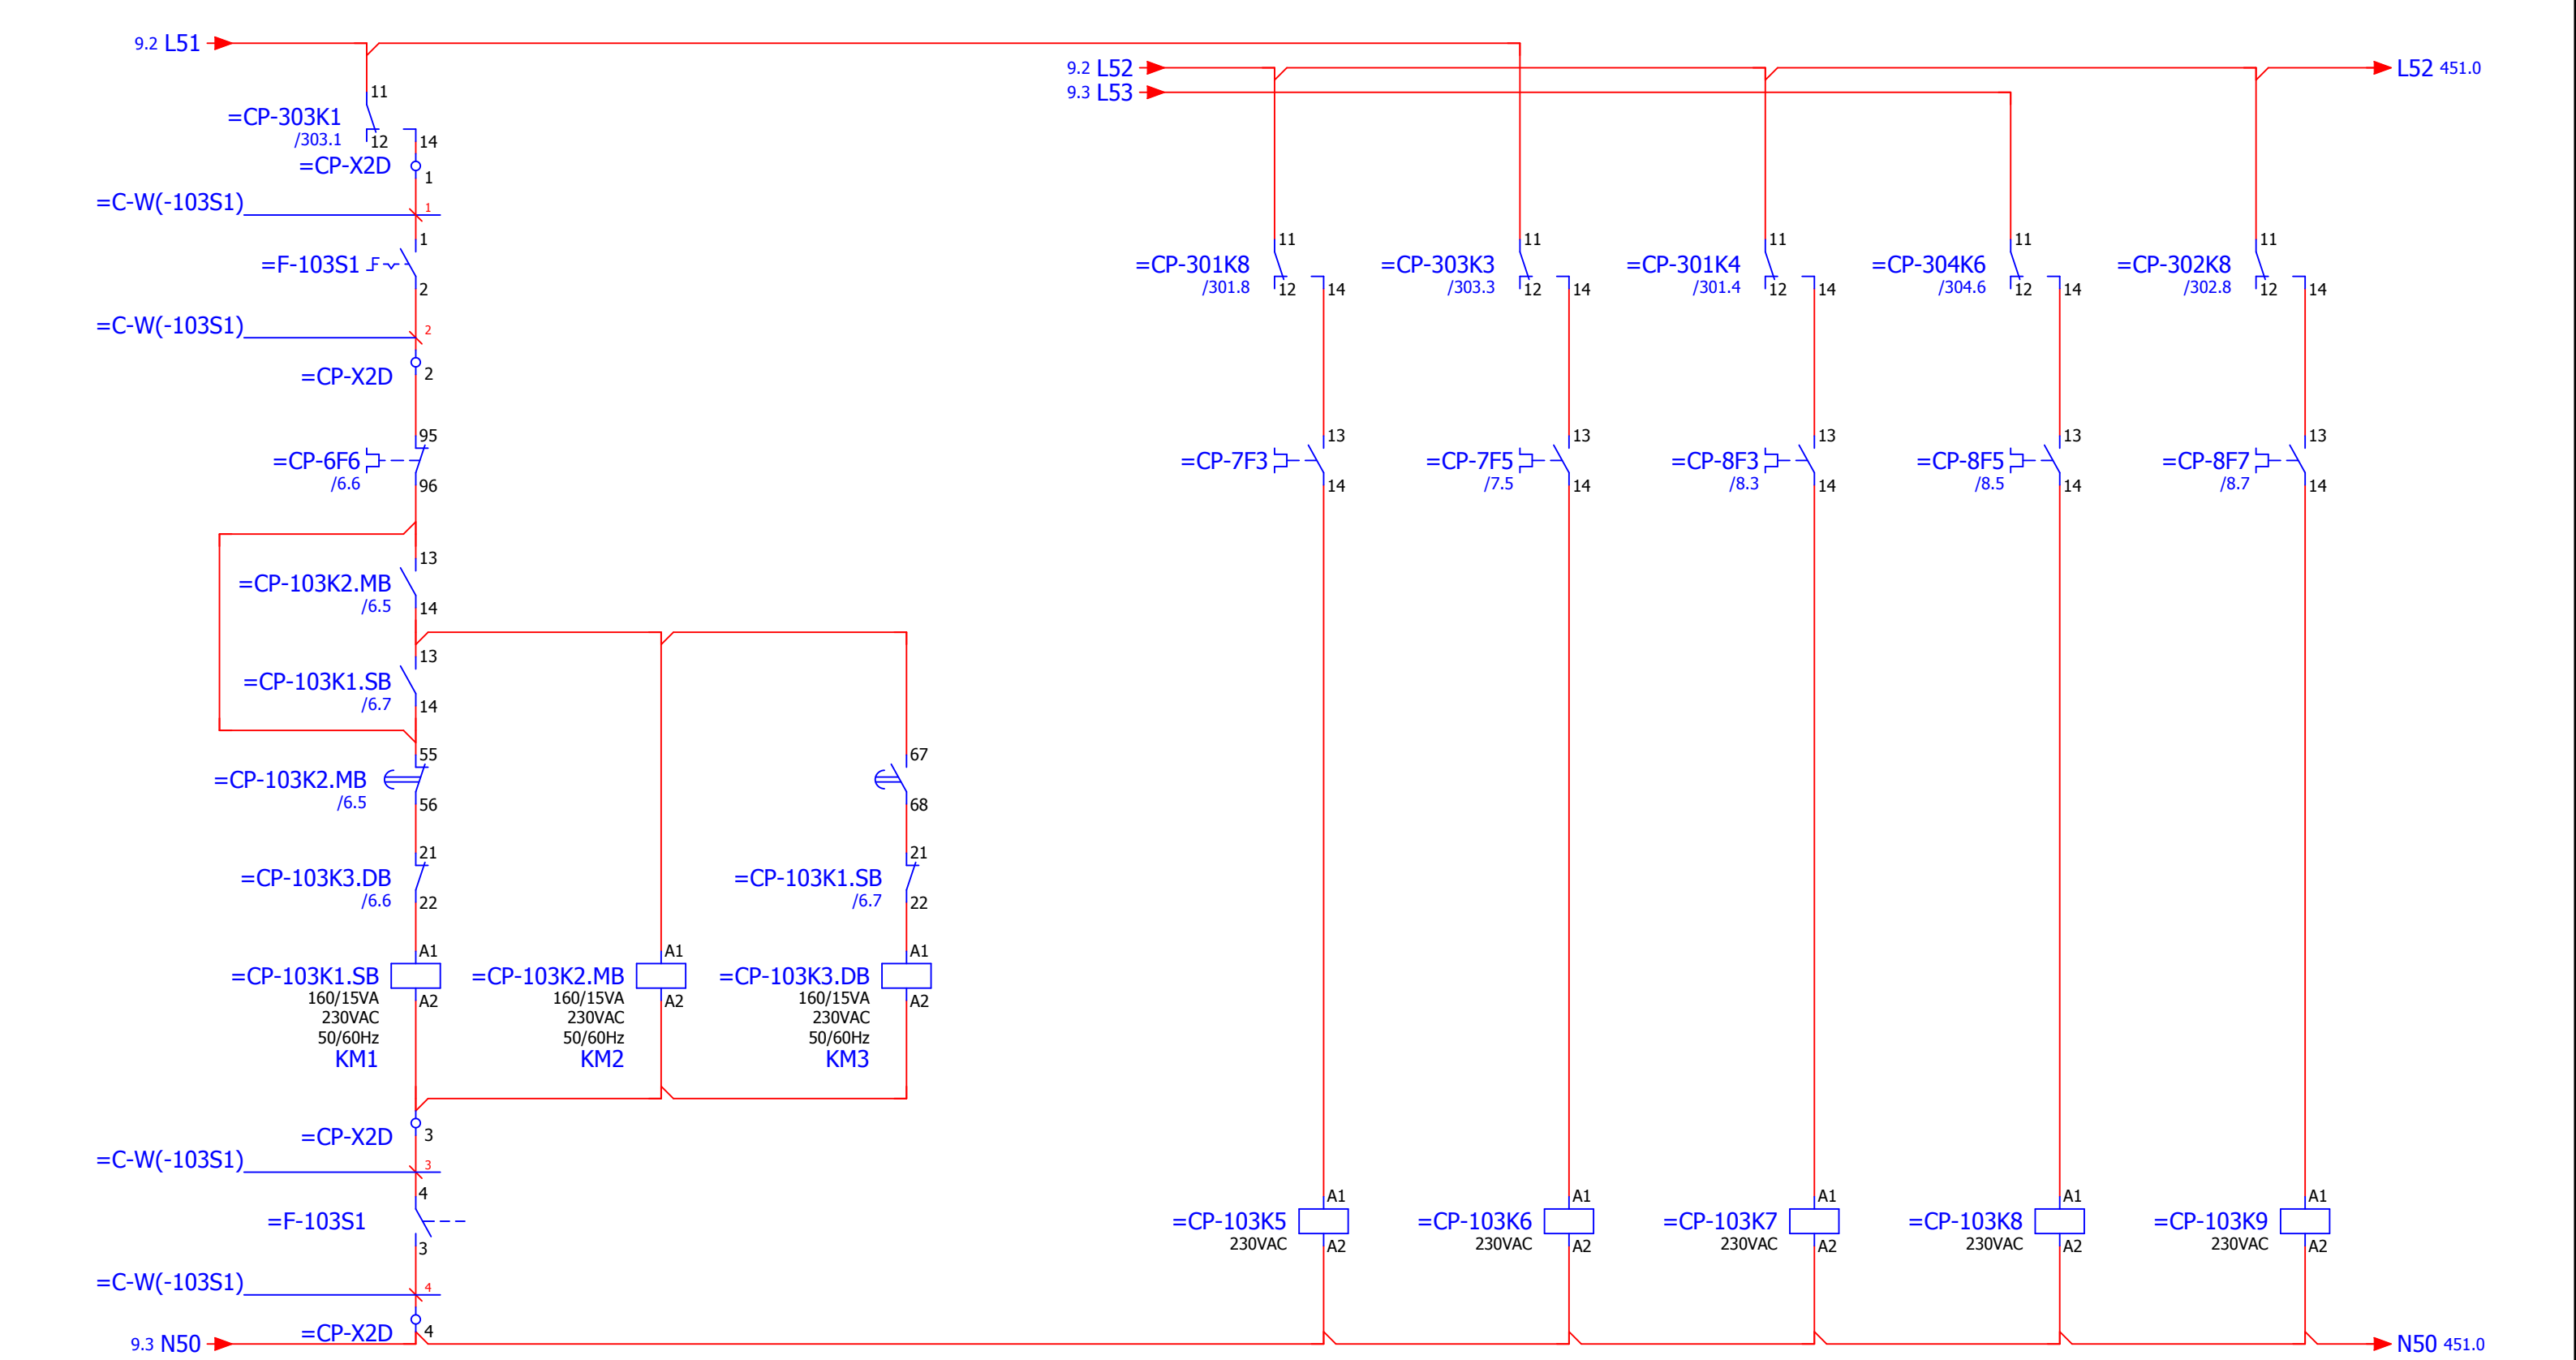

HYDRO UNIT PRESS

OUTFEED
CONVEYOR B28

COOLING PUMP


INFEED
CONVEYOR
BREAKER B40

HYDRO UNIT
BREAKER

CONVEYOR B37
OPTIONAL


previous:
102.A

next:
104

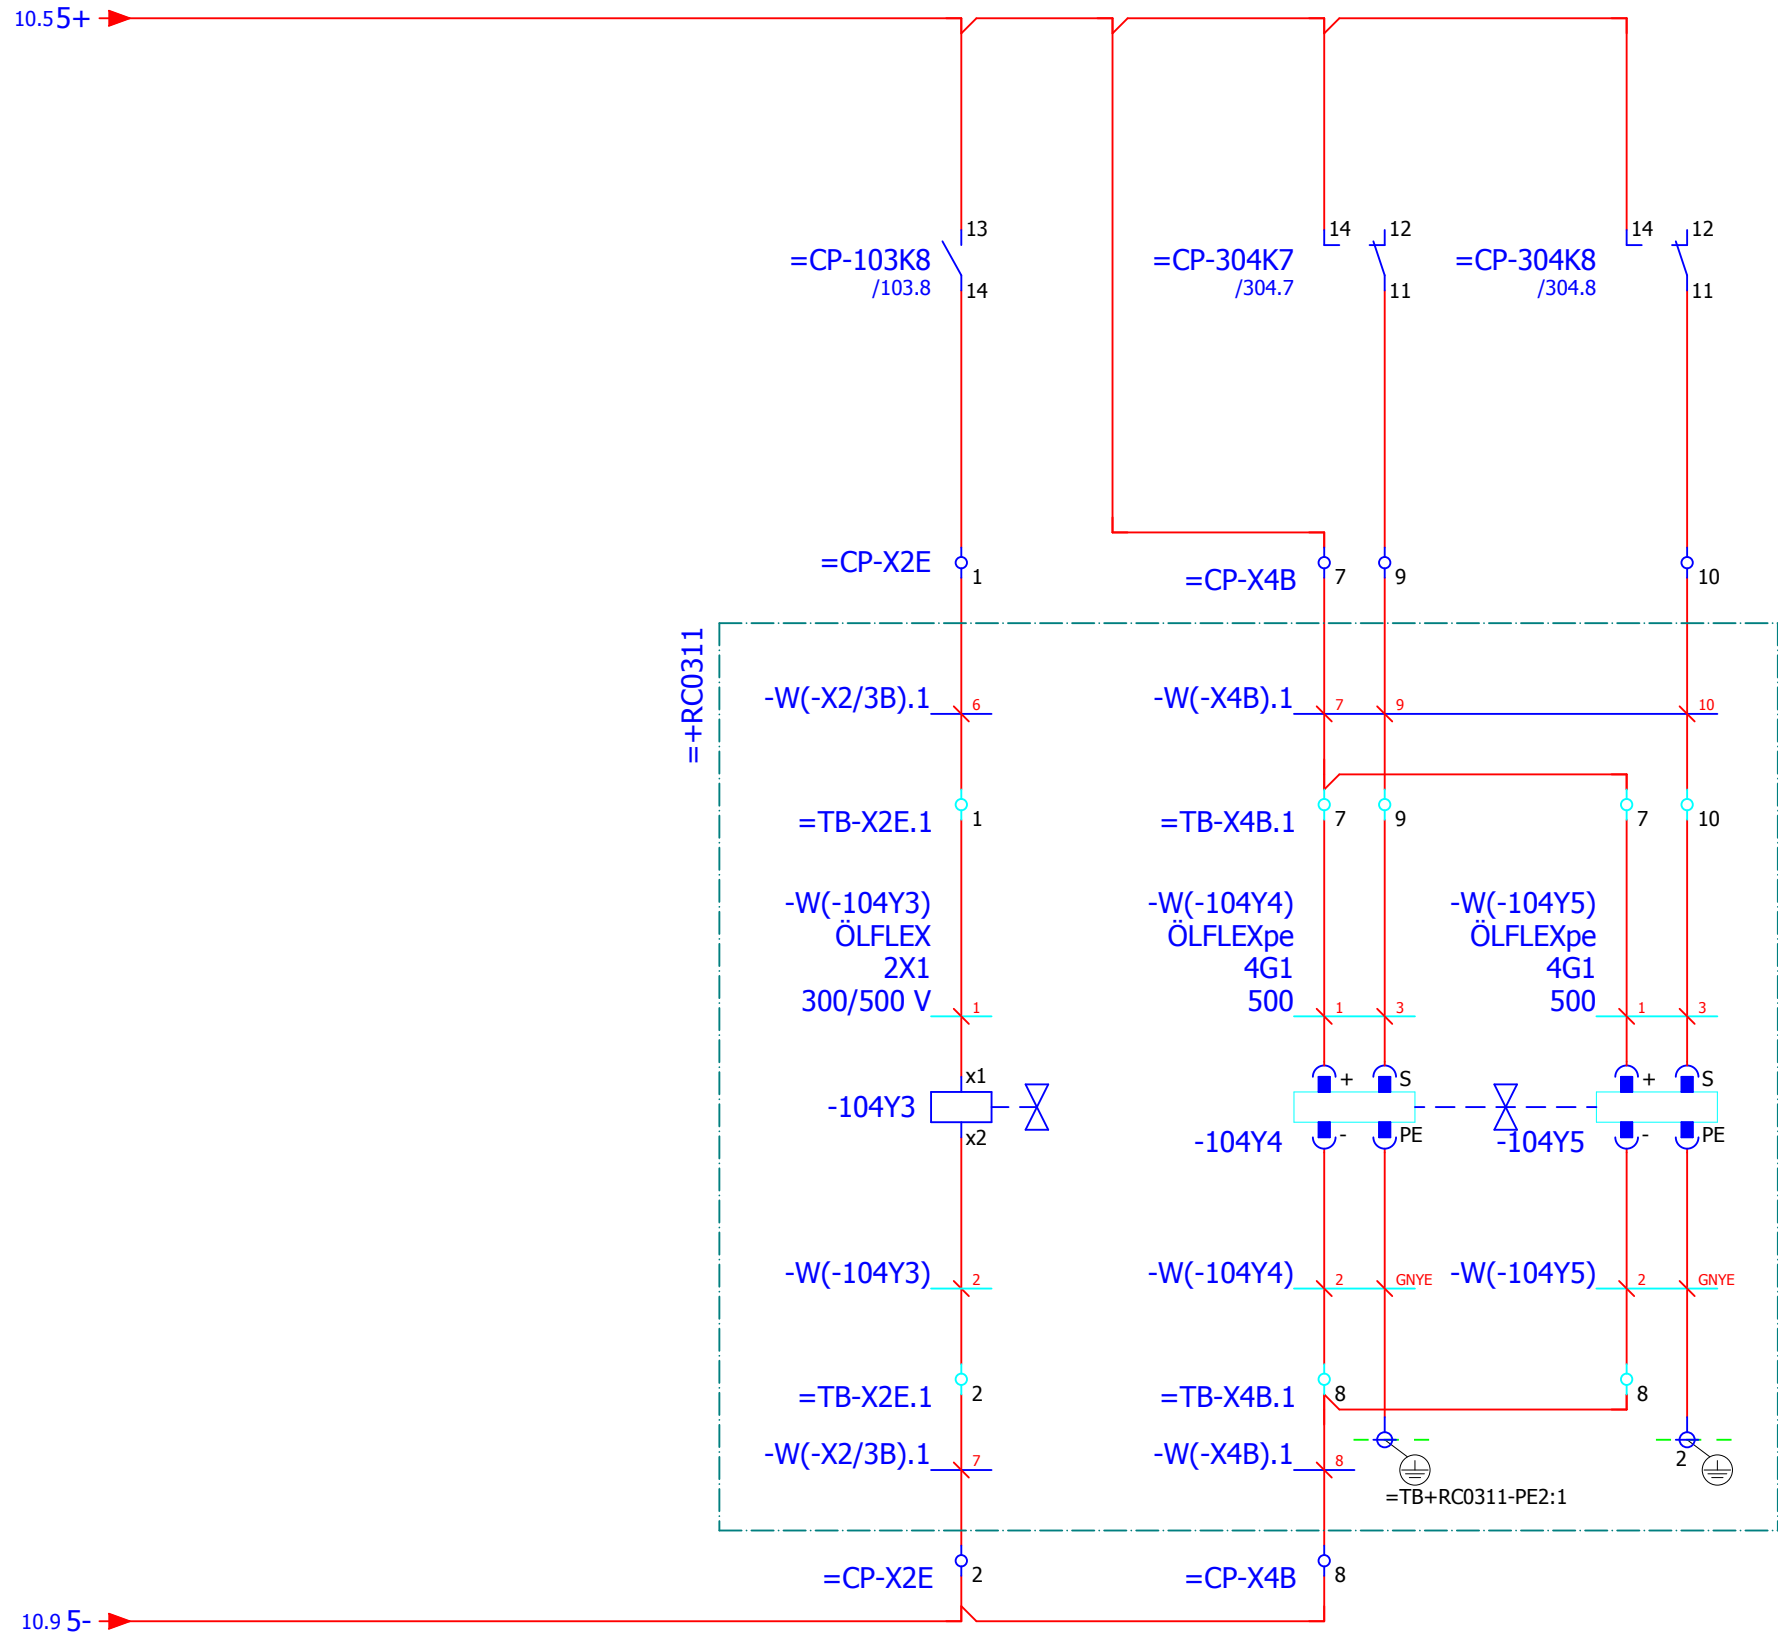


previous:
103

next:
105

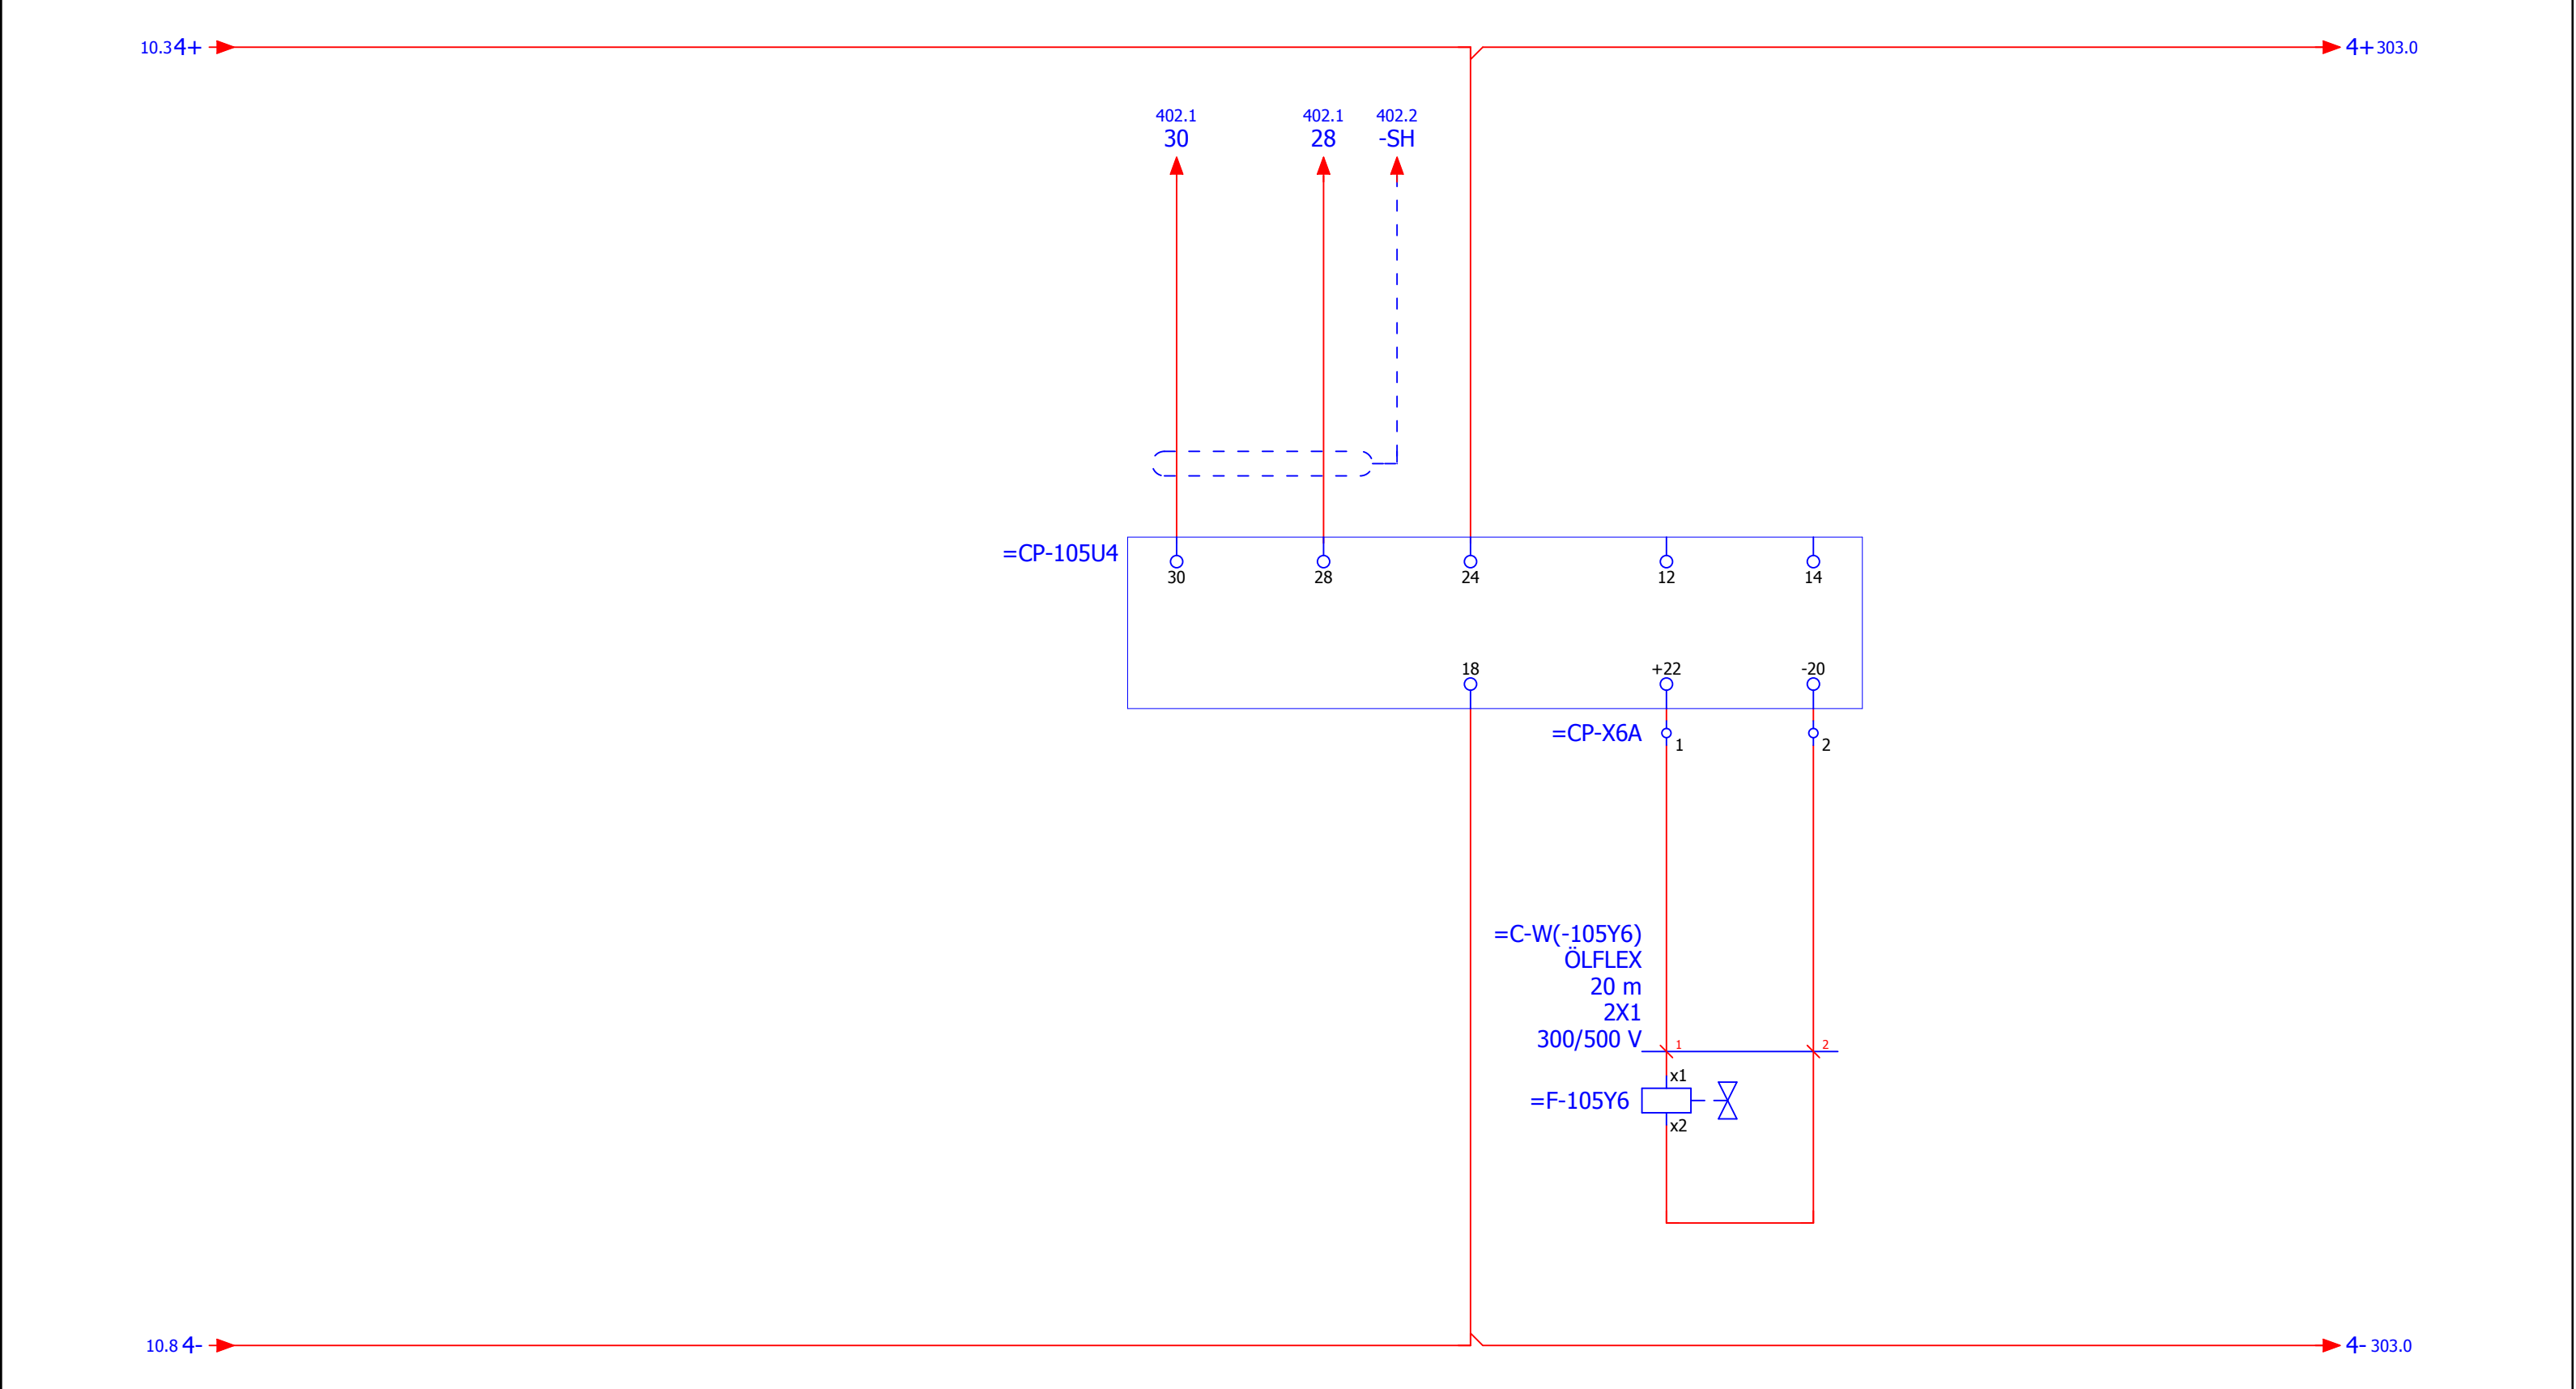


previous: 104		next: 200		DIPSWITCH S1		DIPSWITCH S2	
				1 = OFF	1 = OFF	2 = OFF	2 = ON
				3 = OFF	3 = ON	3 = OFF	3 = ON
				4 = ON	4 = OFF	4 = ON	4 = OFF
				5 = ON	5 = OFF	5 = ON	5 = OFF
				6 = OFF	6 = ON	6 = OFF	6 = ON
				7 = ON	7 = ON	7 = ON	7 = ON

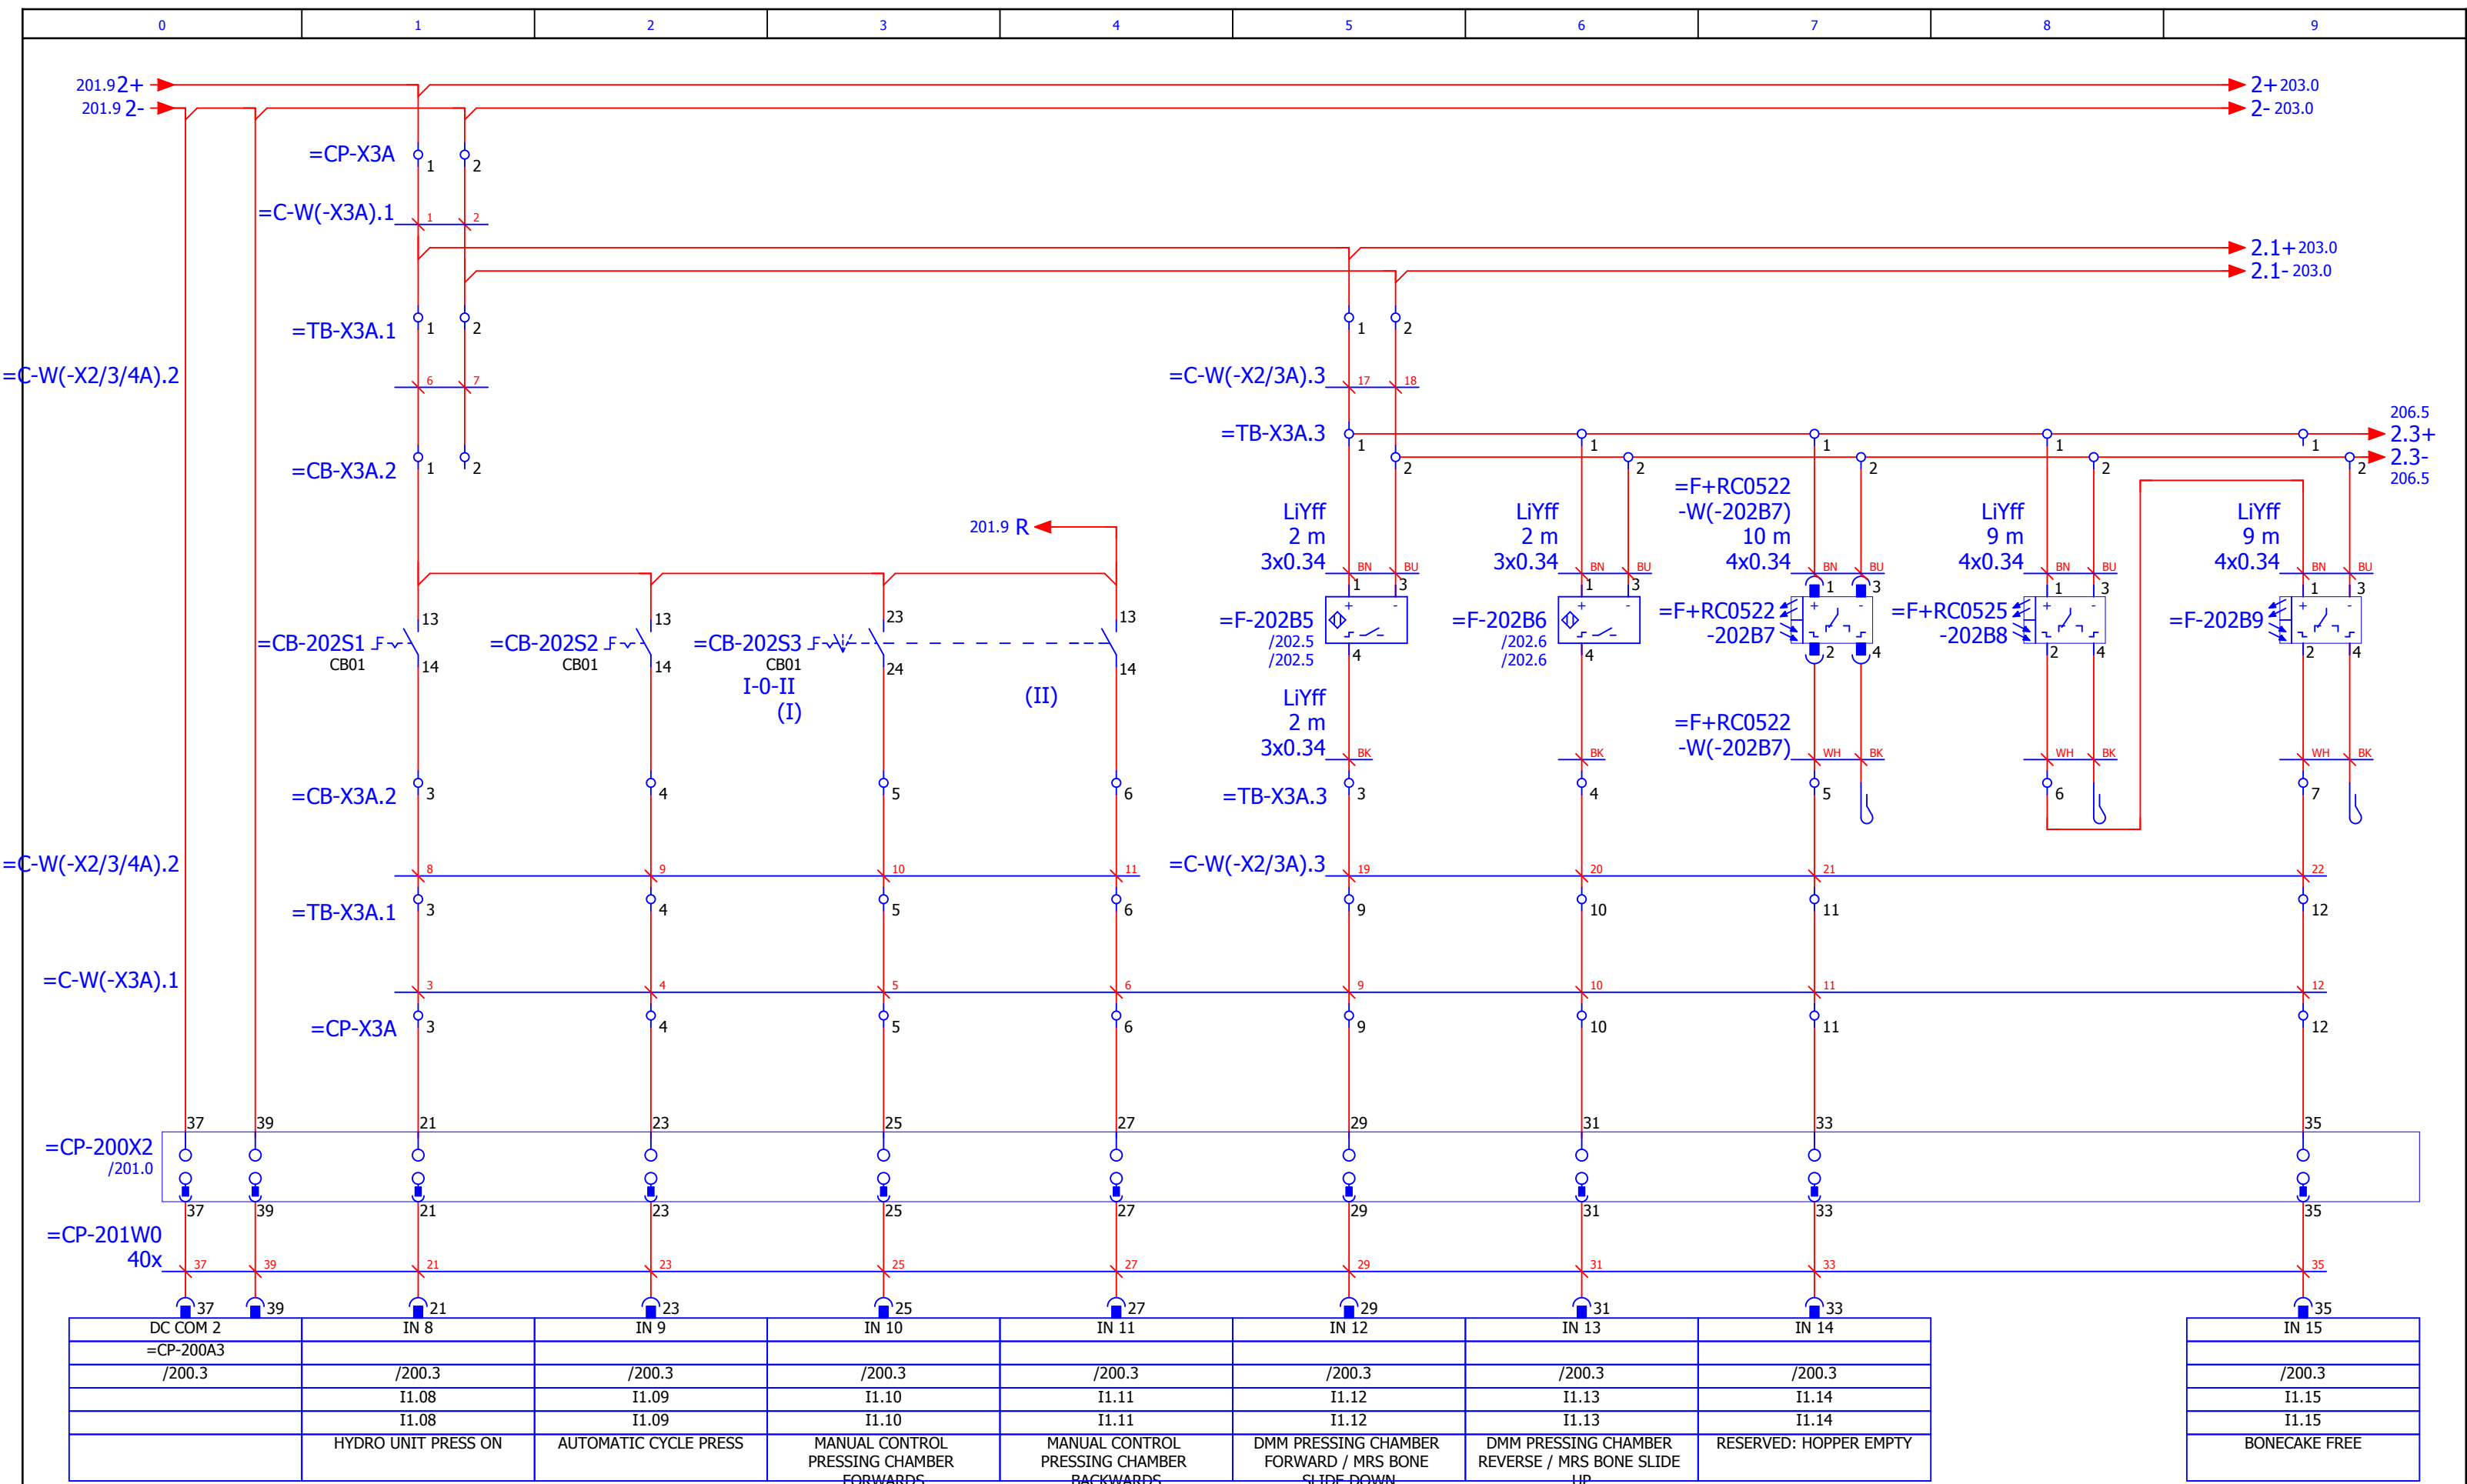


RESERVED:
BONECAKE FREE

previous:
201


next:
203

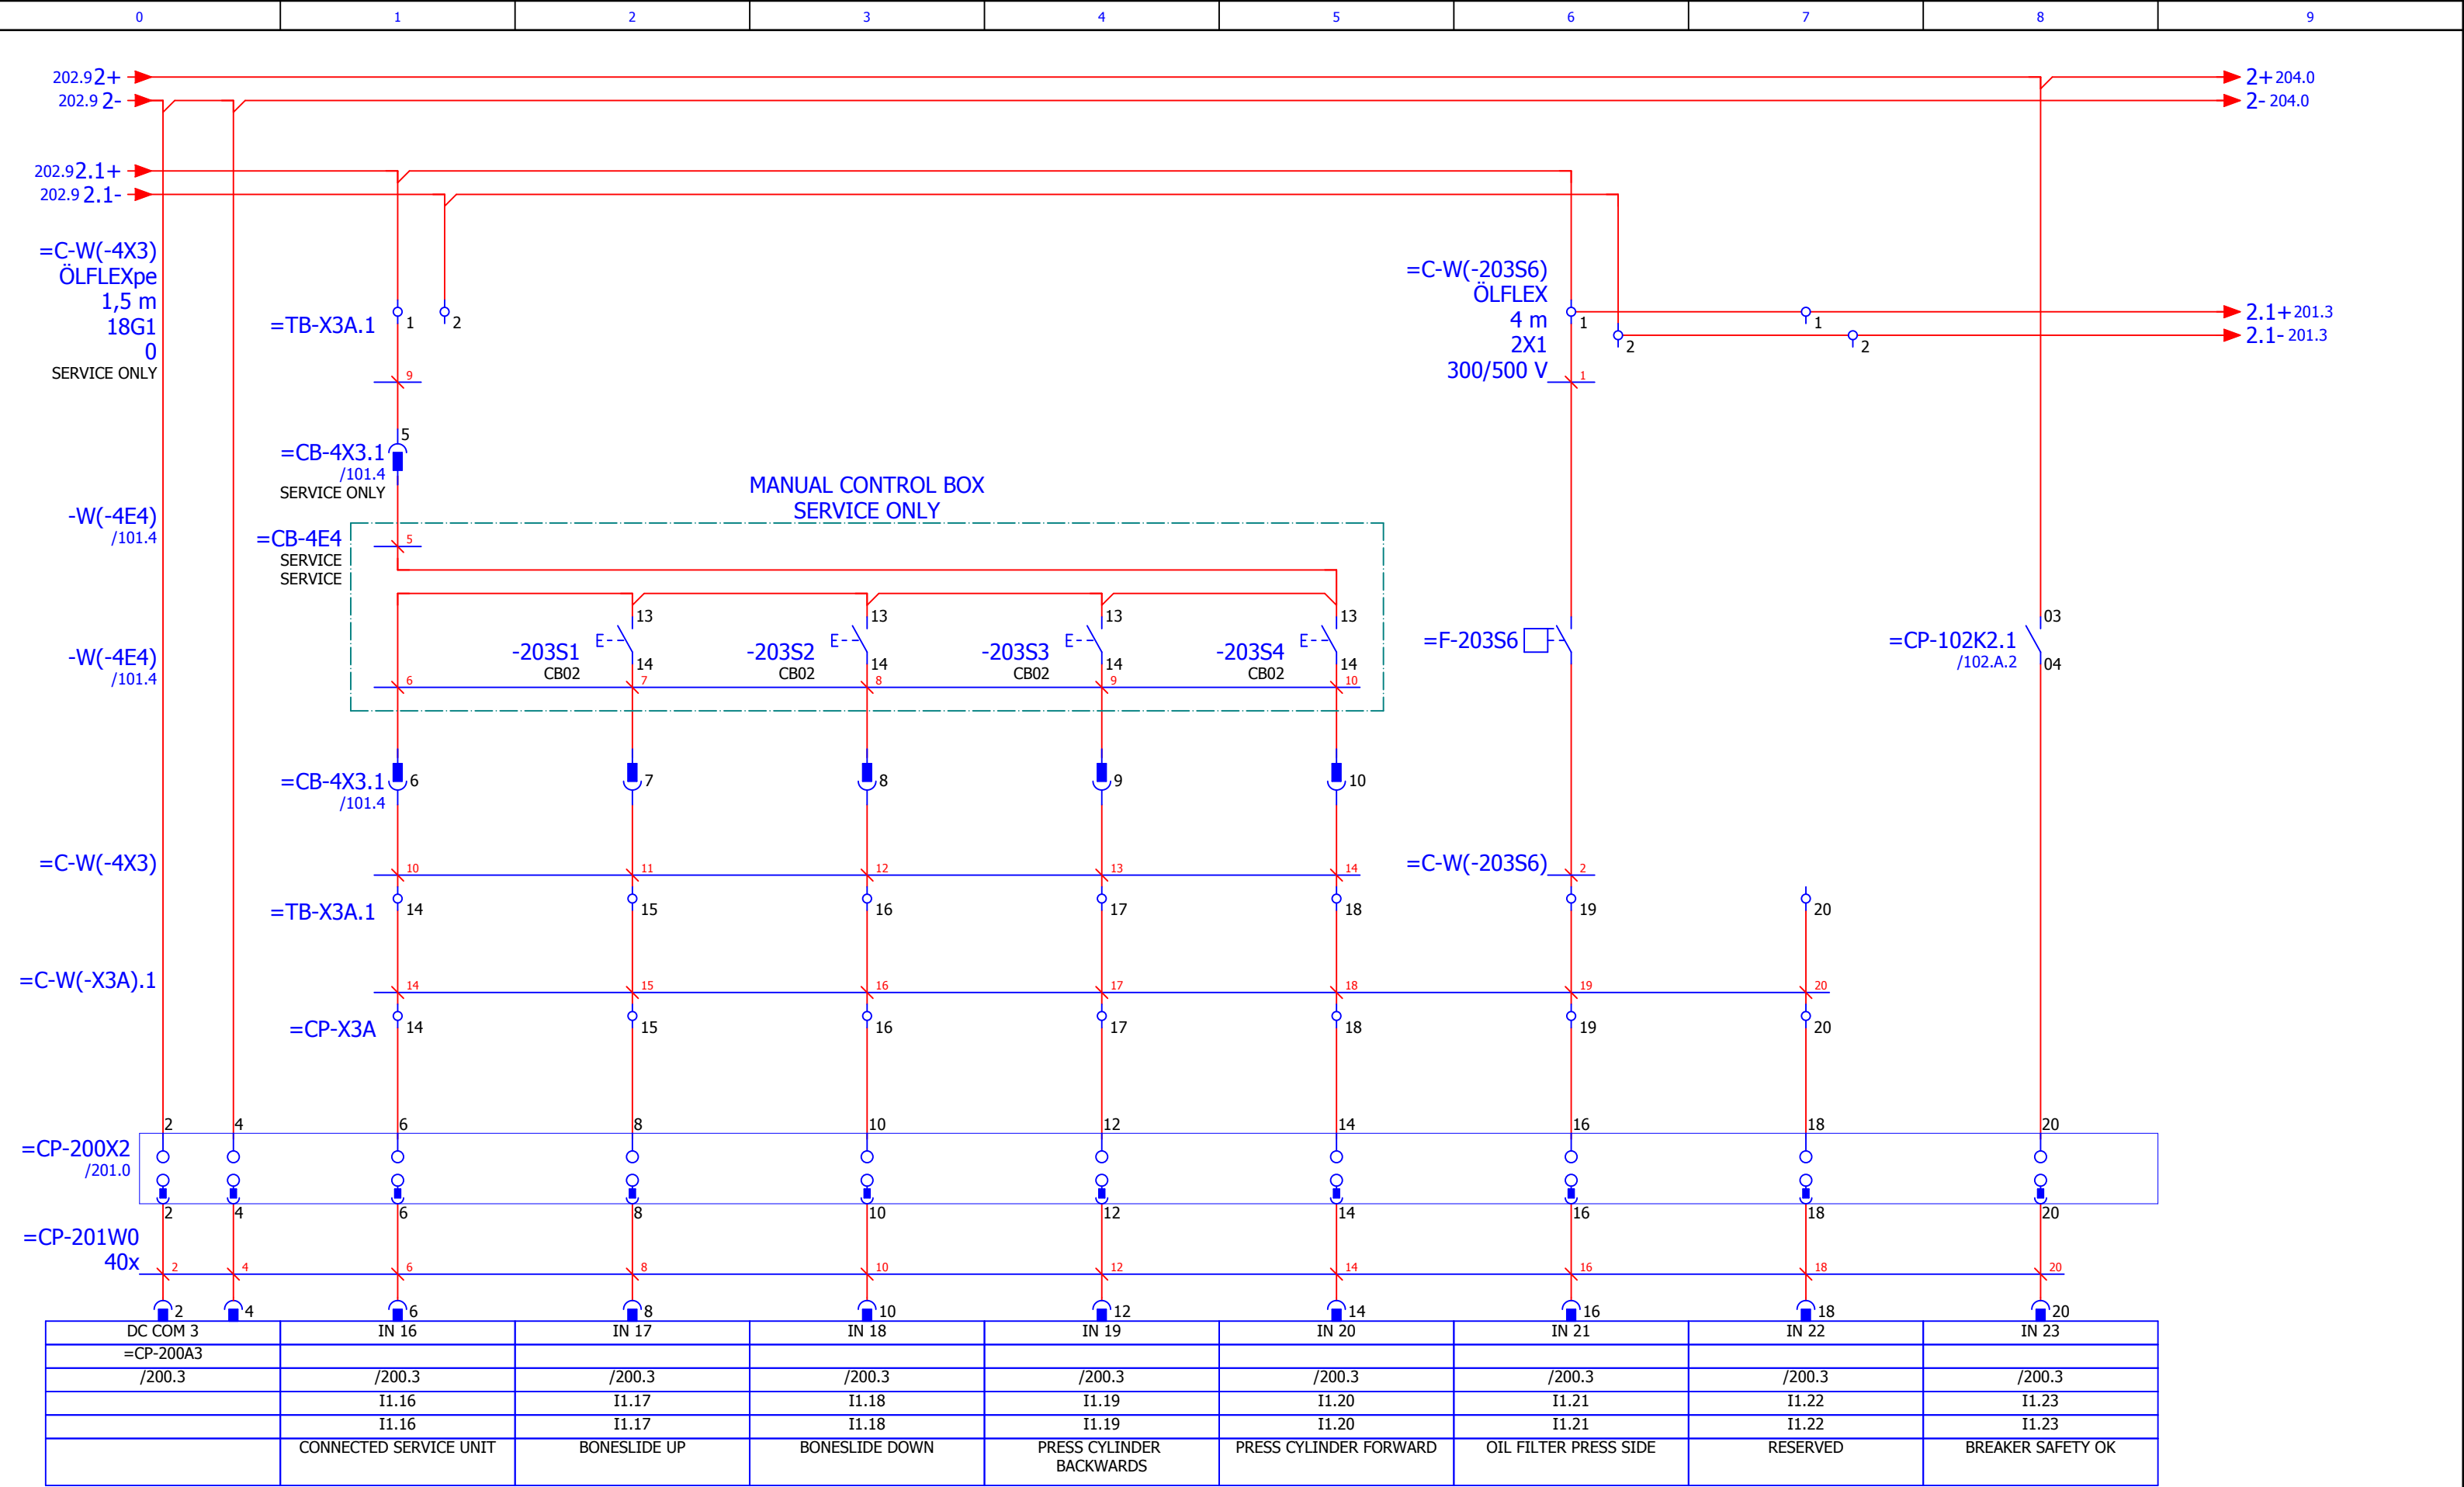


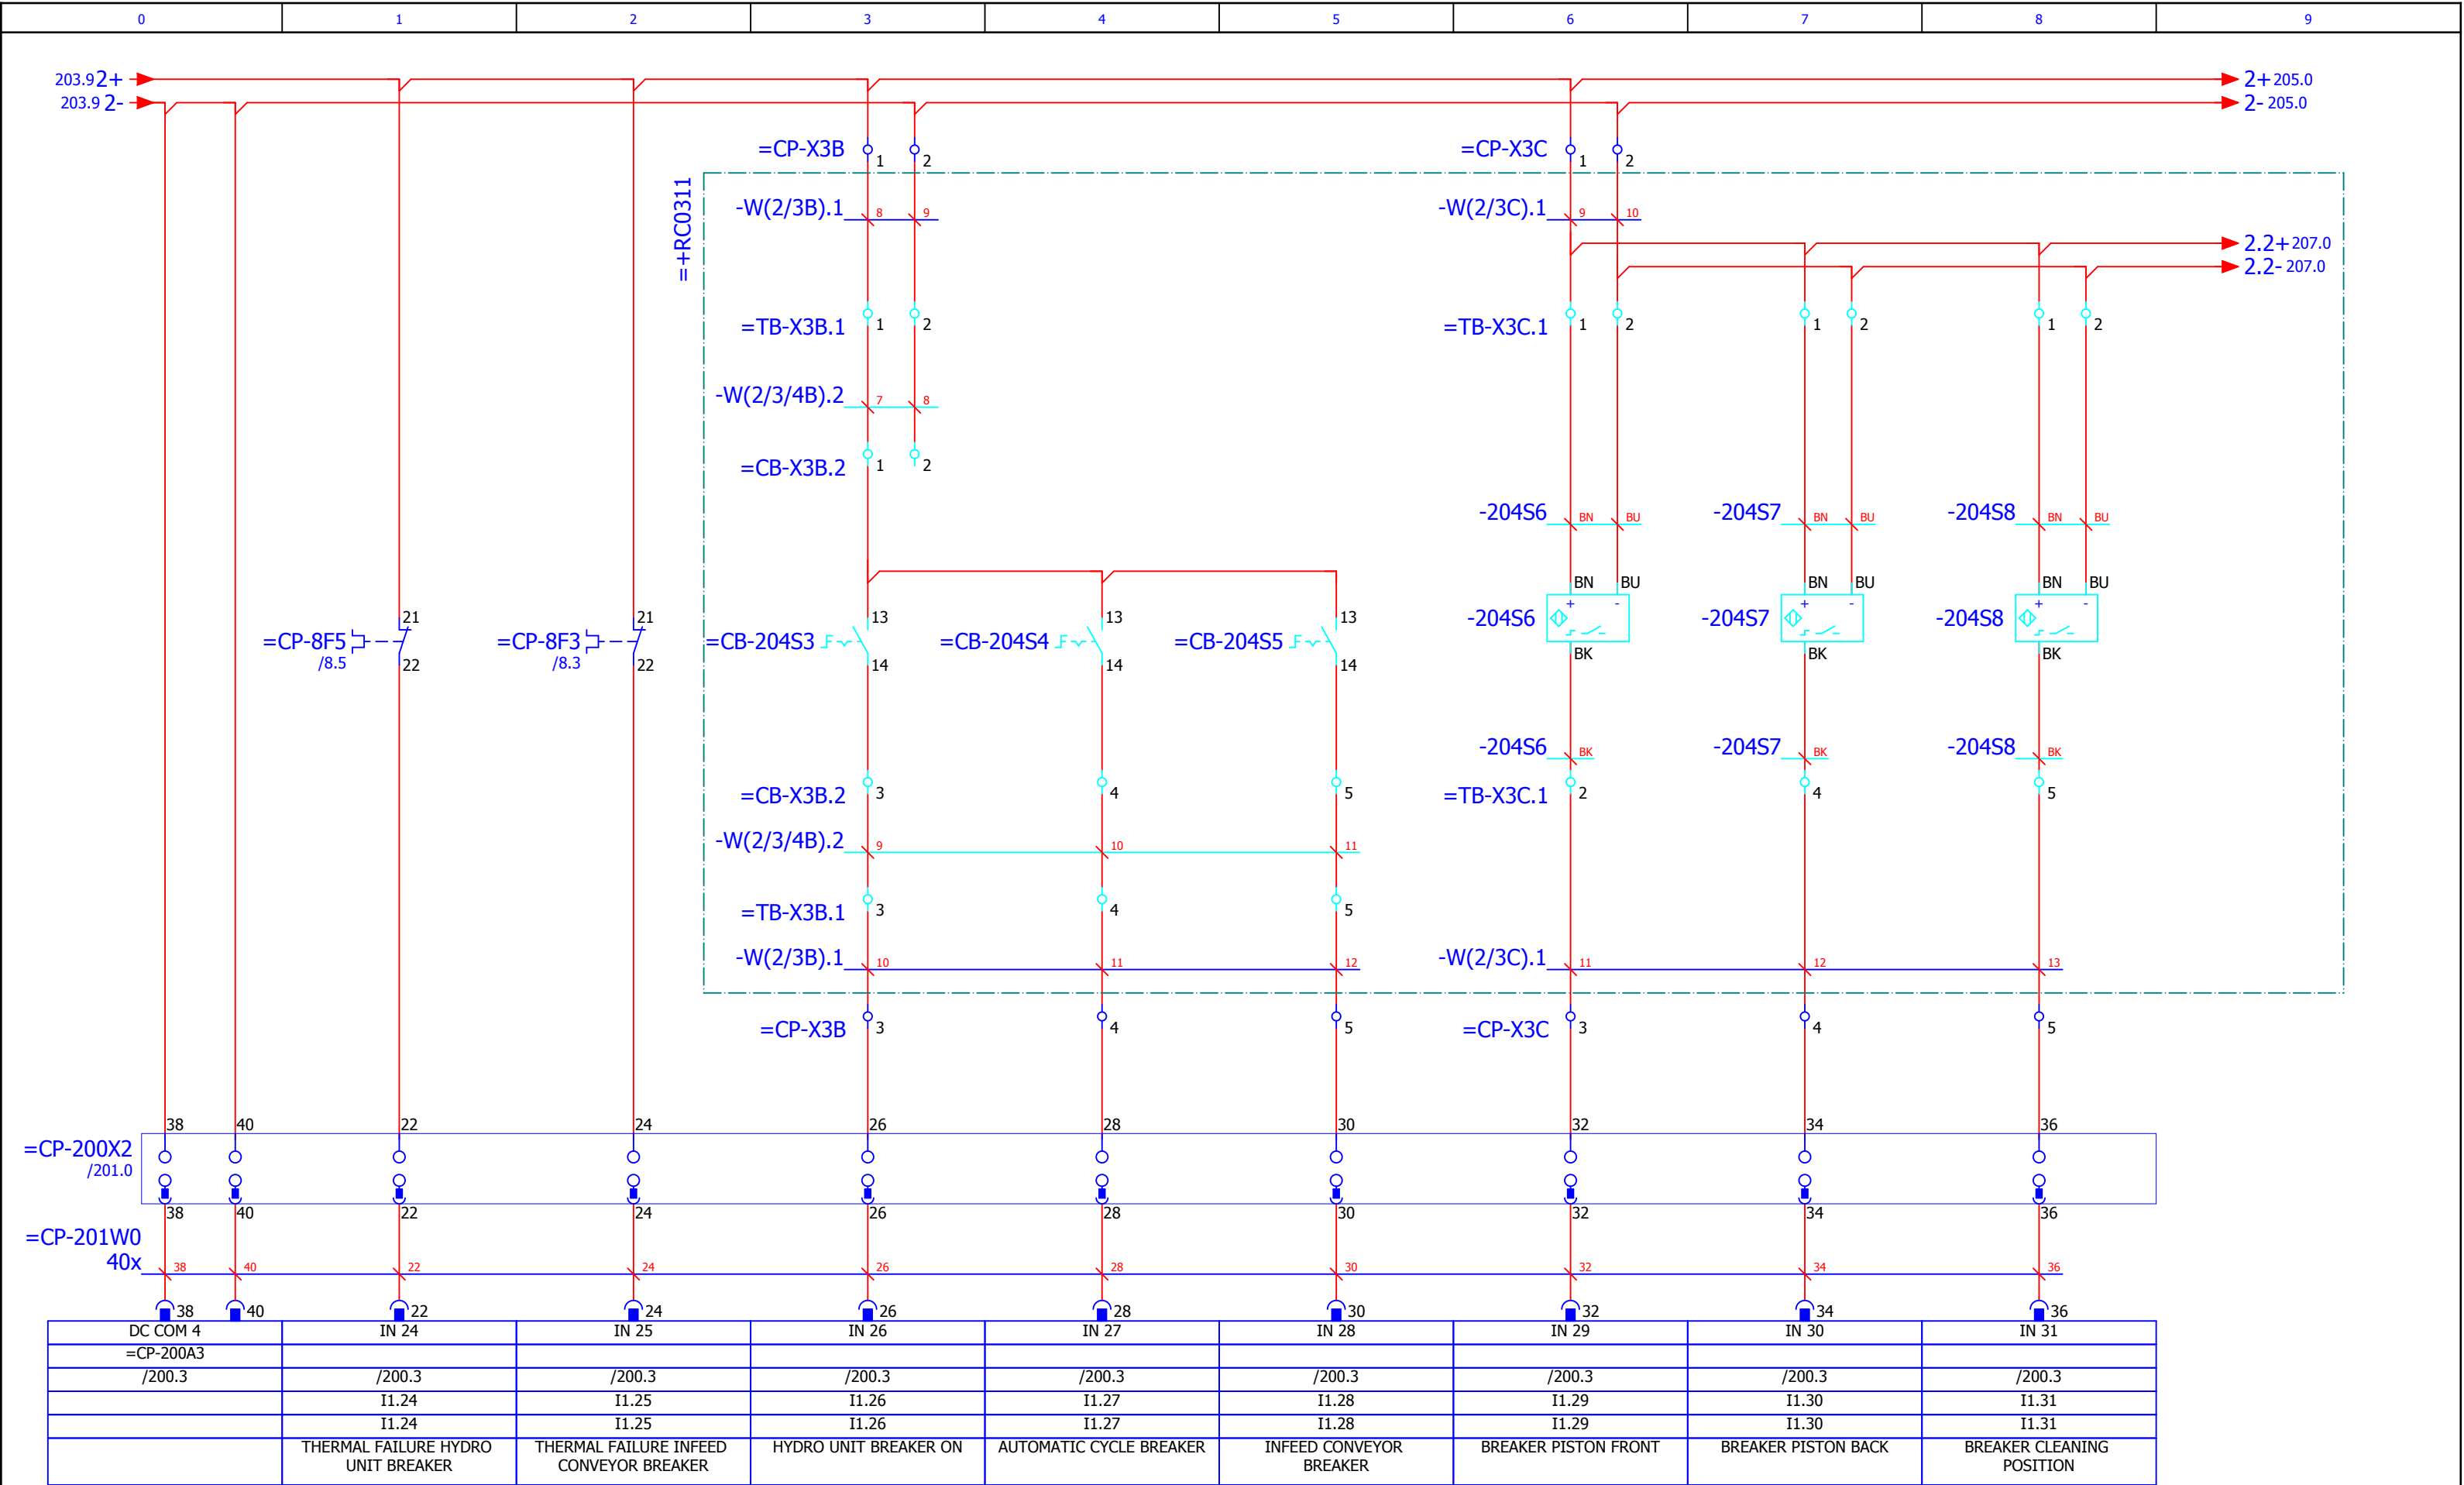


previous:
203


next:
205

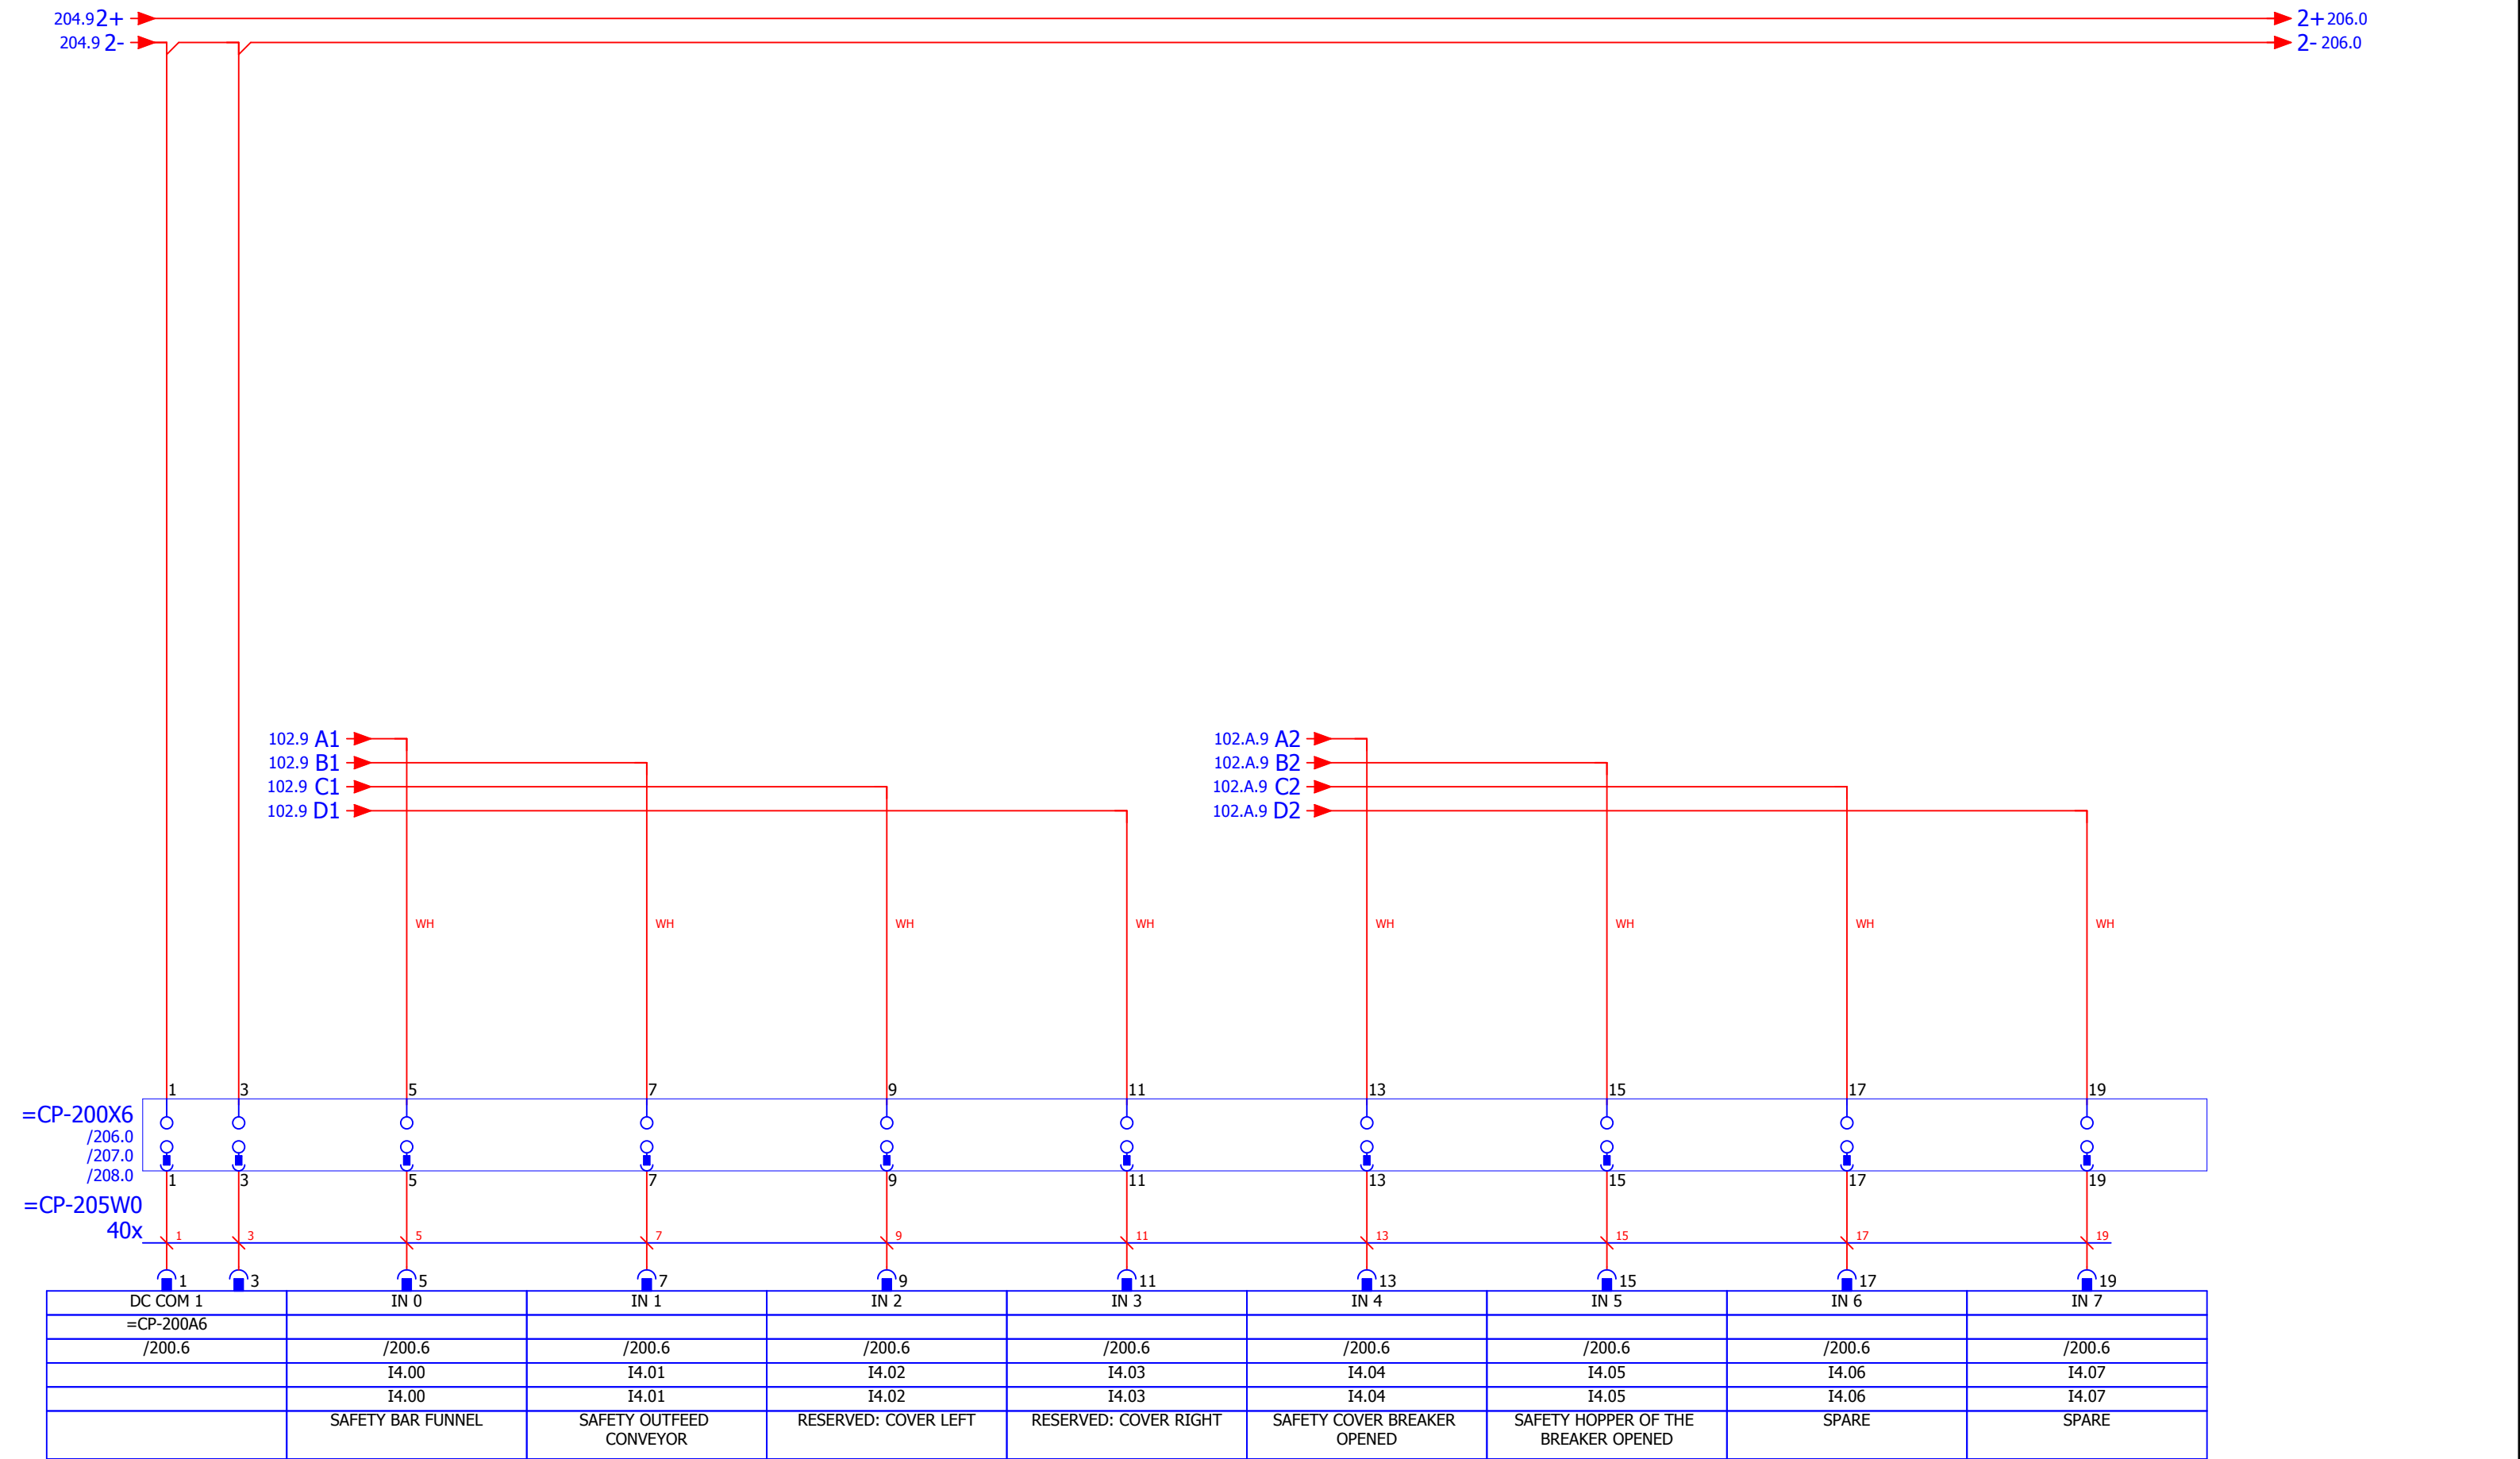

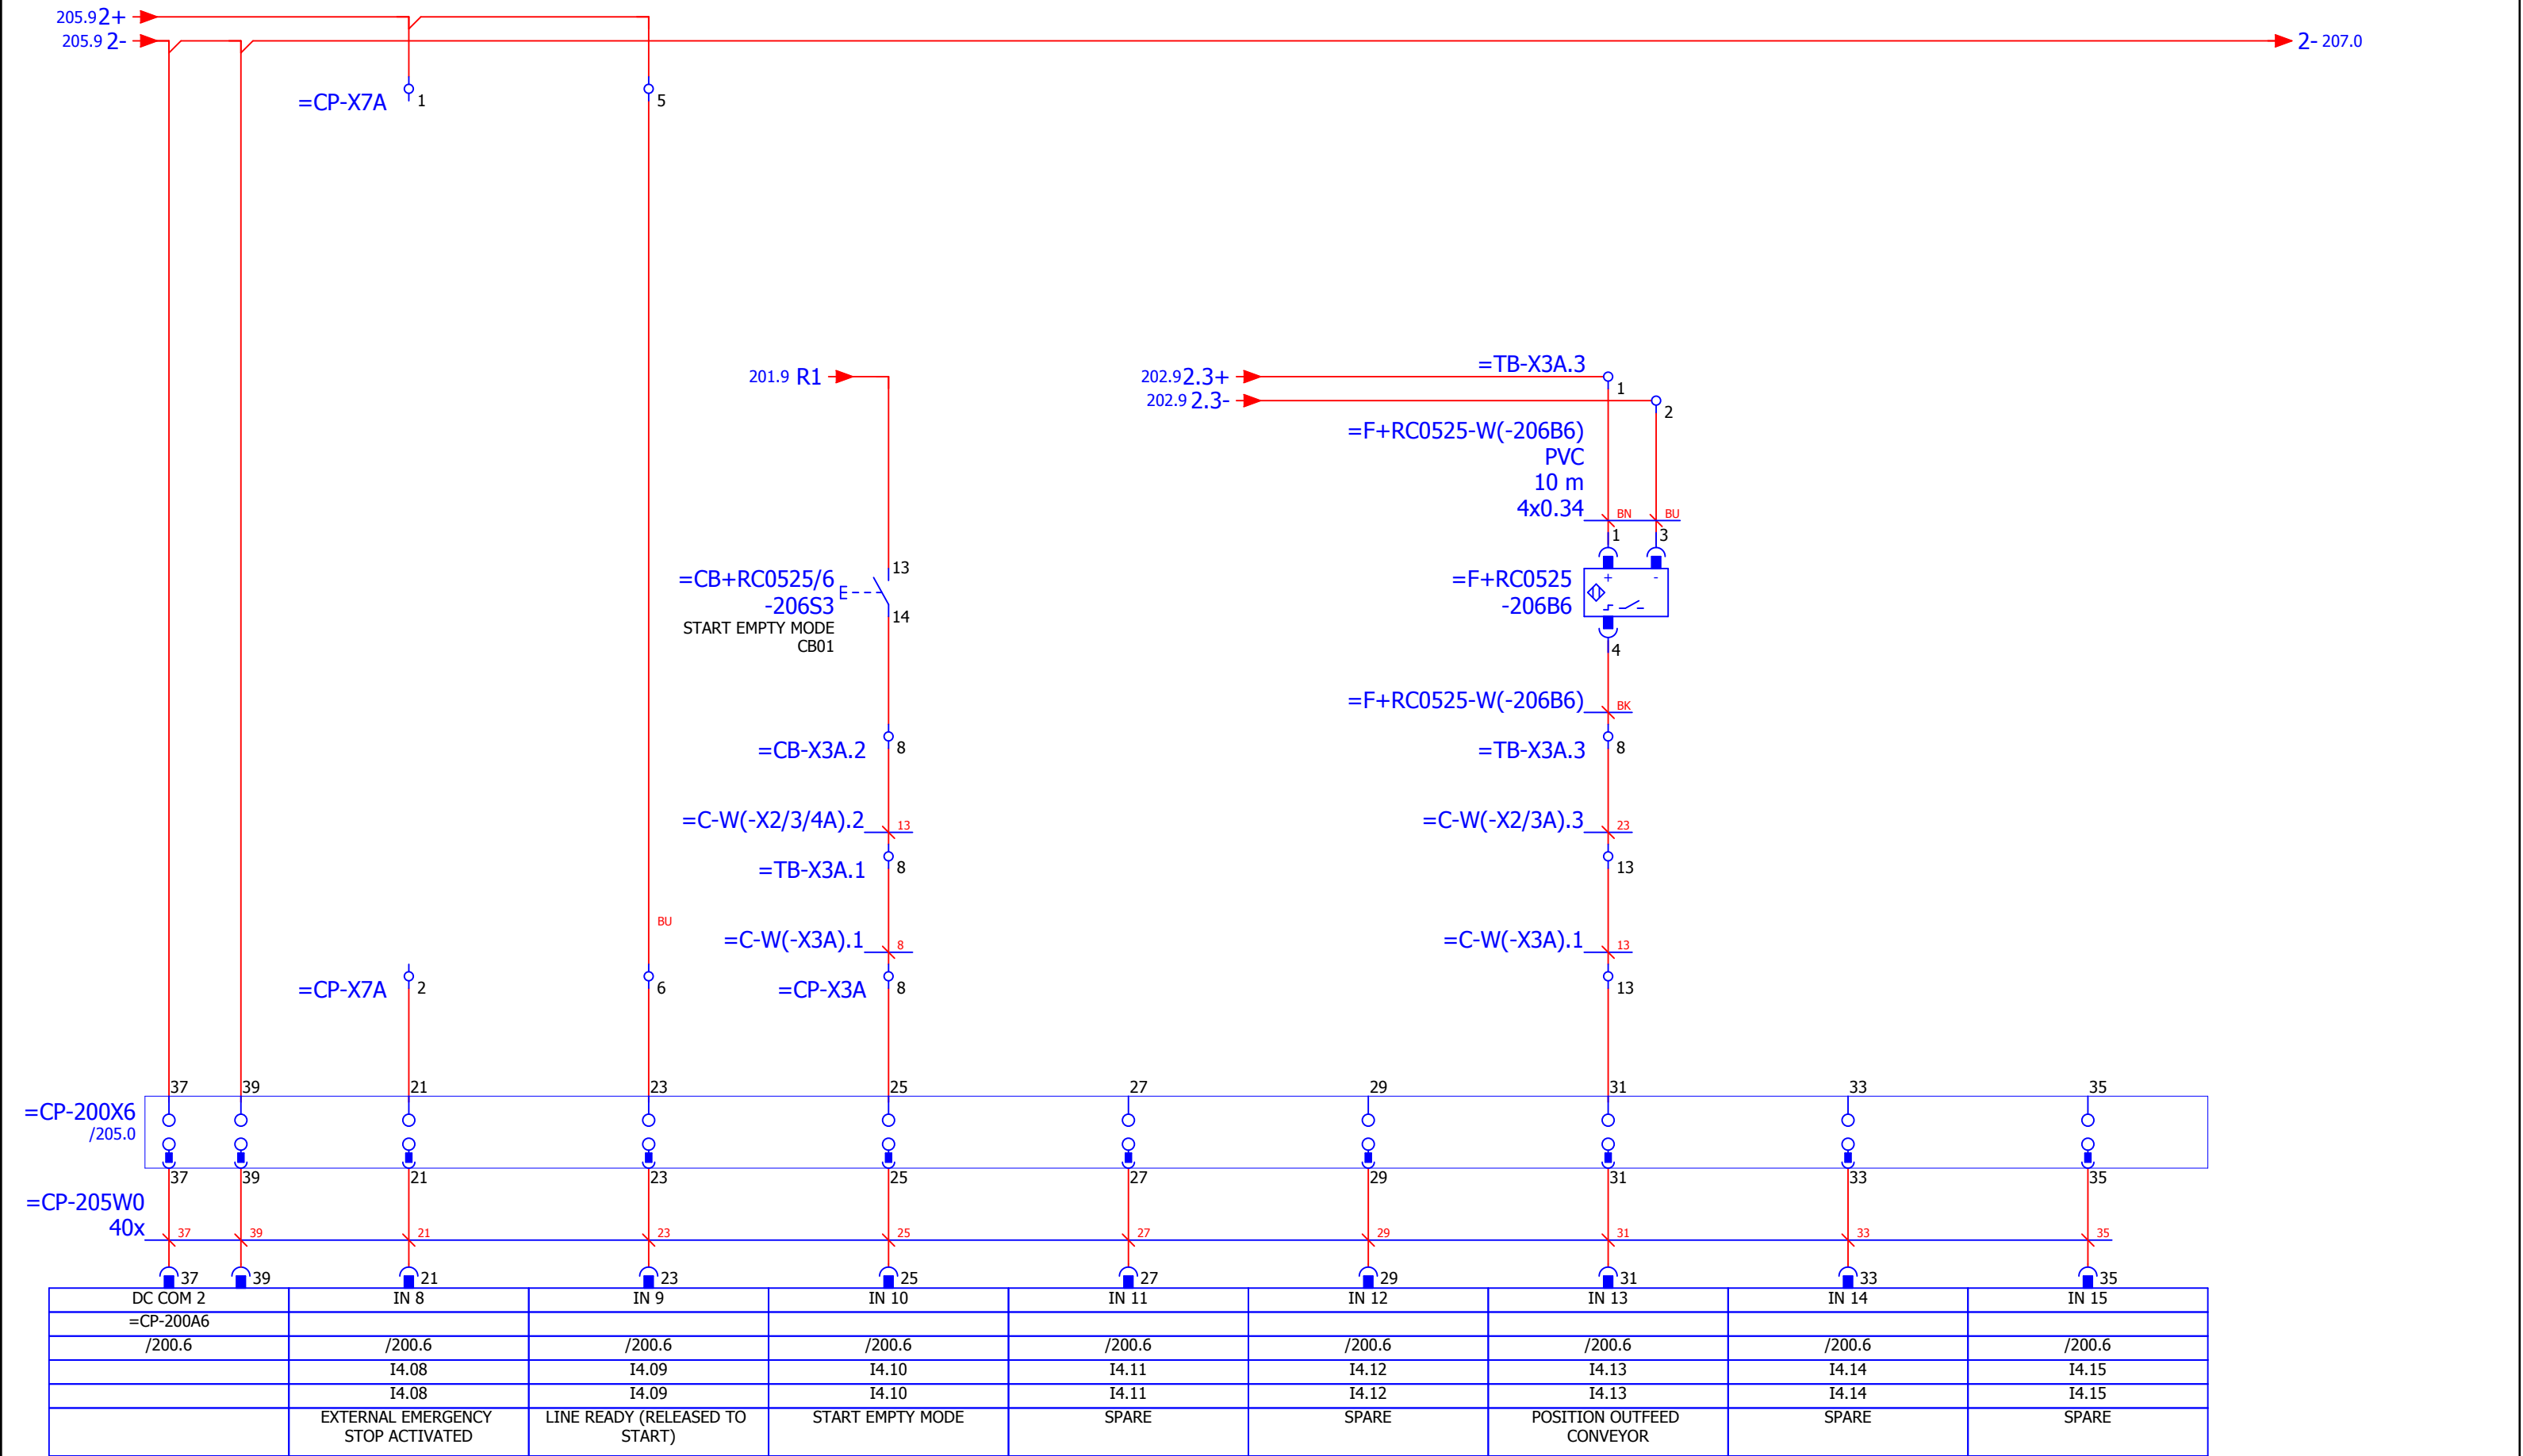



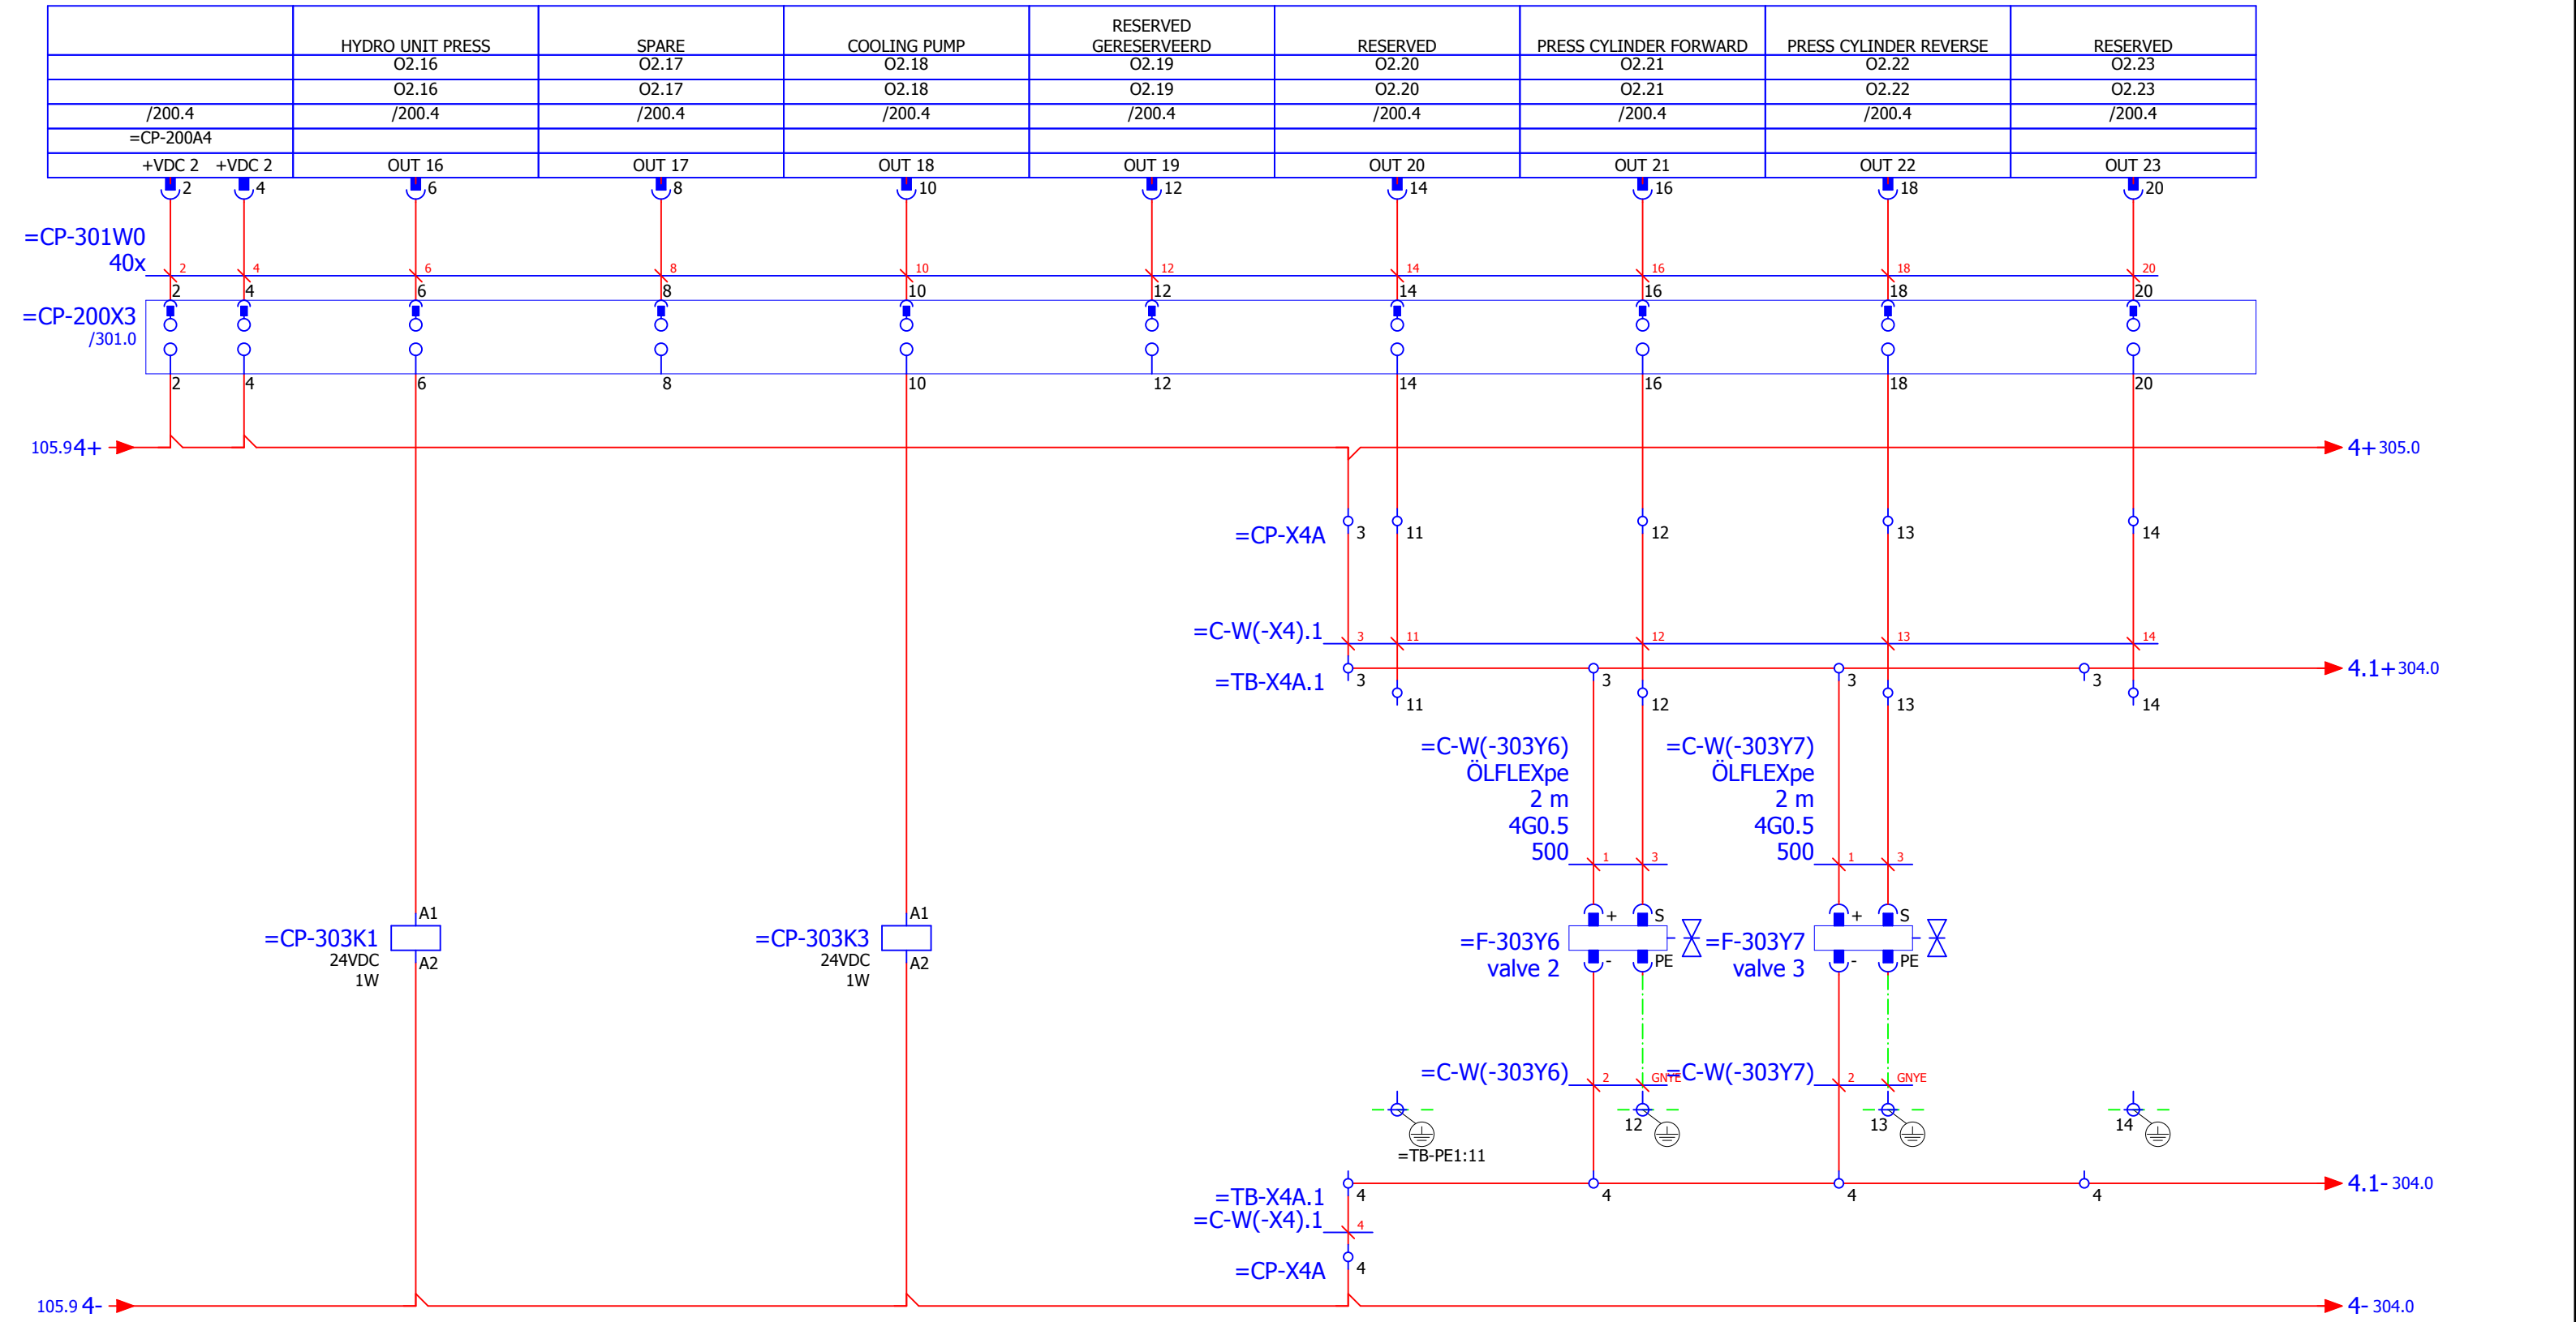


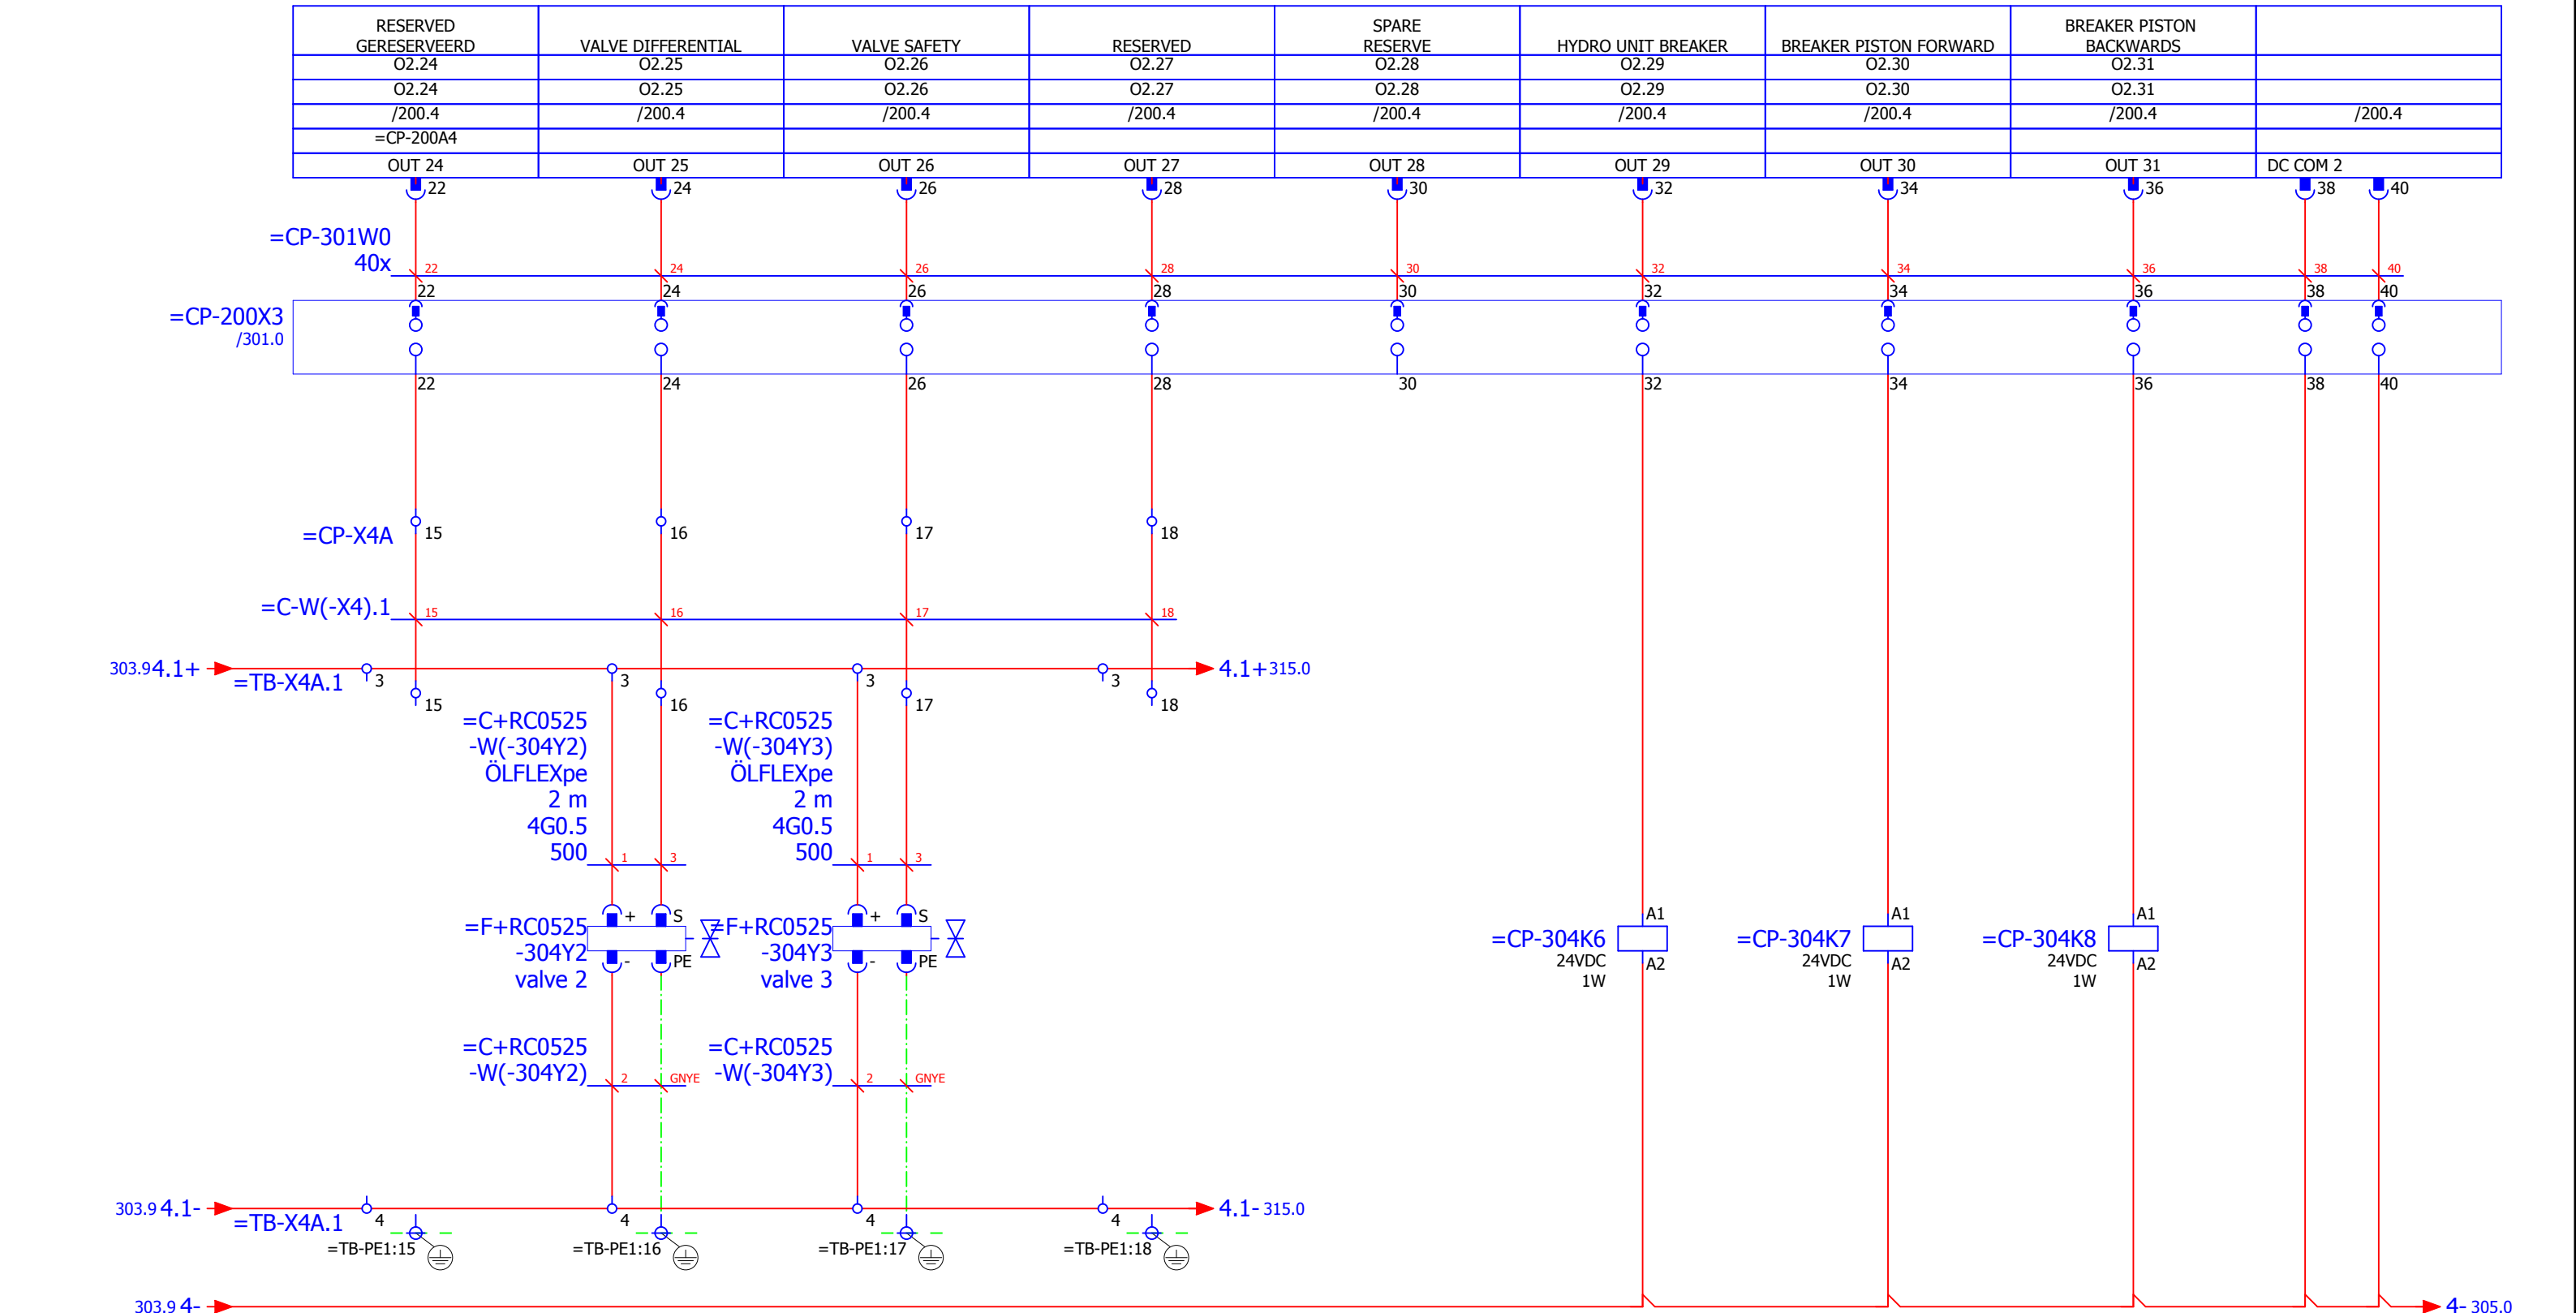

RESET ALARMS =CP-305K1:A1	SPARE O0.01	SPARE O0.02	SPARE O0.03	SPARE O0.04	SPARE O0.05	SPARE O0.06	SPARE O0.07	SUPPLY
O0.00	O0.01	O0.02	O0.03	O0.04	O0.05	O0.06	O0.07	
/200.2	/200.2	/200.2	/200.2	/200.2	/200.2	/200.2	/200.2	/200.2
=CP-200A1								
DC OUT 00	DC OUT 01	DC OUT 02	DC OUT 03	DC OUT 04	DC OUT 05	DC OUT 06	DC OUT 07	COM 0
X1 12	X1 13	X1 14	X1 15	X1 16	X1 17	X1 18	X1 19	X1 20 X1 11

=CP-305K1
24VDC
1W


A1
A2

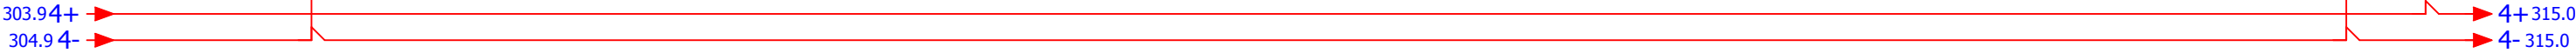

- 14
- 12 11 /102.1
- 24
- 22 21 /102.A.1
- 34
- 32 31
- 44
- 42 41

previous:
304

next:
315

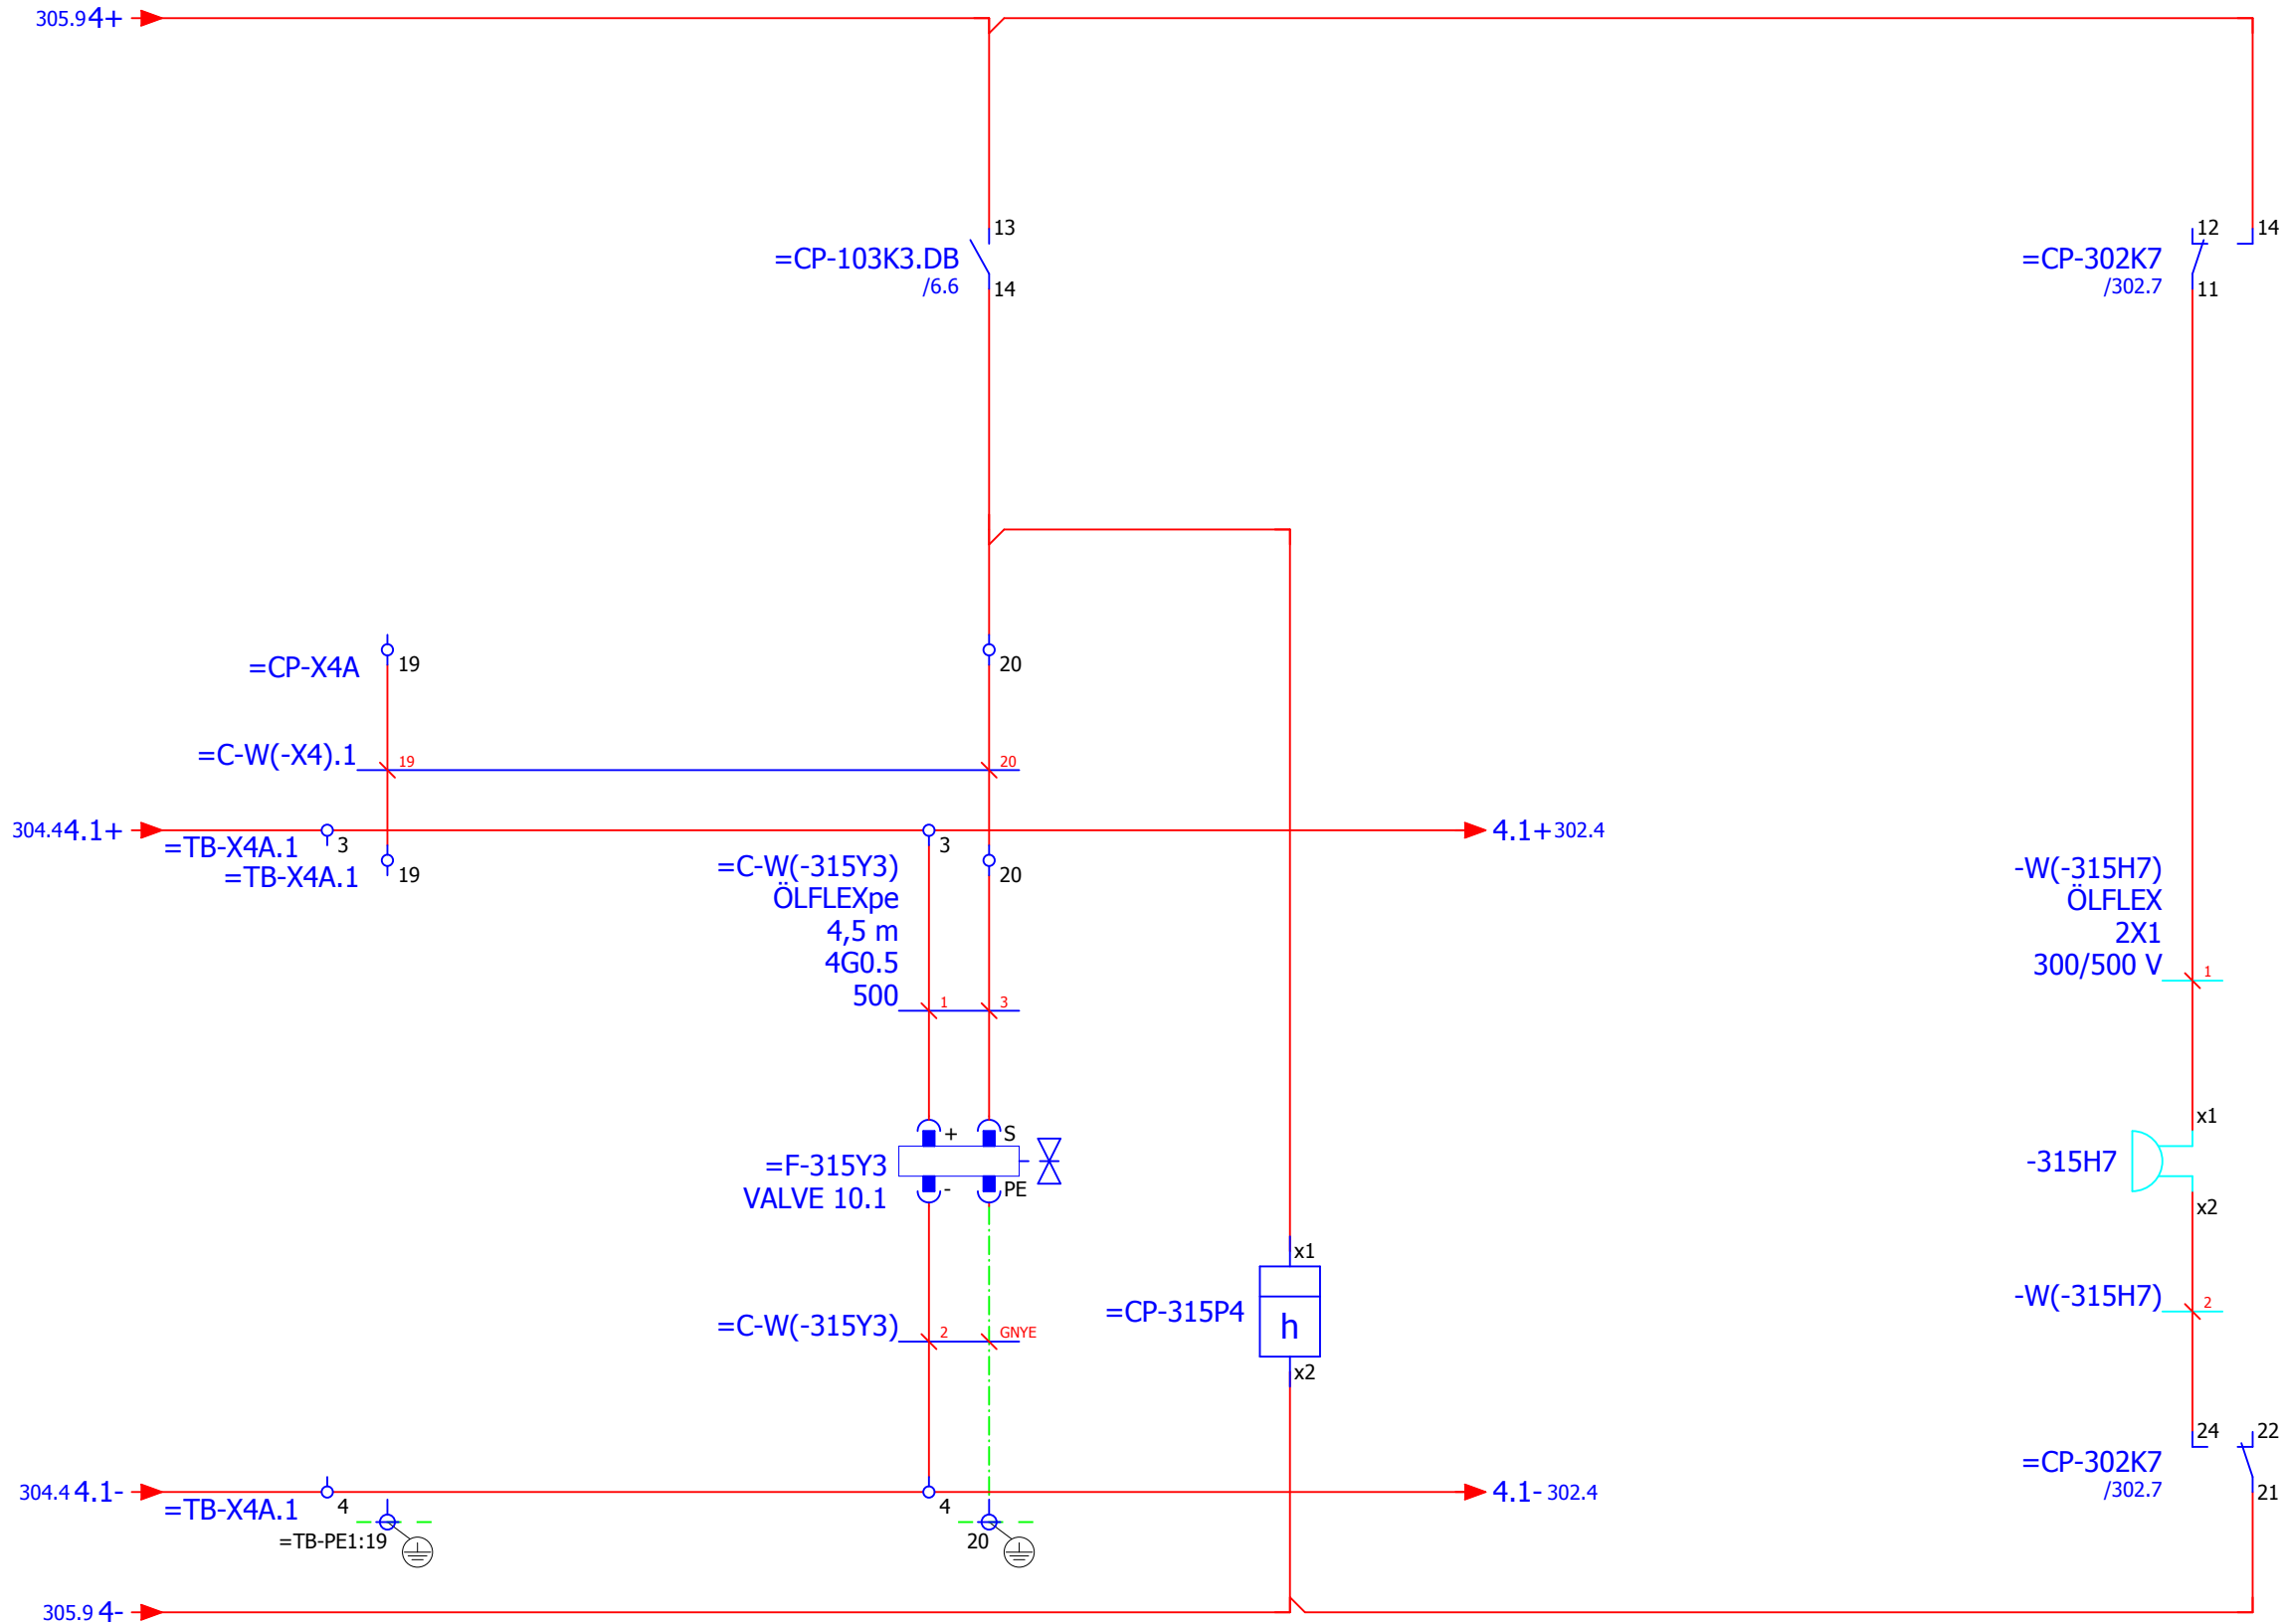

PROPORTIONAL
PRESSURE
RELEASE

WATER SUPPLY
WASHING

HOUR COUNTER

BUZZER

previous:
305



THIS DRAWING REMAINS PROPERTY OF MAREL ENTITY,
SPECIFIED ON PAGE 1 AND MAY NOT BE COPIED OR
REPRODUCED IN WHATEVER FORM WITHOUT PRIOR WRITTEN
CONSENT OF MAREL. FURTHER THIS DRAWING MAY NOT BE
DISCLOSED OR GIVEN TO ANY OTHER PARTY FOR INFORMATION
OR USE WITHOUT PRIOR WRITTEN CONSENT OF MAREL.

© MAREL 2010 ALL RIGHTS RESERVED WORLDWIDE.

www.marel.com

PROJ. TYPE: RC05xx

CUSTOMER:

COUNTRY:

PAGE DESCR.: CONTROL CURRENT 24VDC / DIGITAL OUTPUTS

+RC05xx GENERAL PRESS

PAGE REV. DATE:

2013.08.05

PAGE REV.

PROJ. REV.

01

D

SCALE:
1: 1

PAGE:

315

DWG. NO.


9667279

SHEET / TOTAL :

(37 / 117)


next:
401

SETTINGS: FACTORY DEFAULT

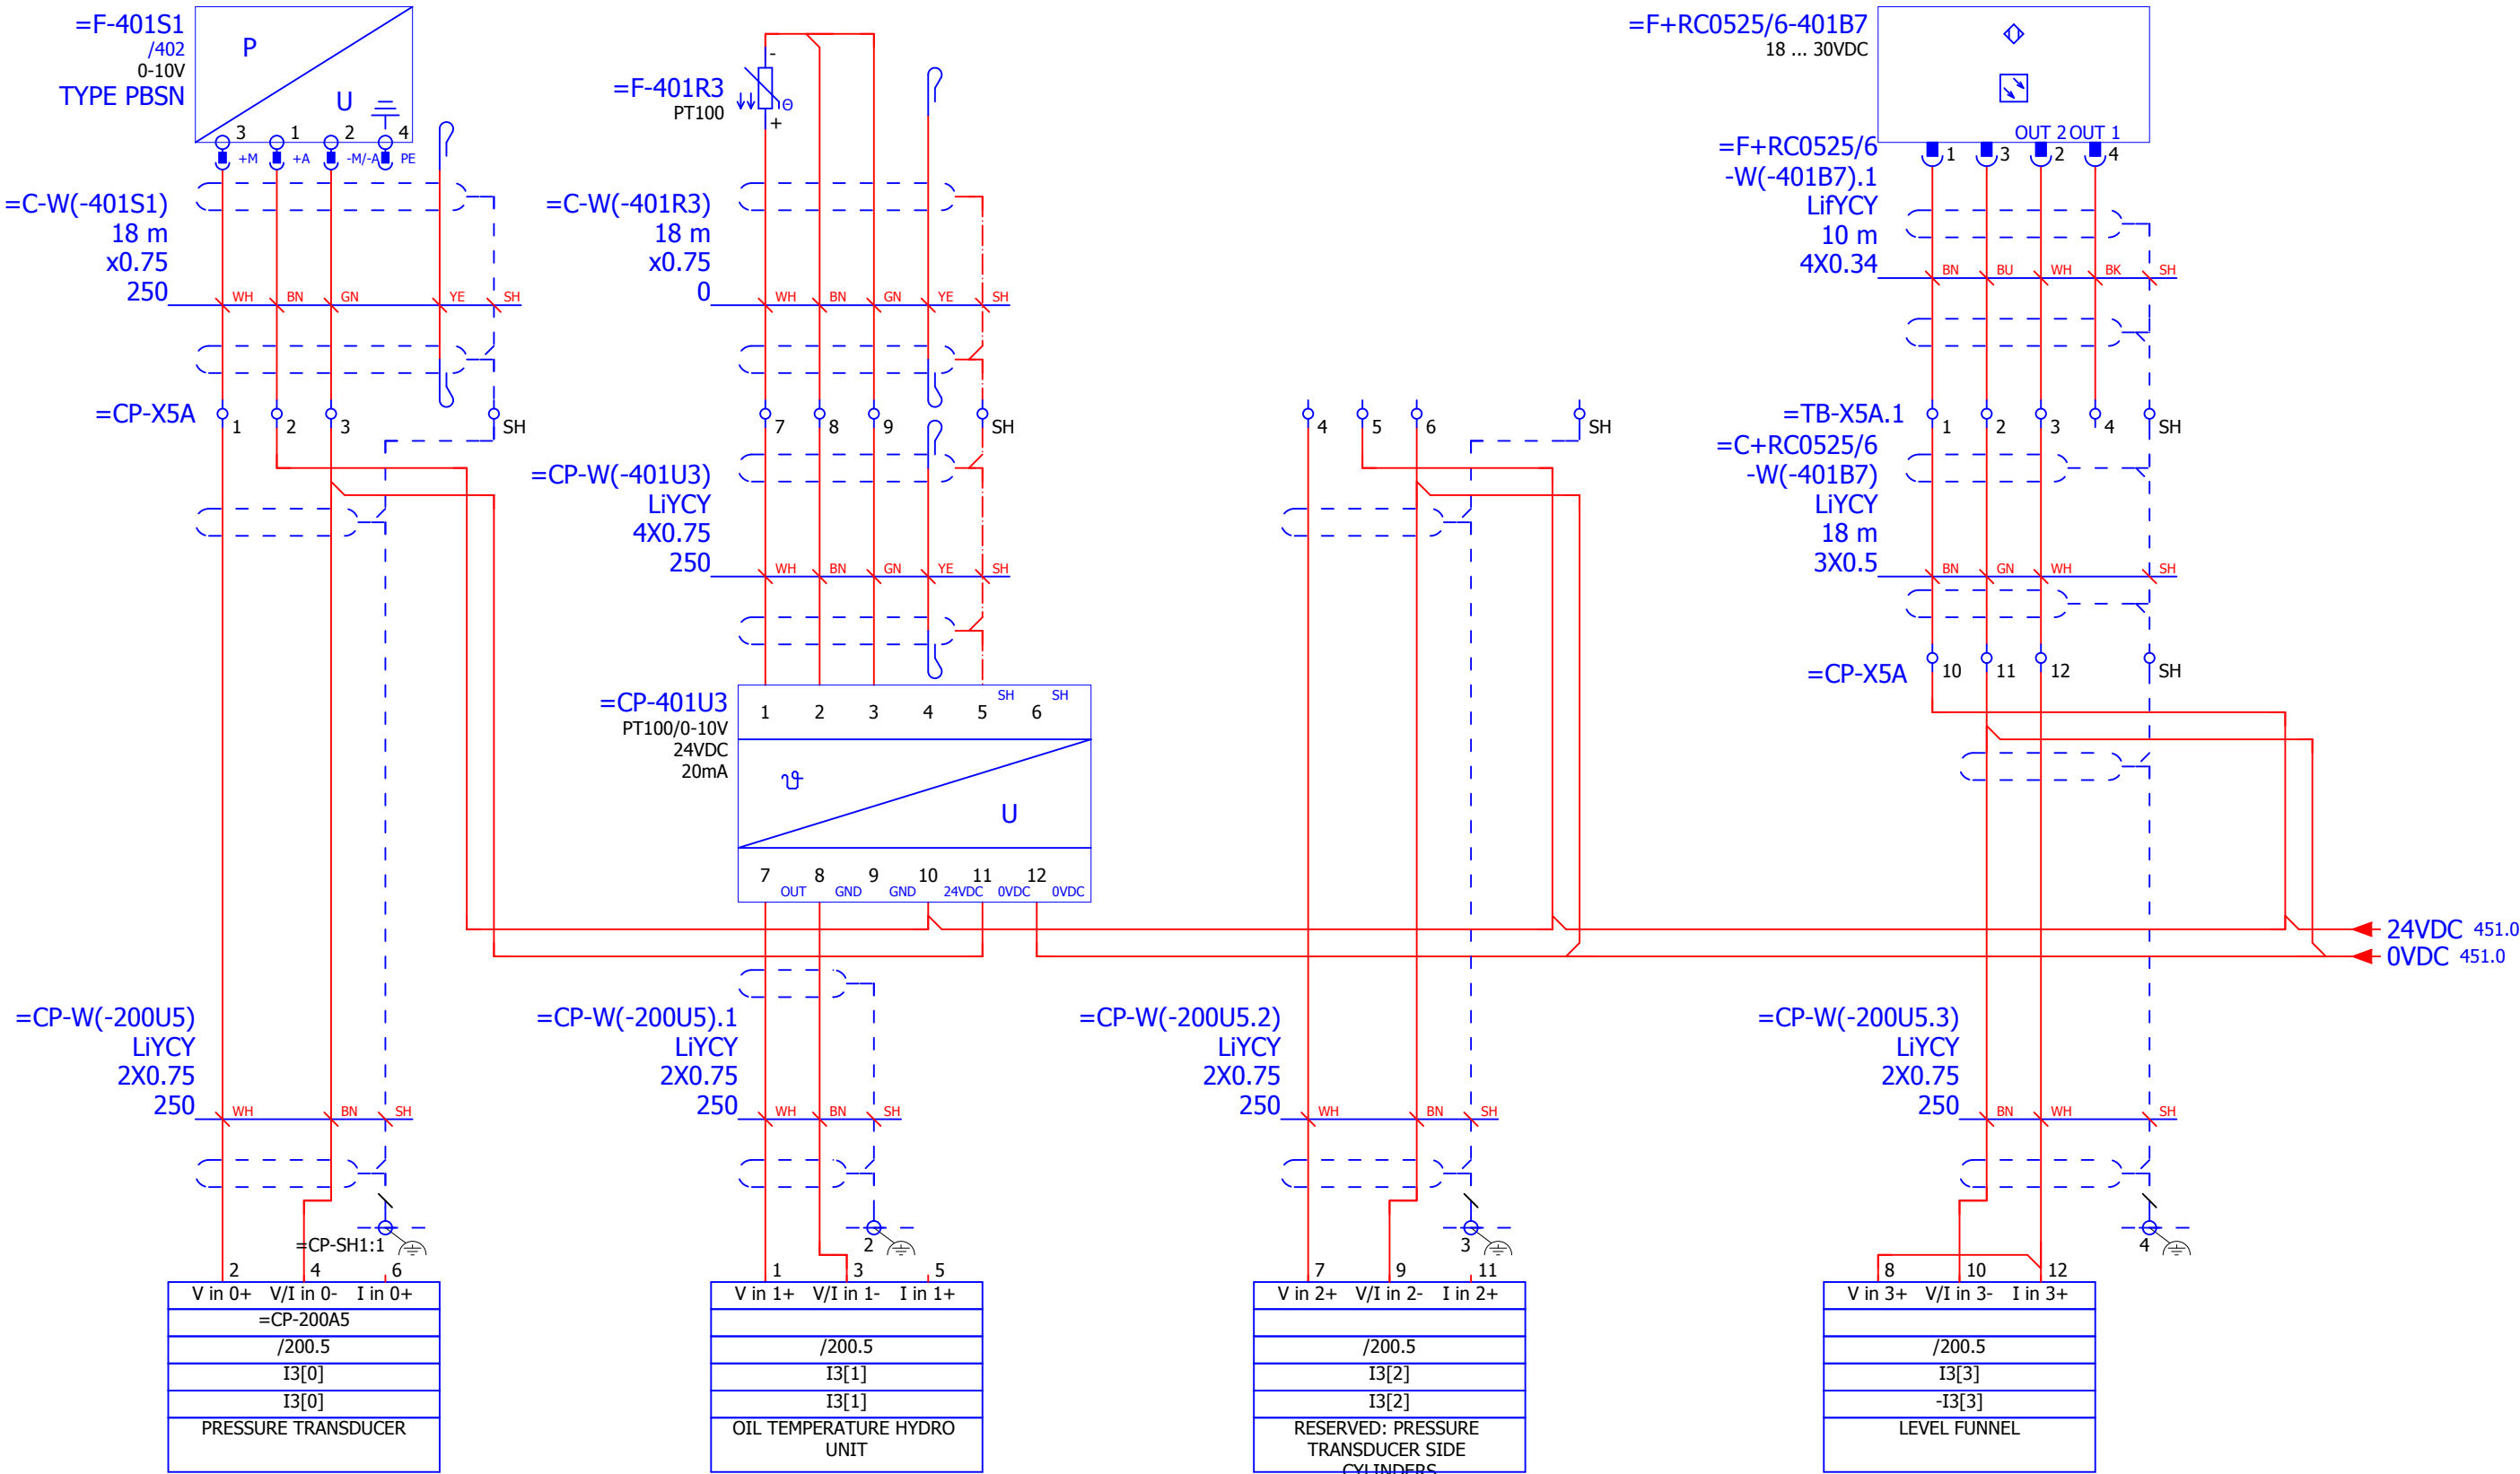

previous:
315

next:
402




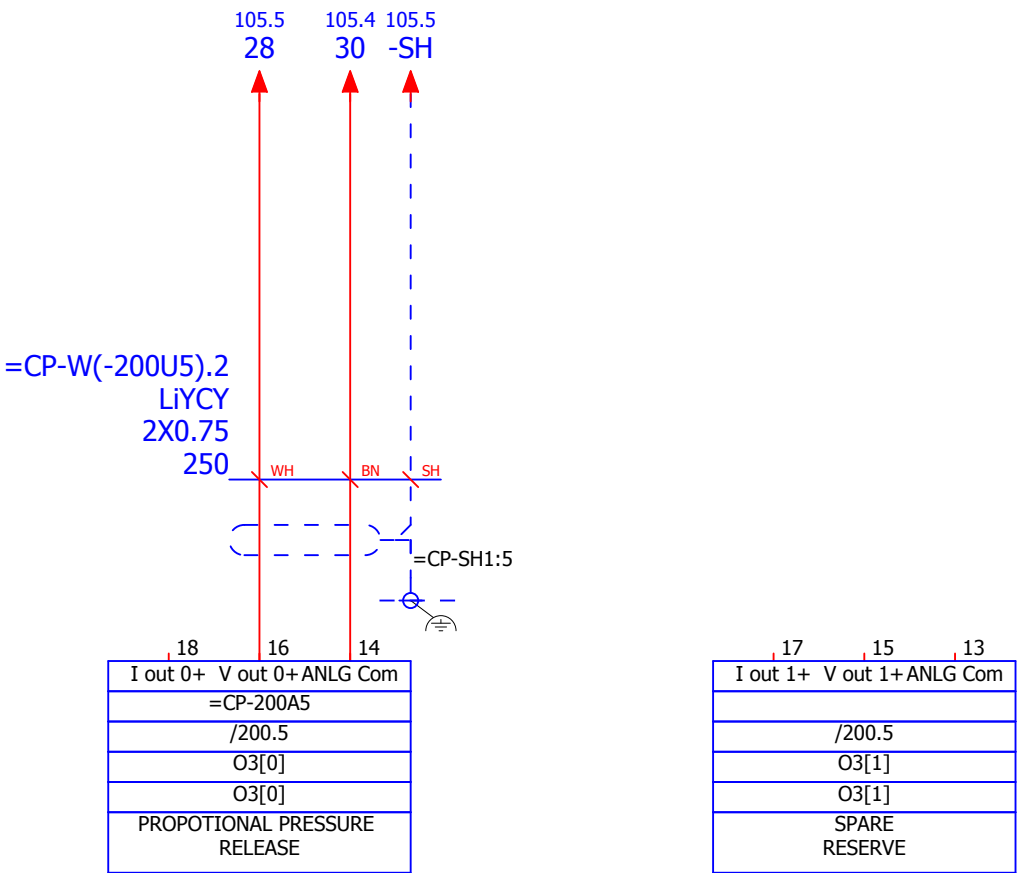


-4E0

REAR SIDE

Left
side view
400.0


FRONT VIEW

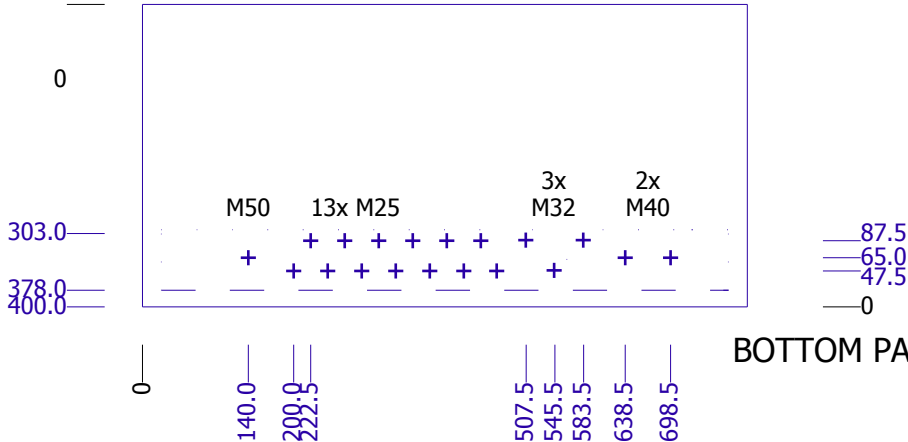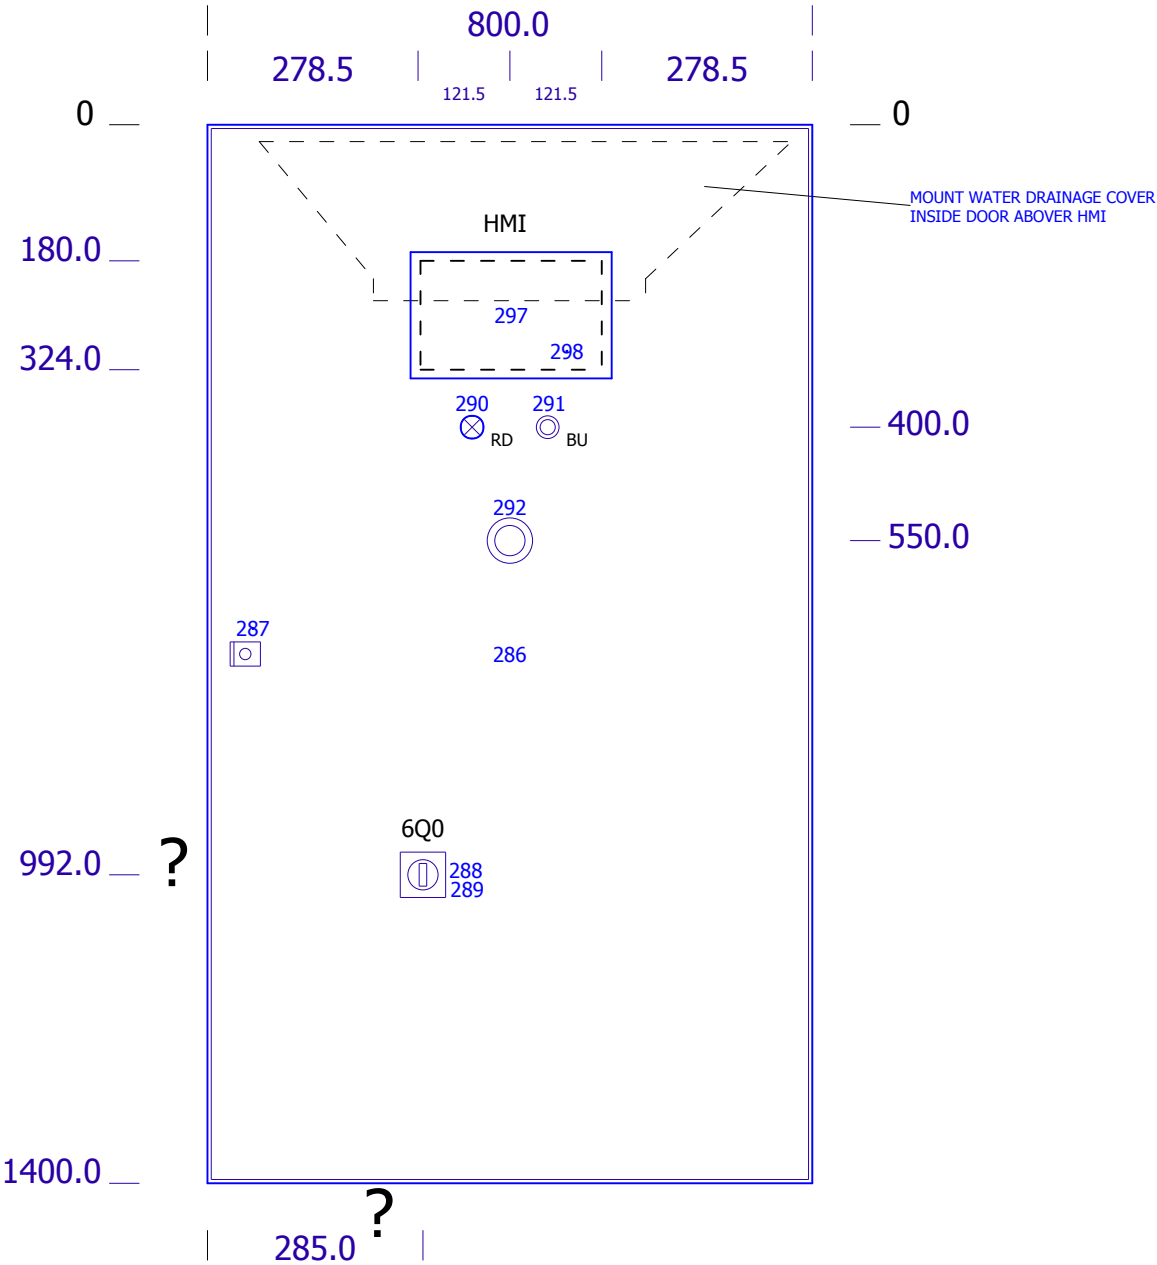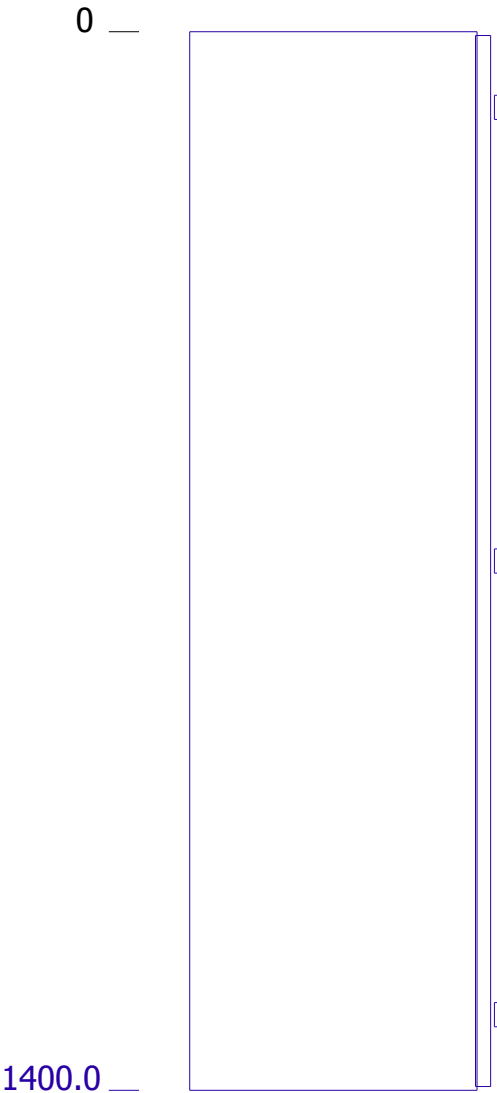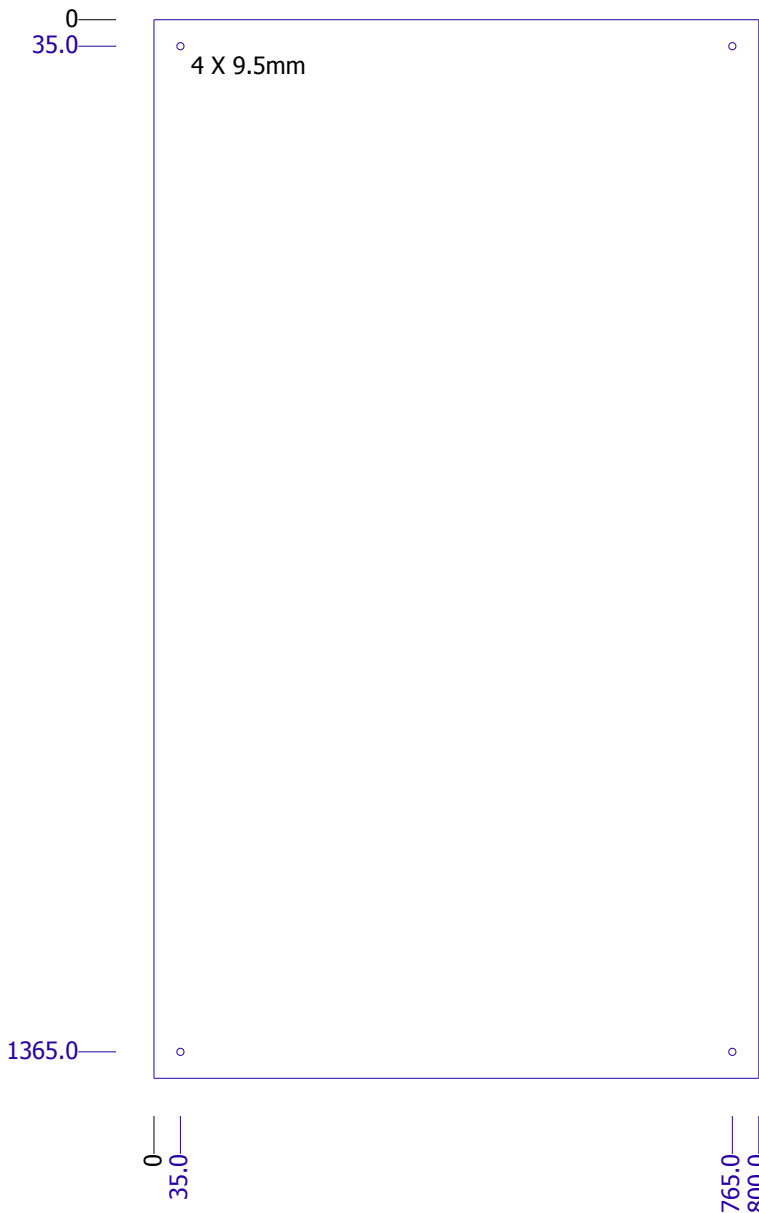


BOTTOM PART

previous:
=/451

next:
512

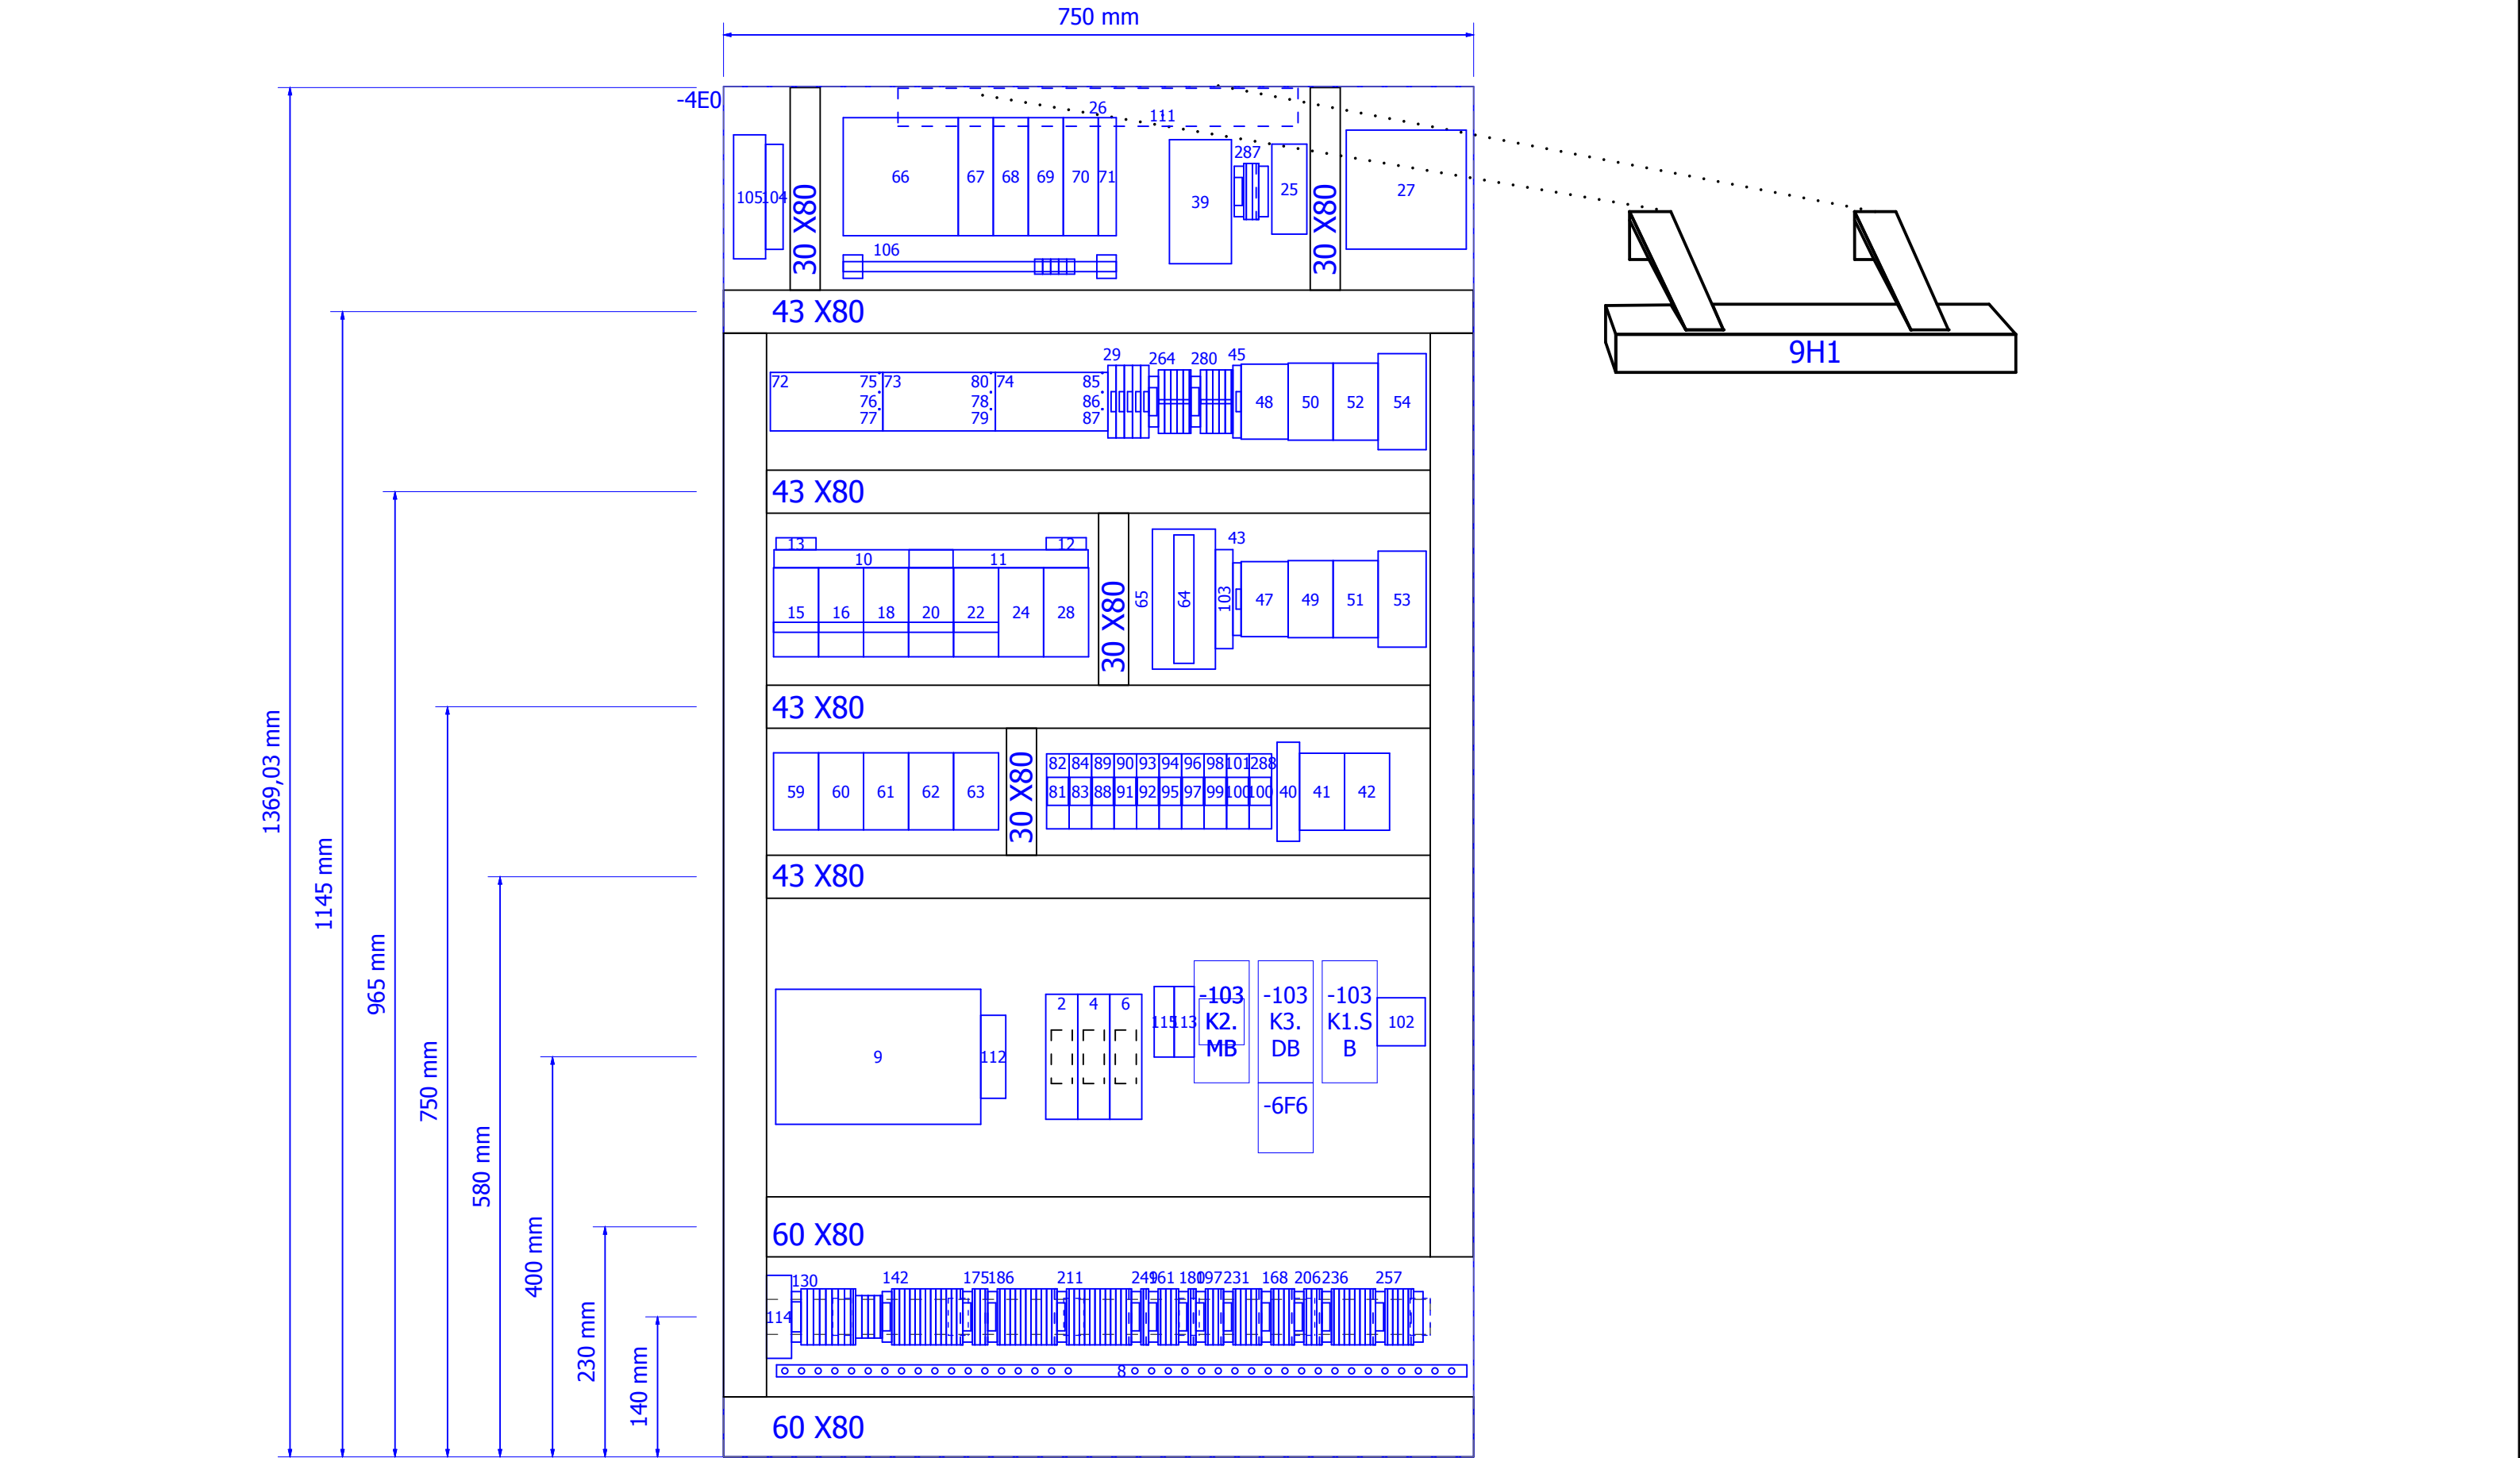

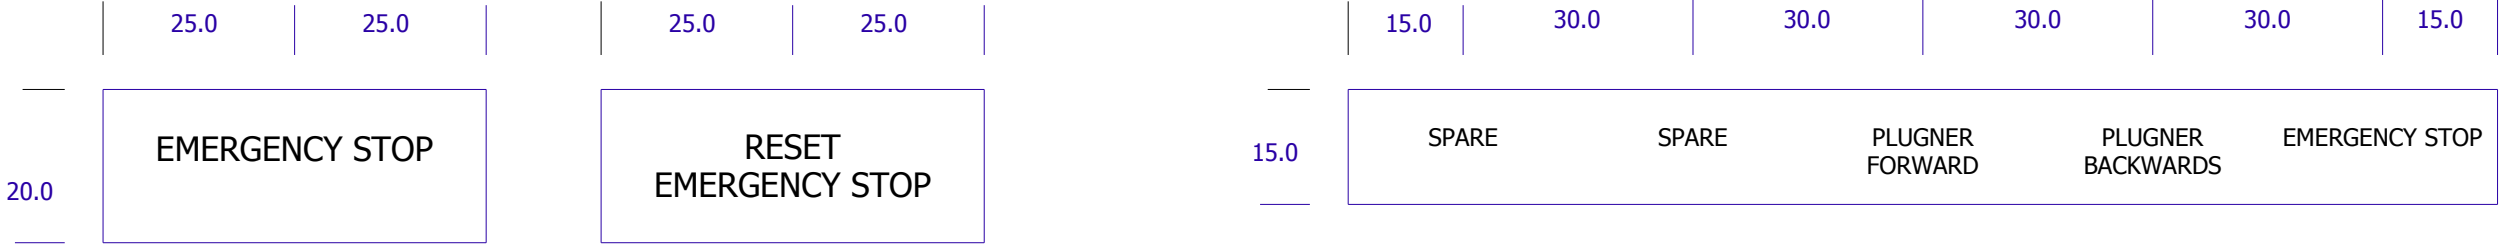

White plates
black text
measure in mm.

ENCLOSURE LEGEND

=CP+RC05xx-4E0

ITEM NO.	DEVICE TAG
2	=CP+RC05xx-6F5
4	=CP+RC05xx-6F5
6	=CP+RC05xx-6F5
8	=CP+RC05xx-6PE2
9	=CP+RC05xx-6Q1
10	=CP+RC05xx-6X6
11	=CP+RC05xx-6X6
12	=CP+RC05xx-6X6
13	=CP+RC05xx-6X6
14	=CP+RC05xx-7F3
15	=CP+RC05xx-7F3
16	=CP+RC05xx-7F5
17	=CP+RC05xx-7F5
18	=CP+RC05xx-8F3
19	=CP+RC05xx-8F3
20	=CP+RC05xx-8F5
21	=CP+RC05xx-8F5
22	=CP+RC05xx-8F7
23	=CP+RC05xx-8F7
24	=CP+RC05xx-9F2
25	=CP+RC05xx-9F2.1
26	=CP+RC05xx-9H1
27	=CP+RC05xx-9T2
28	=CP+RC05xx-10F1
29	=CP+RC05xx-10F1.2
30	=CP+RC05xx-10F1.2
31	=CP+RC05xx-10F2

32	=CP+RC05xx-10F2
33	=CP+RC05xx-10F2.1
34	=CP+RC05xx-10F2.1
35	=CP+RC05xx-10F3
36	=CP+RC05xx-10F3
37	=CP+RC05xx-10F5
38	=CP+RC05xx-10F5
39	=CP+RC05xx-10G1
40	=CP+RC05xx-100K0
41	=CP+RC05xx-100K6
42	=CP+RC05xx-100K7
43	=CP+RC05xx-102F1
44	=CP+RC05xx-102F1
45	=CP+RC05xx-102F1.1
46	=CP+RC05xx-102F1.1
47	=CP+RC05xx-102K1
48	=CP+RC05xx-102K1.1
49	=CP+RC05xx-102K2
50	=CP+RC05xx-102K2.1
51	=CP+RC05xx-102K3
52	=CP+RC05xx-102K3.1
53	=CP+RC05xx-102U3
54	=CP+RC05xx-102U3.1
59	=CP+RC05xx-103K5
60	=CP+RC05xx-103K6
61	=CP+RC05xx-103K7
62	=CP+RC05xx-103K8
63	=CP+RC05xx-103K9
64	=CP+RC05xx-105U4
65	=CP+RC05xx-105U4

66	=CP+RC05xx-200A1
67	=CP+RC05xx-200A3
68	=CP+RC05xx-200A4
69	=CP+RC05xx-200A5
70	=CP+RC05xx-200A6
71	=CP+RC05xx-200A7
72	=CP+RC05xx-200X2
73	=CP+RC05xx-200X3
74	=CP+RC05xx-200X6
75	=CP+RC05xx-201W0
76	=CP+RC05xx-201W0
77	=CP+RC05xx-201W0
78	=CP+RC05xx-205W0
79	=CP+RC05xx-205W0
80	=CP+RC05xx-205W0
81	=CP+RC05xx-301K4
82	=CP+RC05xx-301K4
83	=CP+RC05xx-301K8
84	=CP+RC05xx-301K8
85	=CP+RC05xx-301W0
86	=CP+RC05xx-301W0
87	=CP+RC05xx-301W0
88	=CP+RC05xx-302K7
89	=CP+RC05xx-302K7
90	=CP+RC05xx-302K8
91	=CP+RC05xx-302K8
92	=CP+RC05xx-303K1
93	=CP+RC05xx-303K1
94	=CP+RC05xx-303K3
95	=CP+RC05xx-303K3

96	=CP+RC05xx-304K6
97	=CP+RC05xx-304K6
98	=CP+RC05xx-304K7
99	=CP+RC05xx-304K7
100	=CP+RC05xx-304K8
100	=CP+RC05xx-305K1
101	=CP+RC05xx-304K8
102	=CP+RC05xx-315P4
103	=CP+RC05xx-401U3
104	=CP+RC05xx-451F1
105	=CP+RC05xx-451G1
106	=CP+RC05xx-SH1
107	=CP+RC05xx-SH1
108	=CP+RC05xx-SH1
109	=CP+RC05xx-SH1
109	=CP+RC05xx-SH1
109	=CP+RC05xx-SH1
109	=CP+RC05xx-SH1
110	=CP+RC05xx-SH1
111	=CP+RC05xx-W(-9H1)
118	=CP+RC05xx-X1A
119	=CP+RC05xx-X1A
120	=CP+RC05xx-X1A
121	=CP+RC05xx-X1A
123	=CP+RC05xx-X1A
124	=CP+RC05xx-X1A
125	=CP+RC05xx-X1A
128	=CP+RC05xx-X1A
130	=CP+RC05xx-X1A
137	=CP+RC05xx-X1A

ENCLOSURE LEGEND

=CP+RC05xx-4E0

ITEM NO.	DEVICE TAG
138	=CP+RC05xx-X1A
141	=CP+RC05xx-X2A
142	=CP+RC05xx-X2A
144	=CP+RC05xx-X2A
154	=CP+RC05xx-X2A
156	=CP+RC05xx-X2B
157	=CP+RC05xx-X2B
161	=CP+RC05xx-X2B
162	=CP+RC05xx-X2B
163	=CP+RC05xx-X2C
164	=CP+RC05xx-X2C
168	=CP+RC05xx-X2C
169	=CP+RC05xx-X2C
171	=CP+RC05xx-X2D
172	=CP+RC05xx-X2D
175	=CP+RC05xx-X2D
176	=CP+RC05xx-X2D
178	=CP+RC05xx-X2E
179	=CP+RC05xx-X2E
180	=CP+RC05xx-X2E
181	=CP+RC05xx-X2E
184	=CP+RC05xx-X3A
185	=CP+RC05xx-X3A
186	=CP+RC05xx-X3A
187	=CP+RC05xx-X3A
197	=CP+RC05xx-X3B
198	=CP+RC05xx-X3B





199	=CP+RC05xx-X3B
203	=CP+RC05xx-X3B
205	=CP+RC05xx-X3C
206	=CP+RC05xx-X3C
207	=CP+RC05xx-X3C
210	=CP+RC05xx-X3C
211	=CP+RC05xx-X4A
212	=CP+RC05xx-X4A
221	=CP+RC05xx-X4A
222	=CP+RC05xx-X4A
231	=CP+RC05xx-X4B
232	=CP+RC05xx-X4B
233	=CP+RC05xx-X4B
234	=CP+RC05xx-X4B
236	=CP+RC05xx-X5A
237	=CP+RC05xx-X5A
238	=CP+RC05xx-X5A
239	=CP+RC05xx-X5A
248	=CP+RC05xx-X6A
249	=CP+RC05xx-X6A
250	=CP+RC05xx-X6A
252	=CP+RC05xx-X6A
257	=CP+RC05xx-X7A
258	=CP+RC05xx-X7A
259	=CP+RC05xx-X7A
260	=CP+RC05xx-X7A
261	=CP+RC05xx-X7A
264	=CP+RC05xx-X81+
265	=CP+RC05xx-X81+
266	=CP+RC05xx-X81+

267	=CP+RC05xx-X81+
272	=CP+RC05xx-X81-
278	=CP+RC05xx-X81-
279	=CP+RC05xx-X81-
280	=CP+RC05xx-X81-
281	=CP+RC05xx-X91
282	=CP+RC05xx-X91
285	=CP+RC05xx-X91
286	=CP+RC05xx-X91
287	=CP+RC05xx-X91
288	=CP+RC05xx-305K1
286	=CP+RC05xx-4E0
287	=CP+RC05xx-4E0
288	=CP+RC05xx-6Q1
289	=CP+RC05xx-6Q1
290	=CP+RC05xx-100H7
291	=CP+RC05xx-100S4
292	=CP+RC05xx-101S2
293	=CP+RC05xx-101S2
294	=CP+RC05xx-101S2
295	=CP+RC05xx-101S2
296	=CP+RC05xx-101S2
297	=CP+RC05xx-451H4
298	=CP+RC05xx-451H4


ENCLOSURE LEGEND

=CB+RC05xx-4E4

ITEM NO.	DEVICE TAG
1	=CB+RC05xx-4E4
2	=CB+RC05xx-4X3.1
3	=CB+RC05xx-4X3.1
4	=CB+RC05xx-101S5
5	=CB+RC05xx-101S5
6	=CB+RC05xx-101S5
7	=CB+RC05xx-101S5
8	=CB+RC05xx-203S1
9	=CB+RC05xx-203S1
10	=CB+RC05xx-203S2
11	=CB+RC05xx-203S2
12	=CB+RC05xx-203S3
13	=CB+RC05xx-203S3
14	=CB+RC05xx-203S4
15	=CB+RC05xx-203S4
16	=CB+RC05xx-W(-4E4)
17	=CB+RC05xx-W(-4E4)
18	=CB+RC05xx-W(-4E4)
19	=CB+RC05xx-W(-4E4)
20	=CB+RC05xx-W(-4E4)

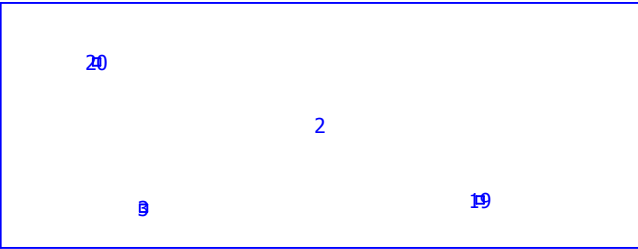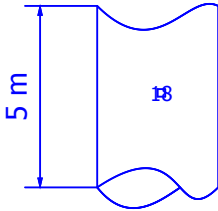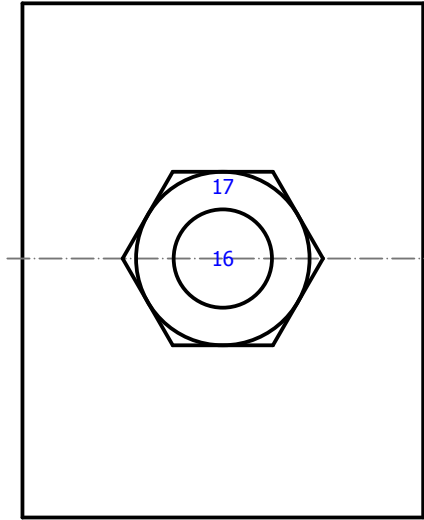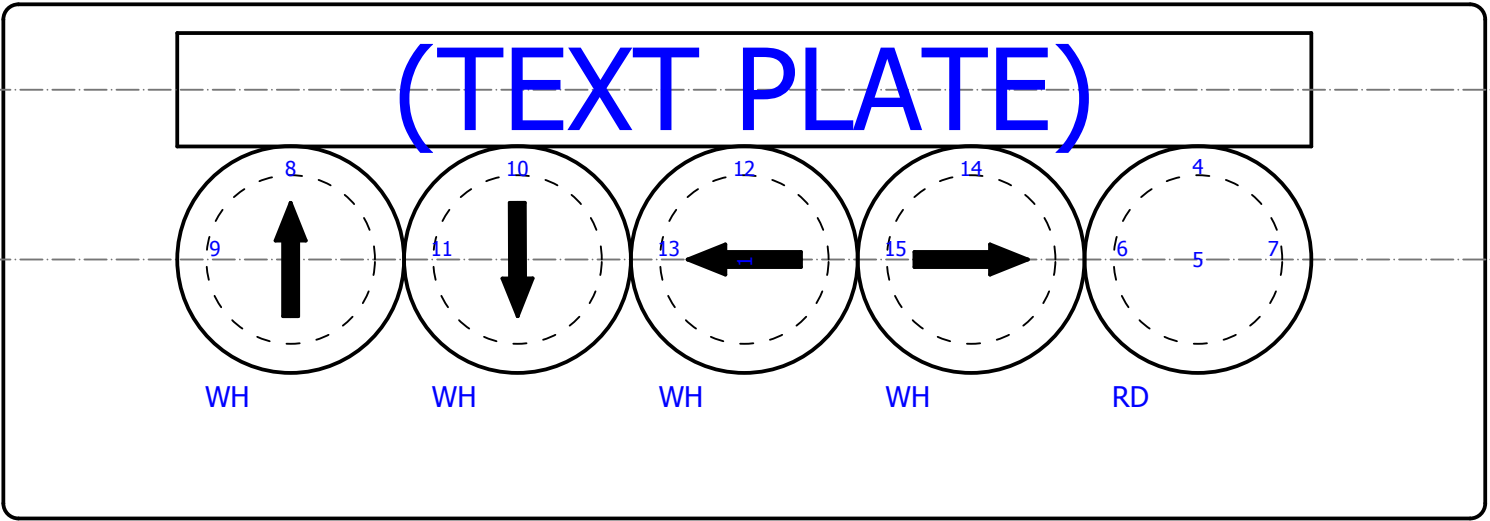

+RC05xx-4E0.1

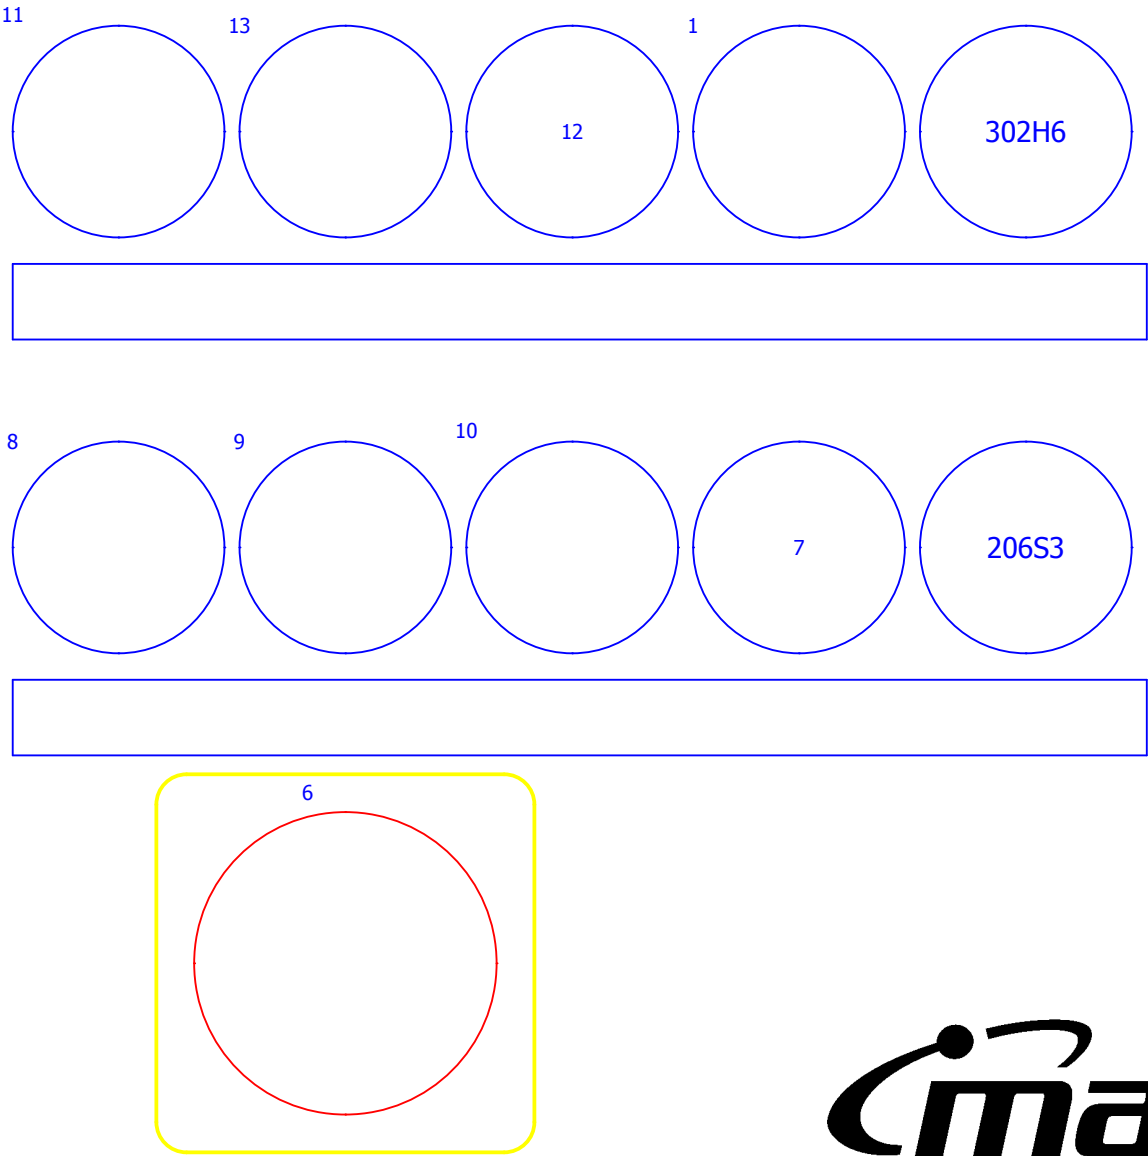

EL111450

ENCLOSURE LEGEND

=CB+RC05xx-4E0.1

ITEM NO.	DEVICE TAG
1	=CB+RC05xx-100H8
2	=CB+RC05xx-101S3
3	=CB+RC05xx-101S3
4	=CB+RC05xx-101S3
5	=CB+RC05xx-101S3
6	=CB+RC05xx-101S3
7	=CB+RC05xx-201S8
8	=CB+RC05xx-202S1
9	=CB+RC05xx-202S2
10	=CB+RC05xx-202S3
11	=CB+RC05xx-301H1
12	=CB+RC05xx-301H2
13	=CB+RC05xx-301H3
14	=CB+RC05xx-X2A.2
15	=CB+RC05xx-X2A.2
23	=CB+RC05xx-X3A.2
24	=CB+RC05xx-X3A.2
27	=CB+RC05xx-X3A.2
28	=CB+RC05xx-X3A.2
31	=CB+RC05xx-X4A.2
32	=CB+RC05xx-X4A.2
33	=CB+RC05xx-X4A.2
34	=CB+RC05xx-X4A.2
39	=CB+RC05xx-X4A.2
40	=CB+RC0525/6-302H6
41	=CB+RC0525/6-206S3


ENCLOSURE LEGEND

=TB+RC05xx-4E1

ITEM NO.	DEVICE TAG
1	=TB+RC05xx-4E1
2	=TB+RC05xx-4E1
3	=TB+RC05xx-4E1
4	=TB+RC05xx-4E1
5	=TB+RC05xx-4E1
6	=TB+RC05xx-4E1
7	=TB+RC05xx-4E1
8	=TB+RC05xx-4E1
9	=TB+RC05xx-4E1
10	=TB+RC05xx-4E1
11	=TB+RC05xx-4E1
12	=TB+RC05xx-4E1
13	=TB+RC05xx-X2A.1
14	=TB+RC05xx-X2A.1
15	=TB+RC05xx-X2A.1
32	=TB+RC05xx-X2A.1
34	=TB+RC05xx-X3A.1
35	=TB+RC05xx-X3A.1
46	=TB+RC05xx-X3A.1
47	=TB+RC05xx-X3A.1
50	=TB+RC05xx-X3A.1
51	=TB+RC05xx-X3A.1
66	=TB+RC05xx-X4A.1
67	=TB+RC05xx-X4A.1
69	=TB+RC05xx-X4A.1
72	=TB+RC05xx-X4A.1
73	=TB+RC05xx-X4A.1

-4E1
TB01




74	=TB+RC05xx-X4A.1
76	=TB+RC05xx-4E1
80	=TB+RC05xx-X5A.1
81	=TB+RC05xx-X5A.1
82	=TB+RC05xx-X5A.1
83	=TB+RC05xx-X5A.1
86	=TB+RC05xx-X5A.1

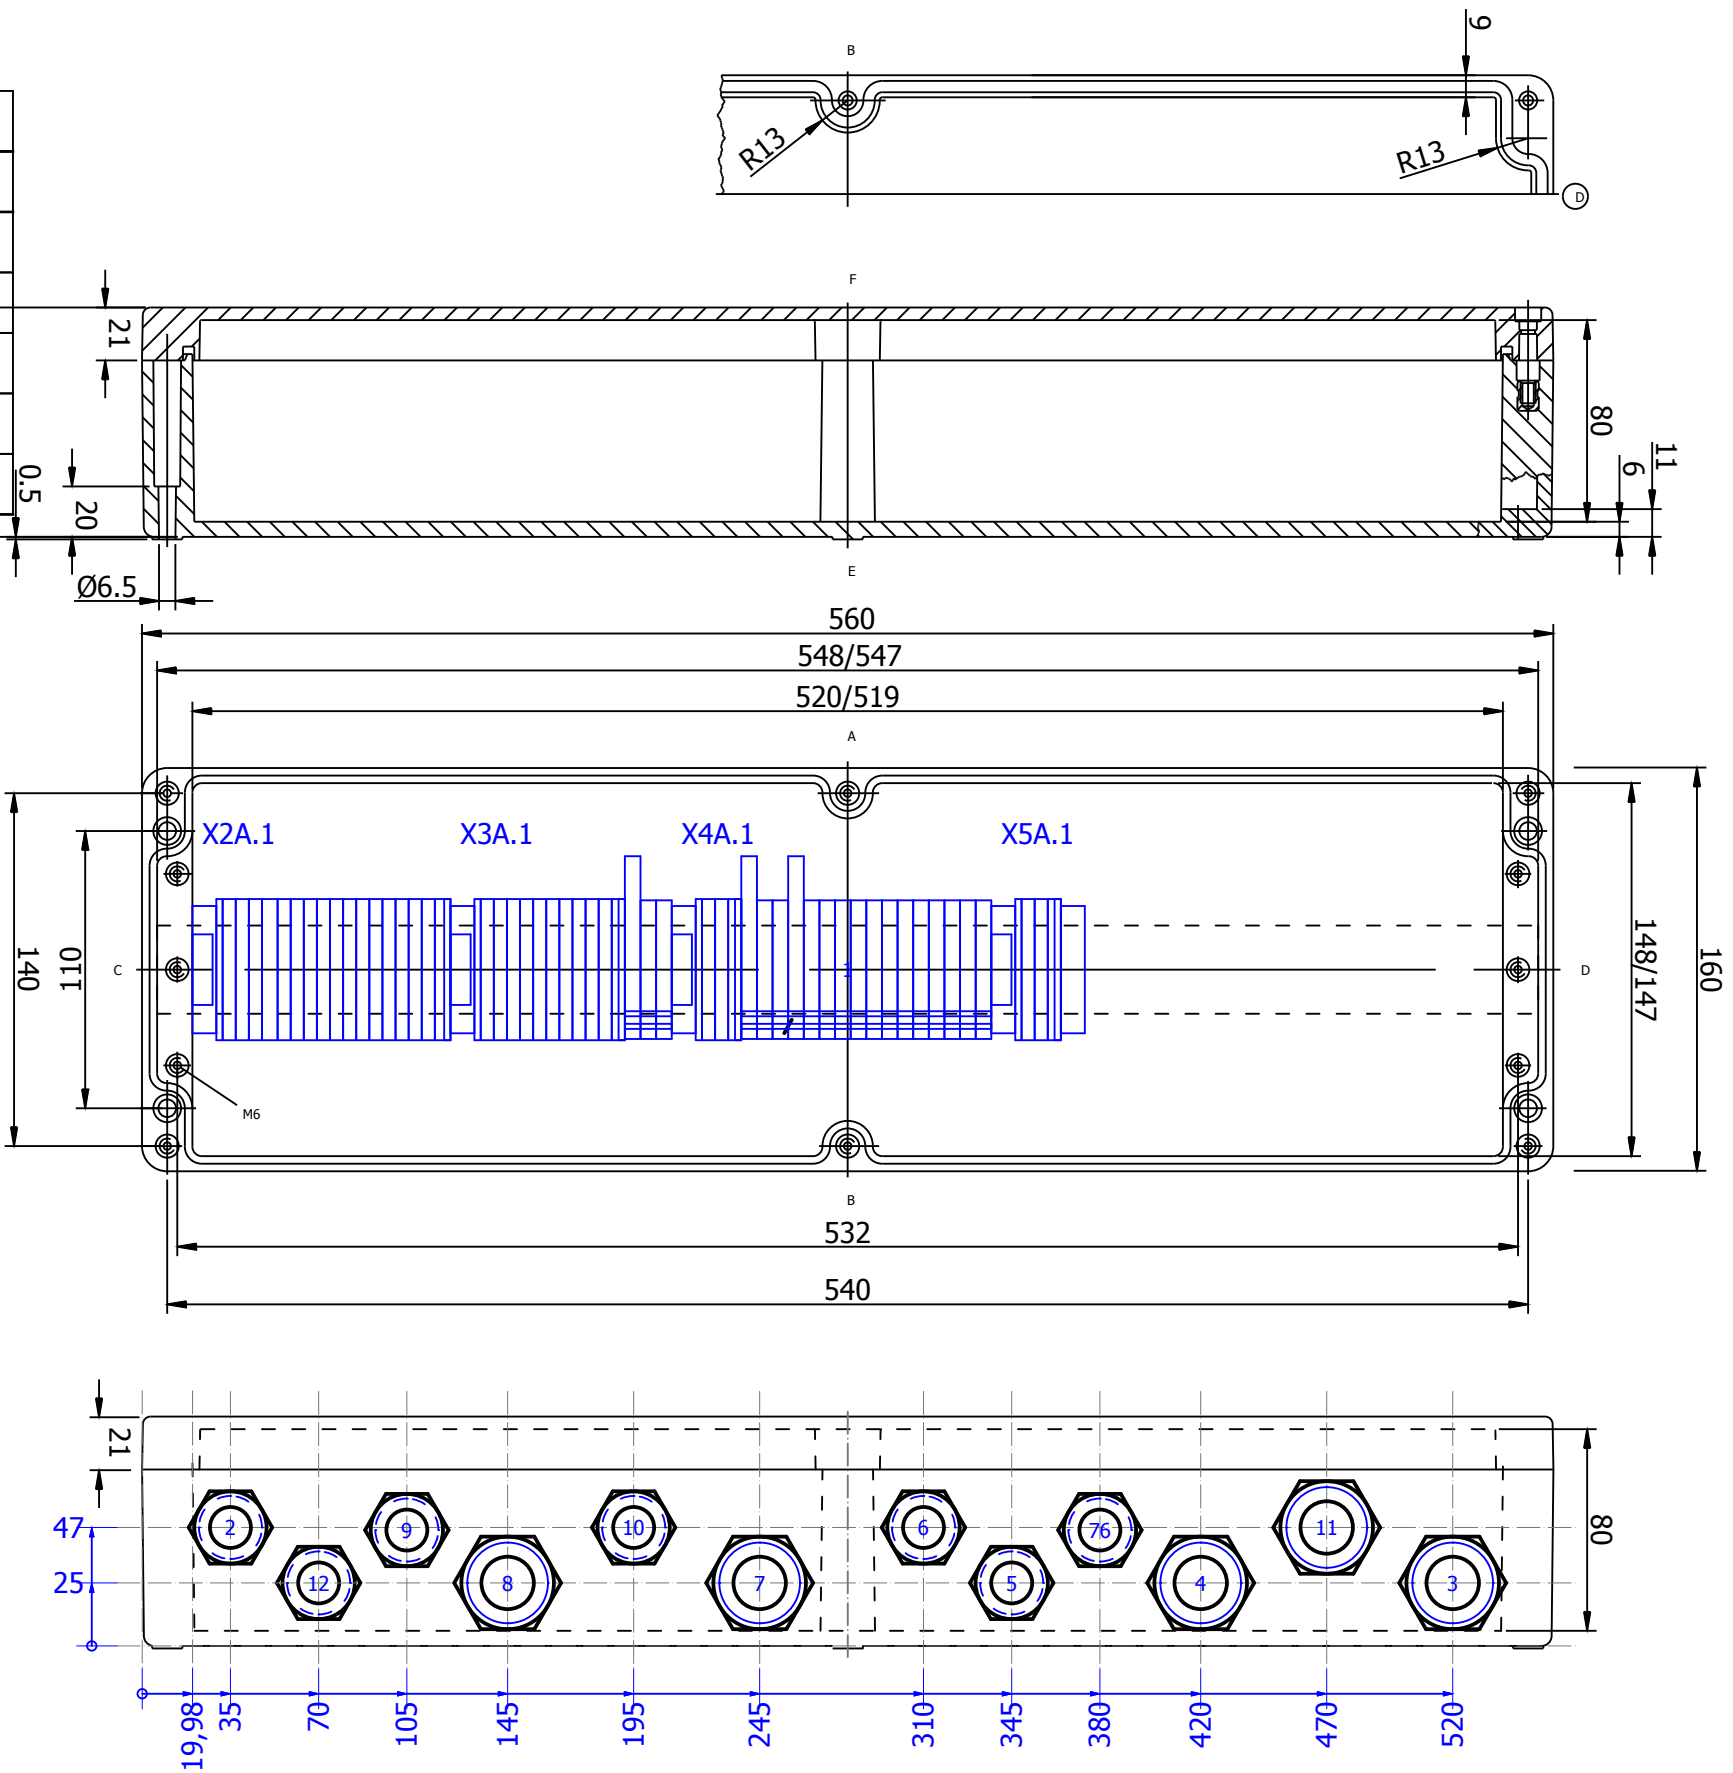

ENCLOSURE LEGEND

=TB+RC05xx-4E2

ITEM	DEVICE TAG	PART NUMBER	TYPE NUMBER
1	=TB+RC05xx-4E2	095700039	ROSE .02.12 22 09
2	=TB+RC05xx-X2A.3	9559470	PHO .E/UK
3	=TB+RC05xx-X2A.3	9559630	PHO .KLM
4	=TB+RC05xx-X2A.3	9559551	PHO .DG-UKK 3/5
14	=TB+RC05xx-X2A.3	9559548	PHO .DP-UKK 3/5
15	=TB+RC05xx-X3A.3	9559470	PHO .E/UK
16	=TB+RC05xx-X3A.3	9559630	PHO .KLM
23	=TB+RC05xx-X3A.3	9559470	PHO .E/UK
24	=TB+RC05xx-X3A.3	9559535	PHO .EB 10-DIK BU
25	=TB+RC05xx-X3A.3	9559534	PHO .EB 10-DIK RD
26	=TB+RC05xx-4E2	9560765	PFL .VK 23254Y
27	=TB+RC05xx-4E2	9560818	PFL .E 154/18
28	=C+RC05xx-W(-X2/3A).3	9562763	LAP .ÖLFLEX19119025G10AWG18
29	=TB+RC05xx-4E2	9560764	PFL .VK 22553Y
30	=TB+RC05xx-4E2	9560764	PFL .VK 22553Y
31	=TB+RC05xx-4E2	9560764	PFL .VK 22553Y

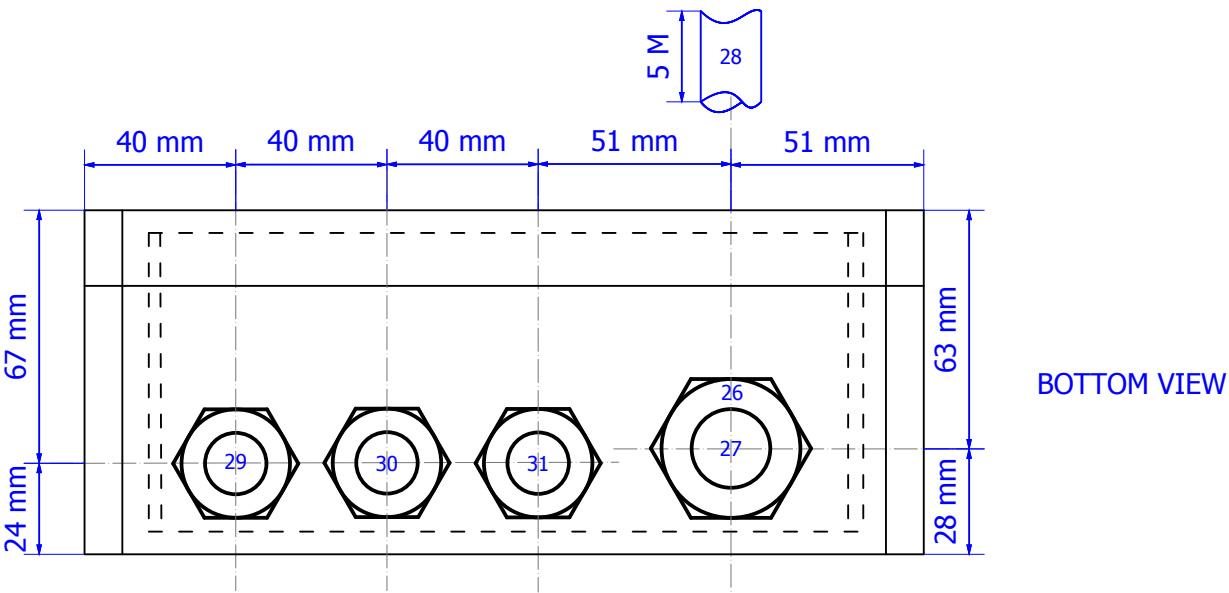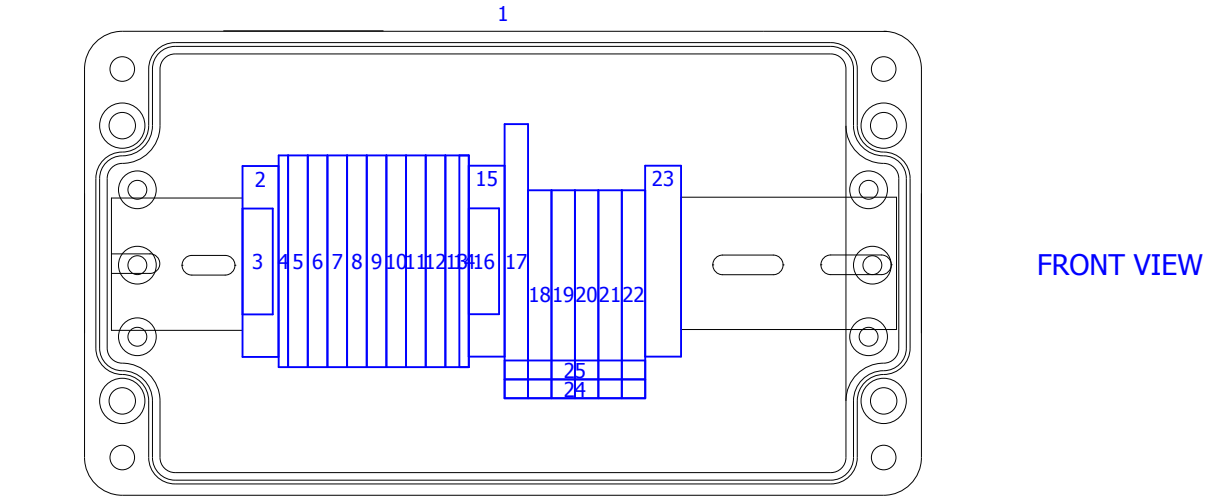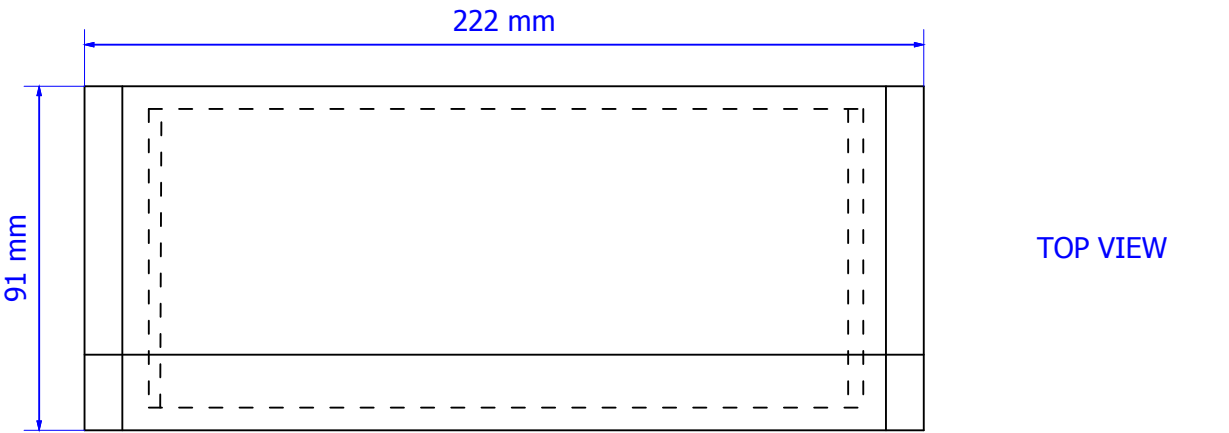

TERMINAL-STRIP OVERVIEW

[illegible]

previous:
=TB+RC05xx/543

next:
701



THIS DRAWING REMAINS PROPERTY OF MAREL ENTITY,
SPECIFIED ON PAGE 1 AND MAY NOT BE COPIED OR
REPRODUCED IN WHATEVER FORM WITHOUT PRIOR WRITTEN
CONSENT OF MAREL. FURTHER THIS DRAWING MAY NOT BE
DISCLOSED OR GIVEN TO ANY OTHER PARTY FOR INFORMATION
OR USE WITHOUT PRIOR WRITTEN CONSENT OF MAREL.

PROJ. TYPE: RC05xx

CUSTOMER:

COUNTRY:

PAGE DESCR.: **TERMINAL-STRIP OVERVIEW**
=REP **REPORTS**

PAGE REV. DATE:
2013.01.28

PAGE REV.

PRO1 REV

C	SCALE:	PAGE:	700
	1:1		

D	DWG. NO.	9667279
---	----------	---------


EDITED ON: 2013.07.11	BY:
CREATED ON: 2012.11.16	BY:

SHEET / TOTAL : (52 / 117)

TERMINAL-CONNECTION DIAGRAM

[illegible]

GENERAL REMARK:

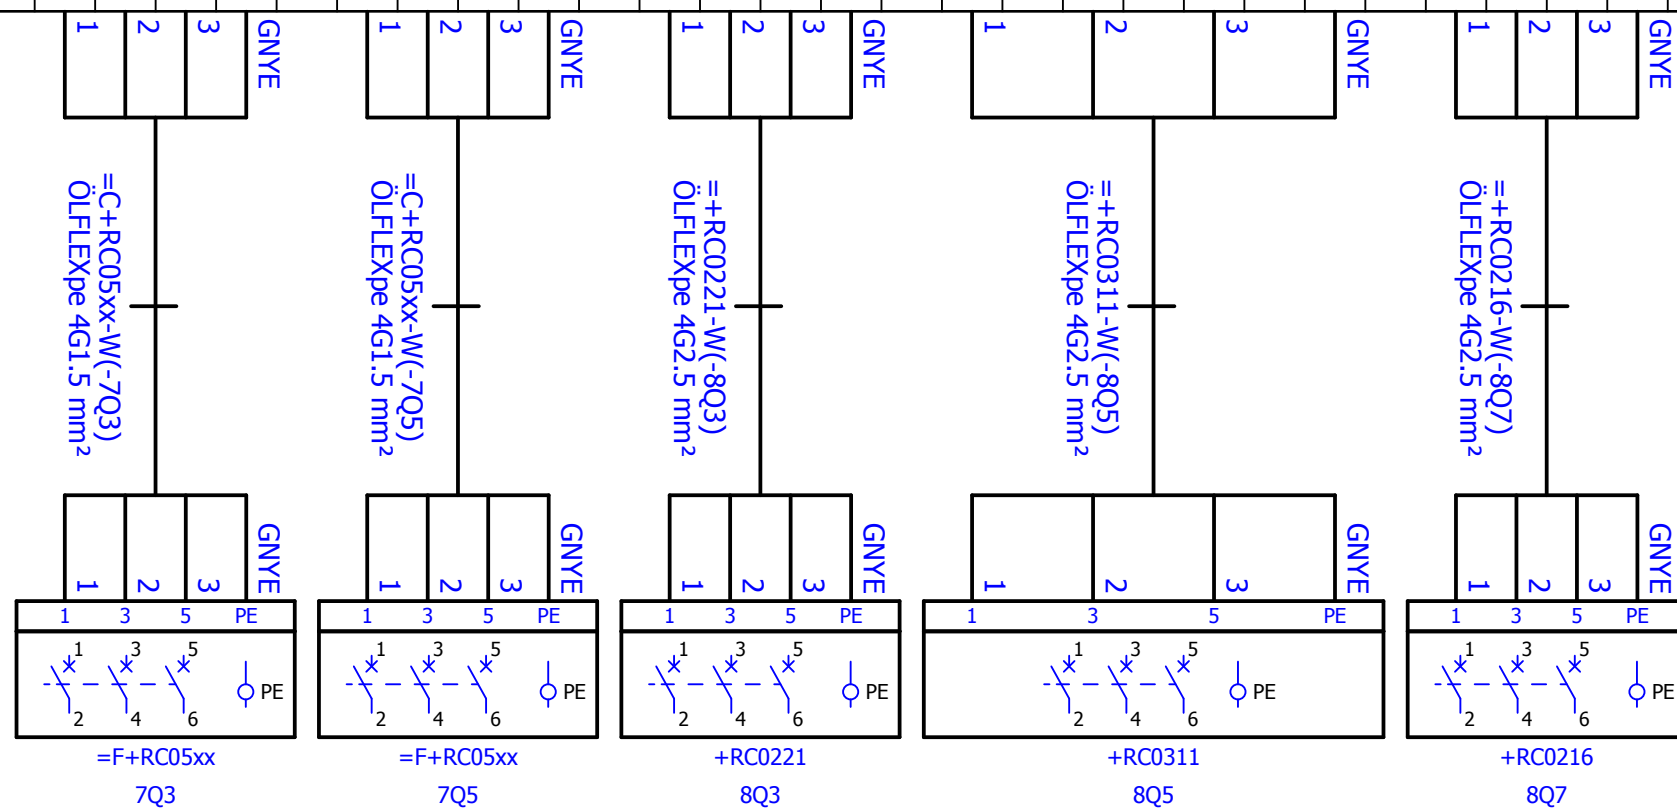

previous:
700

next:
702



THIS DRAWING REMAINS PROPERTY OF MAREL ENTITY,
SPECIFIED ON PAGE 1 AND MAY NOT BE COPIED OR
REPRODUCED IN WHATEVER FORM WITHOUT PRIOR WRITTEN
CONSENT OF MAREL. FURTHER THIS DRAWING MAY NOT BE
DISCLOSED OR GIVEN TO ANY OTHER PARTY FOR INFORMATION
OR USE WITHOUT PRIOR WRITTEN CONSENT OF MAREL.

PROJ. TYPE: RC05xx
CUSTOMER:
COUNTRY:

PAGE DESCR.: **TERMINAL-CONNECT.DIAGRAM =CP+RC05xx-X1A**
=REP **REPORTS**

PAGE REV. DATE:

PAGE REV.

07 11 PV.

SCALE: 1:1 PAGE: 701

DWG. NO. 9667279

SHEET / TOTAL : (53 / 117)


© MAREL 2010 ALL RIGHTS RESERVED WORLDWIDE.

www.marel.com

TERMINAL-CONNECTION DIAGRAM

[illegible]

GENERAL REMARK:

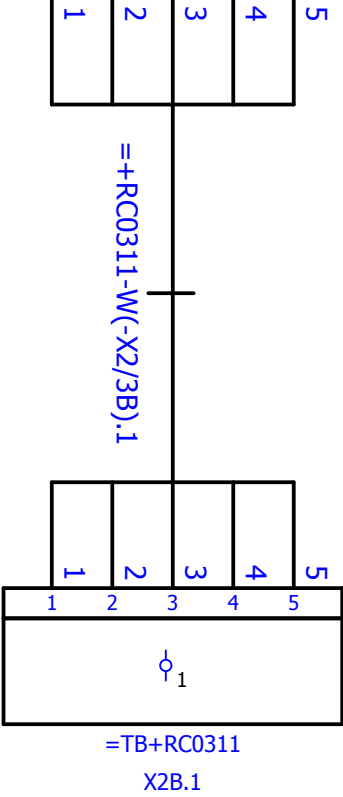

THIS DRAWING REMAINS PROPERTY OF MAREL ENTITY,
SPECIFIED ON PAGE 1 AND MAY NOT BE COPIED OR
REPRODUCED IN WHATEVER FORM WITHOUT PRIOR WRITTEN
CONSENT OF MAREL. FURTHER THIS DRAWING MAY NOT BE
DISCLOSED OR GIVEN TO ANY OTHER PARTY FOR INFORMATION
OR USE WITHOUT PRIOR WRITTEN CONSENT OF MAREL.

PROJ. TYPE: RC05xx
CUSTOMER:
COUNTRY:

PAGE DESCR.: **TERMINAL-CONNECT.DIAGRAM =CP+RC05xx-X2B**
=REP **REPORTS**

PAGE REV. DATE:	PAGE REV.	
	PROJ. REV.	D
EDITED ON: 2013.07.11	BY:	
CREATED ON: 2012.11.16	BY: JEL	

SCALE: 1:1 PAGE: 703


DWG. NO. 9667279

SHEET / TOTAL : (55 / 117)

TERMINAL-CONNECTION DIAGRAM

[illegible]


GENERAL REMARK:

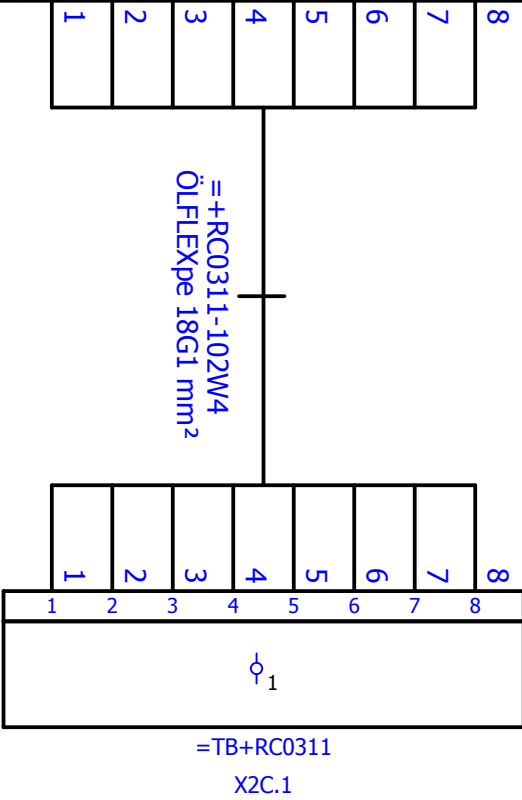

TERMINAL-CONNECTION DIAGRAM

[illegible]

GENERAL REMARK:

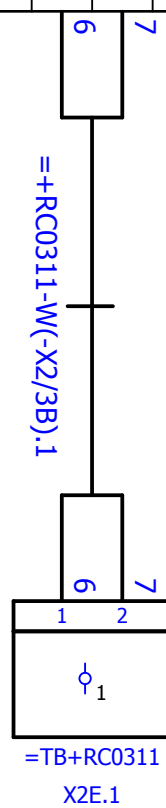

previous:
705

next:
707



THIS DRAWING REMAINS PROPERTY OF MAREL ENTITY,
SPECIFIED ON PAGE 1 AND MAY NOT BE COPIED OR
REPRODUCED IN WHATEVER FORM WITHOUT PRIOR WRITTEN
CONSENT OF MAREL. FURTHER THIS DRAWING MAY NOT BE
DISCLOSED OR GIVEN TO ANY OTHER PARTY FOR INFORMATION
OR USE WITHOUT PRIOR WRITTEN CONSENT OF MAREL.

PROJ. TYPE: RC05xx

CUSTOMER:

COUNTRY:

PAGE DESCR.: **TERMINAL-CONNECT.DIAGRAM =CP+RC05xx-X2E**
=REP **REPORTS**

PAGE REV. DATE:

PAGE REV.

PROJ REV

SCALE:
1:1

PAGE: 706

DWG. NO.

SHEET / TOTAL : (58 / 117)

© MAREL 2010 ALL RIGHTS RESERVED WORLDWIDE.

www.marel.com

TERMINAL-CONNECTION DIAGRAM

[illegible]

21
20
19
GENERAL REMARK:


1	2	3	4	5	6	7	8	9	10	11	12	13	14	15	16	17	18	19	20	21
ϕ_1																				

=TB+RC05xx
X3A.1

TERMINAL-CONNECTION DIAGRAM

PLACEMENT		+RC05xx/204.3	+RC05xx/204.3	+RC05xx/204.3	+RC05xx/204.4	+RC05xx/204.5																															
STRIP NAME		FUNCTION TEXT	INFEED CONVEYOR BREAKER																																		
=CP+RC05xx-X3B																																					
TERMINAL STRIP DIGITAL INPUTS																																					
PLC-DESIGNATION																																					
JUMPERS																																					
TERMINAL NUMBER		ϕ ₁	ϕ ₂	ϕ ₃	ϕ ₄	ϕ ₅	ϕ ₆																														


GENERAL REMARK:

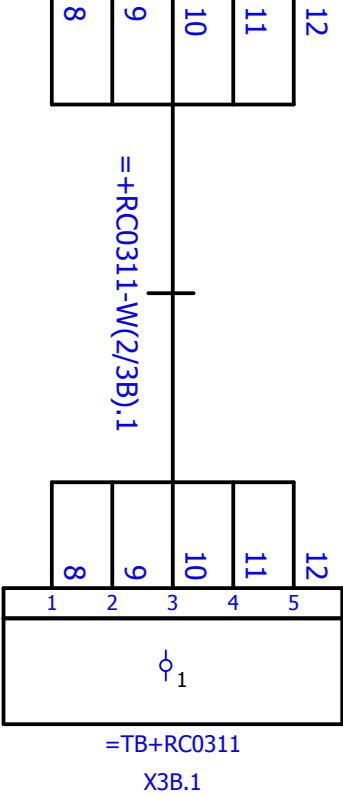

TERMINAL-CONNECTION DIAGRAM

[illegible]

GENERAL REMARK:

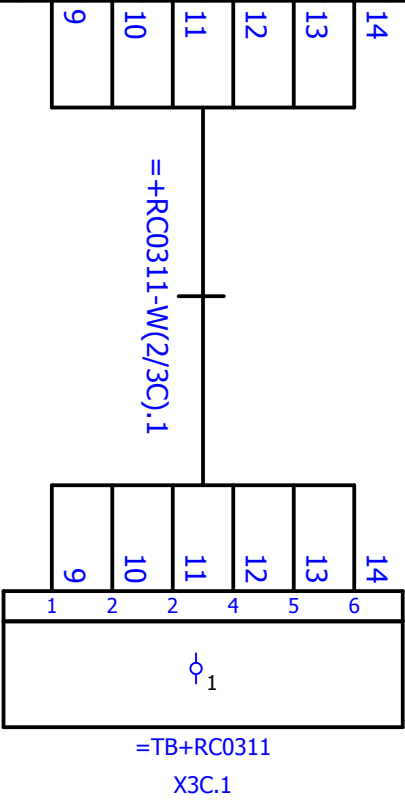

THIS DRAWING REMAINS PROPERTY OF MAREL ENTITY,
SPECIFIED ON PAGE 1 AND MAY NOT BE COPIED OR
REPRODUCED IN WHATEVER FORM WITHOUT PRIOR WRITTEN
CONSENT OF MAREL. FURTHER THIS DRAWING MAY NOT BE
DISCLOSED OR GIVEN TO ANY OTHER PARTY FOR INFORMATION
OR USE WITHOUT PRIOR WRITTEN CONSENT OF MAREL.

PROJ. TYPE: RC05xx
CUSTOMER:
COUNTRY:

PAGE DESCR.: **TERMINAL-CONNECT.DIAGRAM =CP+RC05xx-X3C**
=REP **REPORTS**

PAGE REV. DATE:	PAGE REV.	
	PROJ. REV.	D
EDITED ON: 2013.07.11	BY:	
CREATED ON: 2012.11.16	BY: JEL	

SCALE: 1:1 PAGE: 709


DWG. NO. 9667279

SHEET / TOTAL : (61 / 117)

TERMINAL-CONNECTION DIAGRAM

[illegible]


GENERAL REMARK:

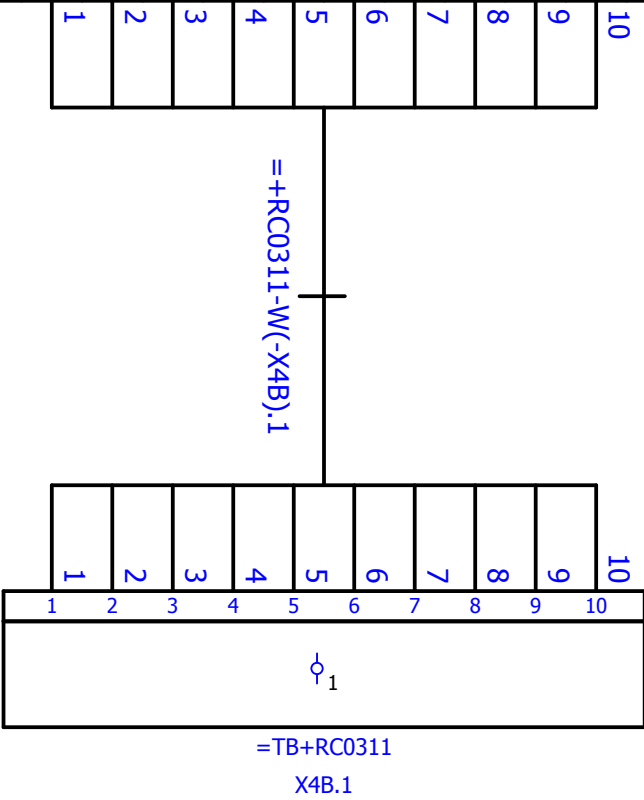

TERMINAL-CONNECTION DIAGRAM

[illegible]


GENERAL REMARK:

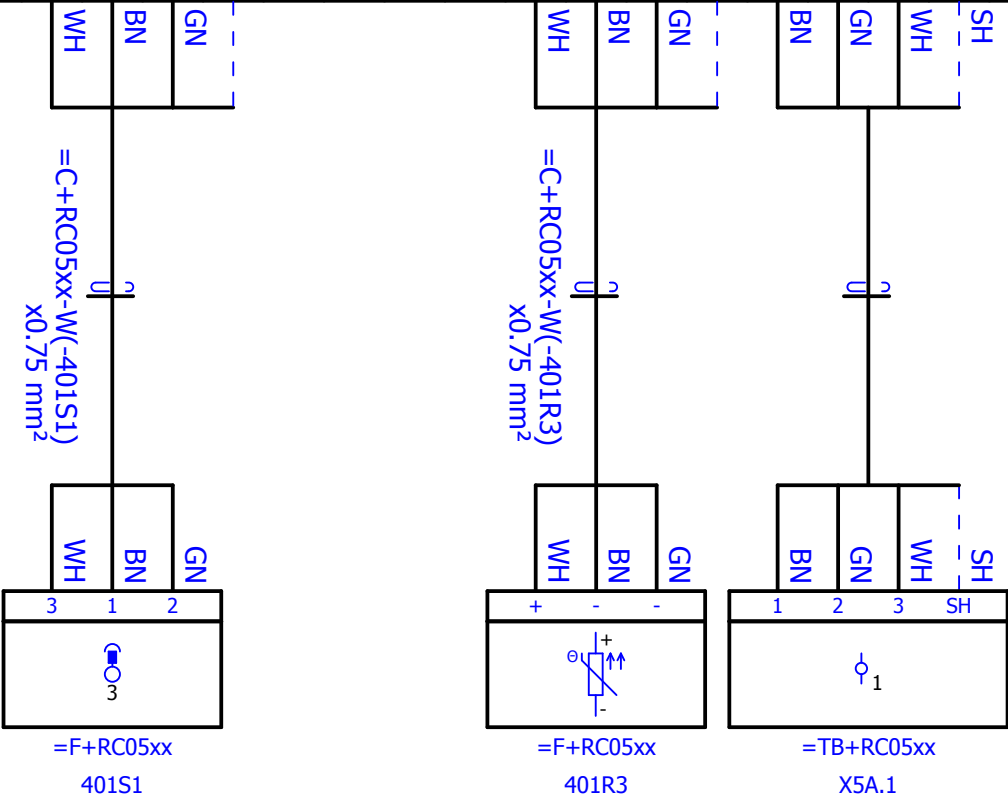

TERMINAL-CONNECTION DIAGRAM

[illegible]

GENERAL REMARK:

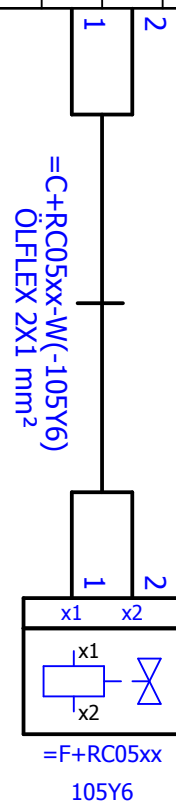

previous:
712

next:
714



THIS DRAWING REMAINS PROPERTY OF MAREL ENTITY,
SPECIFIED ON PAGE 1 AND MAY NOT BE COPIED OR
REPRODUCED IN WHATEVER FORM WITHOUT PRIOR WRITTEN
CONSENT OF MAREL. FURTHER THIS DRAWING MAY NOT BE
DISCLOSED OR GIVEN TO ANY OTHER PARTY FOR INFORMATION
OR USE WITHOUT PRIOR WRITTEN CONSENT OF MAREL.

PROJ. TYPE:	RC05xx
CUSTOMER:	
COUNTRY:	

PAGE DESCR.: **TERMINAL-CONNECT.DIAGRAM =CP+RC05xx-X6A**
=REP **REPORTS**

PAGE REV. DATE:	PAGE REV.	
	PROJ. REV.	D
EDITED ON: 2013.07.11 BY: CREATED ON: 2012.11.16 BY: JEL		

SCALE:	PAGE:	713
1:1		
DWG. NO.	9667279	
SHEET / TOTAL :	(65 / 117)	

TERMINAL-CONNECTION DIAGRAM


PLACEMENT		+RC05xx/206.1	+RC05xx/206.1	+RC05xx/301.9	+RC05xx/301.9	+RC05xx/206.2	+RC05xx/206.2	+RC05xx/101.6	+RC05xx/101.6	+RC05xx/101.6																											
STRIP NAME		FUNCTION TEXT																																			
=CP+RC05xx-X7A TERMINAL STRIP INTERCONNECTIONS																																					
PLC-DESIGNATION																																					
JUMPERS																																					
TERMINAL NUMBER		ϕ₁	ϕ₂	ϕ₃	ϕ₄	ϕ₅	ϕ₆	ϕ₇	ϕ₈	ϕ₉	ϕ₁₀																										

GENERAL REMARK:

TERMINAL-CONNECTION DIAGRAM

[illegible]

GENERAL REMARK:

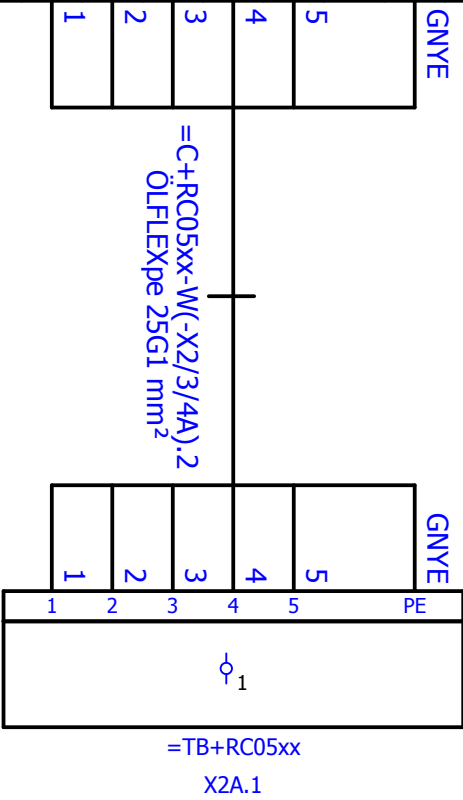


TERMINAL-CONNECTION DIAGRAM

[illegible]

13
12
11
10
9
8
7
6


GENERAL REMARK:

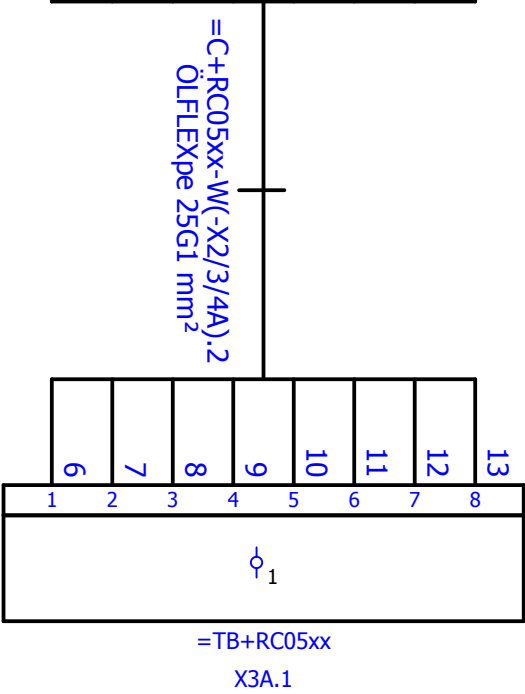

TERMINAL-CONNECTION DIAGRAM

[illegible]


GENERAL REMARK:

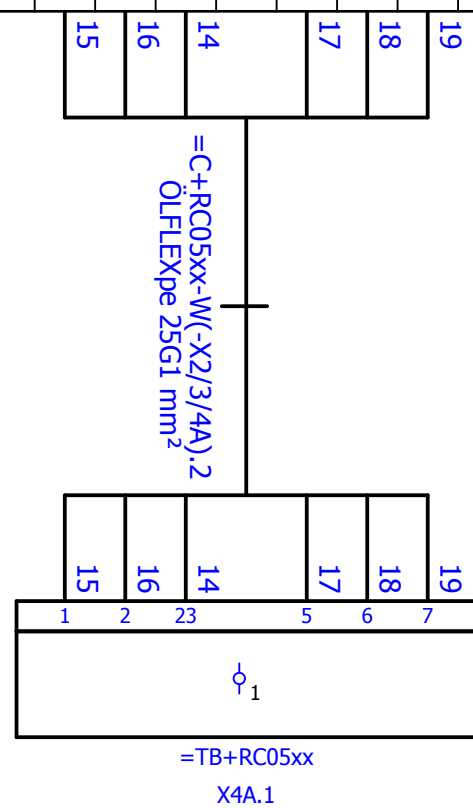

TERMINAL-CONNECTION DIAGRAM

[illegible]

GENERAL REMARK:

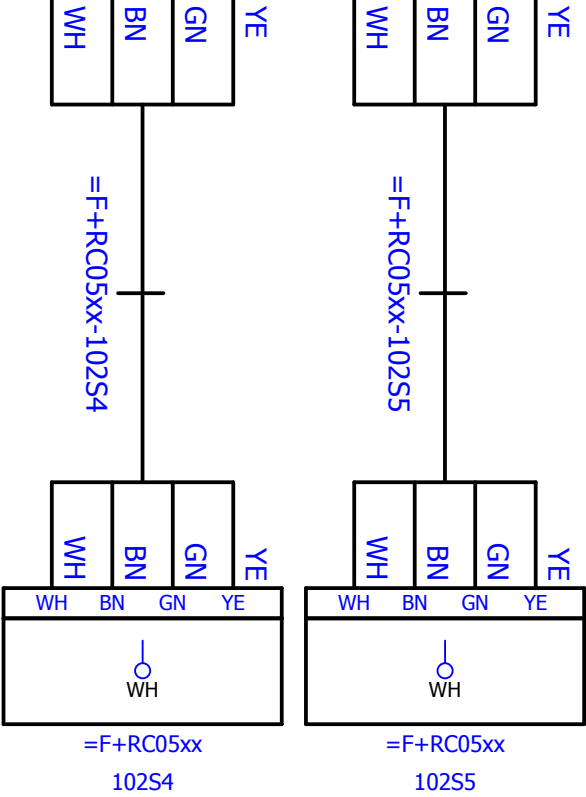


0123456789

TERMINAL-CONNECTION DIAGRAM

PLACEMENT	STRIP NAME		PLC-DESIGNATION	JUMPERS	TERMINAL NUMBER			
	FUNCTION TEXT							
+RC05xx/201.3	OIL THERMOSTAT				ϕ ₂₁			
+RC05xx/201.3					ϕ ₂			
+RC05xx/201.3					ϕ ₁			
+RC05xx/203.7					ϕ ₂₀			
+RC05xx/203.7					ϕ ₂			
+RC05xx/203.7					ϕ ₁			
+RC05xx/203.6					ϕ ₁₉			
+RC05xx/203.6					ϕ ₂			
+RC05xx/203.6					ϕ ₁			
+RC05xx/203.5					OIL FILTER PRESSURE SIDE			
+RC05xx/203.4	ϕ ₁₇							
+RC05xx/203.3	ϕ ₁₆							
+RC05xx/203.2	ϕ ₁₅							
+RC05xx/203.1	ϕ ₂							
+RC05xx/203.1	ϕ ₁							
+RC05xx/203.1	ϕ ₁₄							
+RC05xx/206.6								
+RC05xx/202.9	CONNECTOR 4X3 CONTROL BOX SERVICE							
+RC05xx/202.7					ϕ ₁₂			
+RC05xx/202.6					ϕ ₁₁			
+RC05xx/202.5					ϕ ₁₀			
+RC05xx/202.5					ϕ ₉			
+RC05xx/202.5					ϕ ₂			
+RC05xx/202.5					ϕ ₁			
+RC05xx/206.3								
+RC05xx/201.8	ϕ ₇							
+RC05xx/202.4	ϕ ₆							
+RC05xx/202.3	ϕ ₅							
+RC05xx/202.2	ϕ ₄							
+RC05xx/202.1	ϕ ₃							
+RC05xx/202.1	ϕ ₂							
+RC05xx/202.1	ϕ ₁							

GENERAL REMARK:

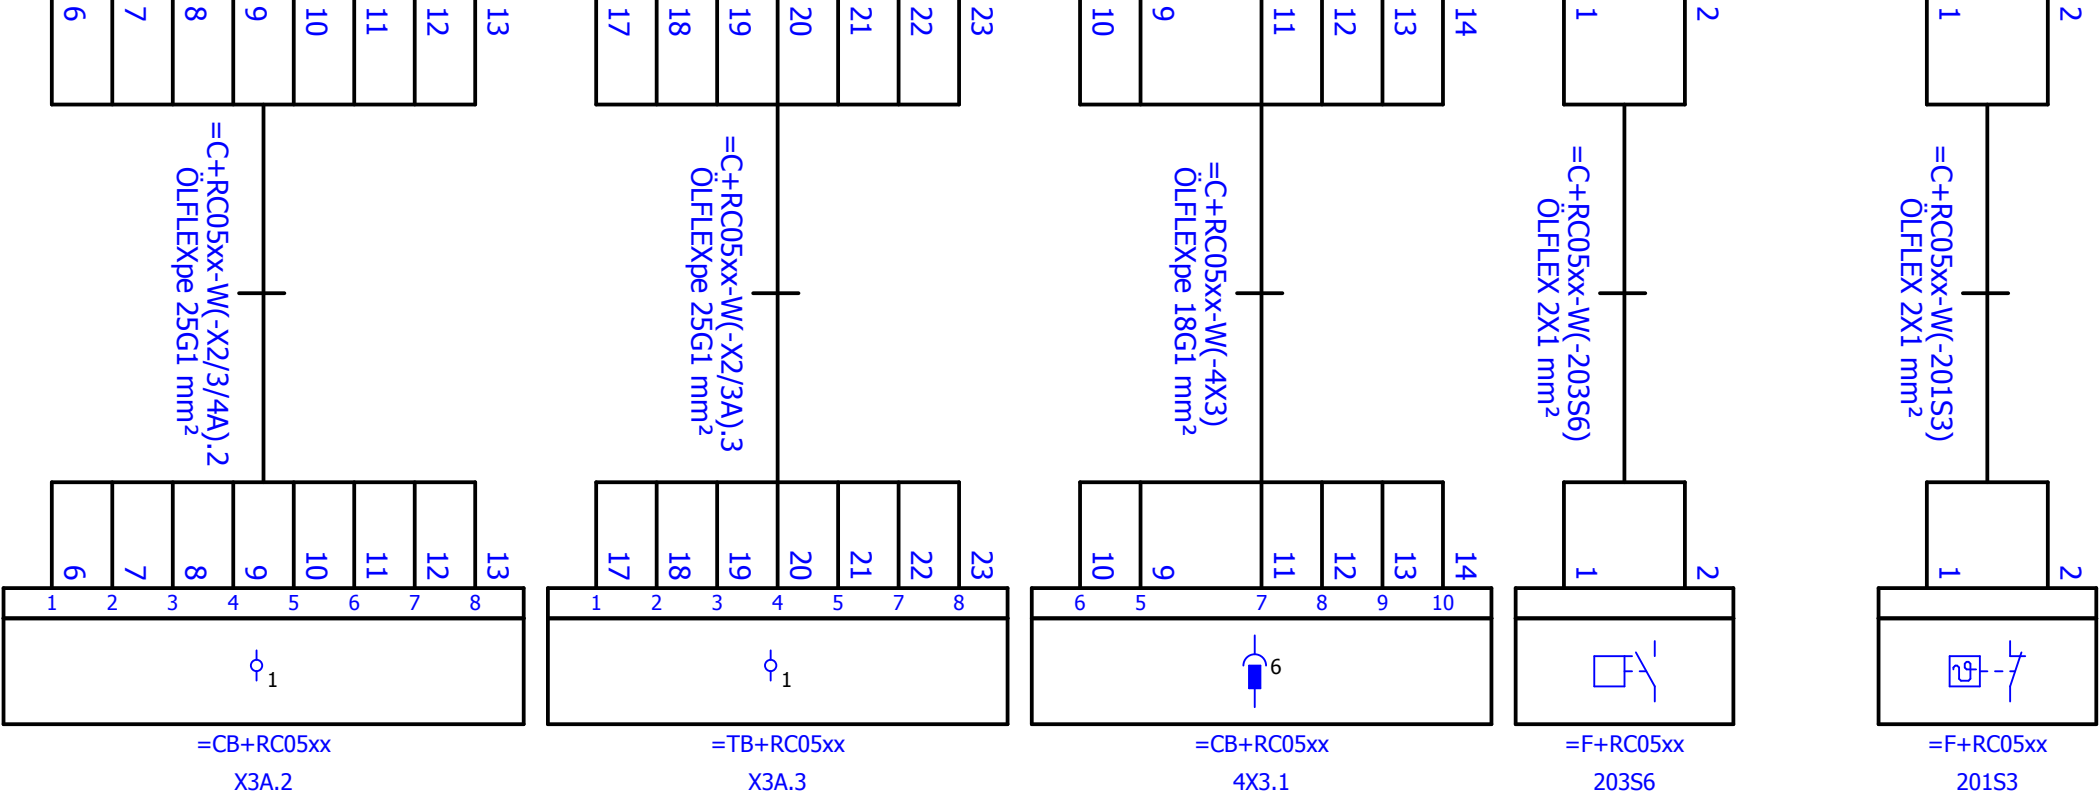


previous:
720

next:
722

TERMINAL-CONNECTION DIAGRAM

PLACEMENT	STRIP NAME	FUNCTION TEXT	PLC-DESIGNATION	JUMPERS	TERMINAL NUMBER
+RC05xx/304.3					17
+RC05xx/304.3					4
+RC05xx/304.3	SAFETY				3
+RC05xx/304.2					16
+RC05xx/304.2					4
+RC05xx/304.2	DIFFERENTIAL				3
+RC05xx/304.1					15
+RC05xx/304.1					4
+RC05xx/304.1					3
+RC05xx/303.8					14
+RC05xx/303.8					4
+RC05xx/303.8					3
+RC05xx/303.7					13
+RC05xx/303.7					4
+RC05xx/303.7	CYLINDER REVERSE / MRS PUMP TO PISTON AREA				3
+RC05xx/303.6					12
+RC05xx/303.6					4
+RC05xx/303.6	CYLINDER FORWARD / MRS PISTON AREA TO TANK				3
+RC05xx/303.5					11
+RC05xx/303.5					4
+RC05xx/303.5					3
+RC05xx/301.7					10
+RC05xx/301.7	COOLING WATER SUPPLY				2
+RC05xx/301.7					1
+RC05xx/301.6					9
+RC05xx/301.6					2
+RC05xx/301.6	CHAMBER / MRS SIDE CYLINDER REVERSE				1
+RC05xx/301.5					8
+RC05xx/301.5					2
+RC05xx/301.5	CHAMBER / MRS SIDE CYLINDER FORWARDS				1
+RC05xx/301.3					7
+RC05xx/301.2					6
+RC05xx/301.1					5
+RC05xx/301.1					2
+RC05xx/301.1	TERMINAL STRIP DIGITAL OUTPUTS				1

GENERAL REMARK:

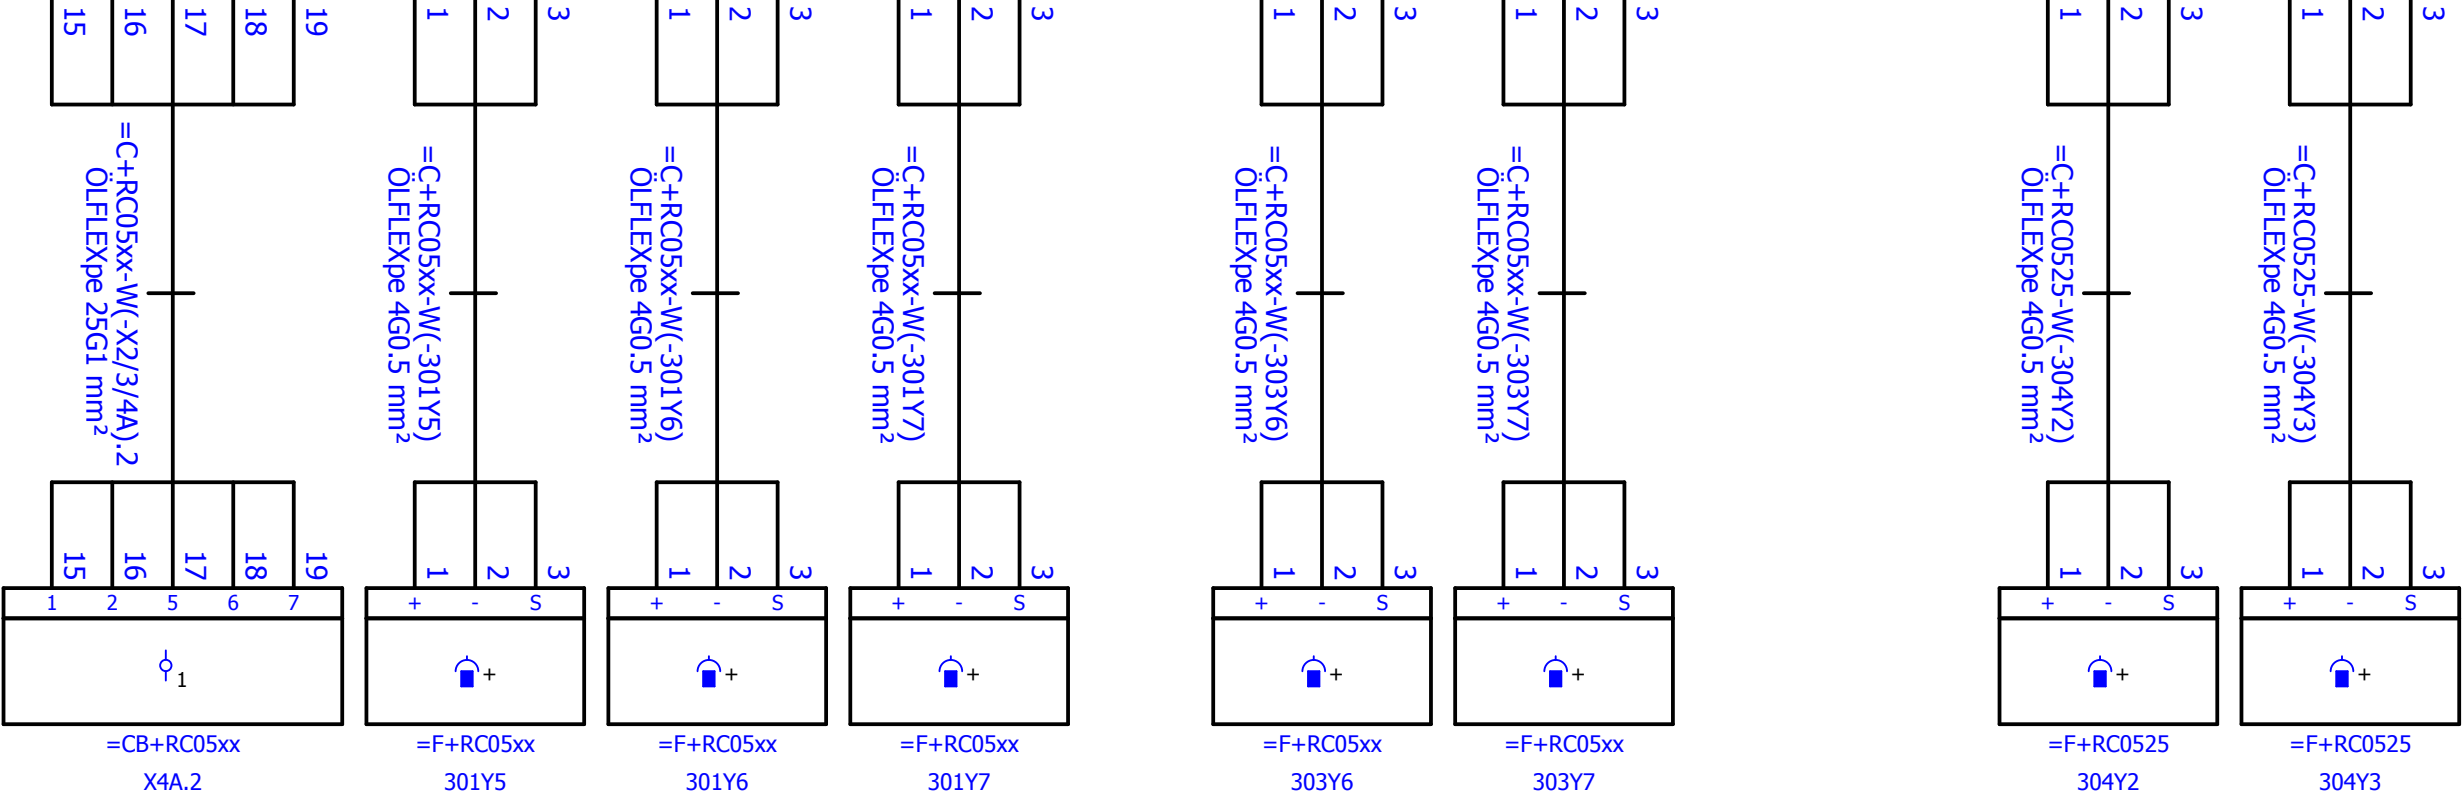


previous:
722

next:
723.A

TERMINAL-CONNECTION DIAGRAM

PLACEMENT		STRIP NAME	FUNCTION TEXT	PLC-DESIGNATION	JUMPERS	TERMINAL NUMBER
		=TB+RC05xx-X4A.1				


GENERAL REMARK:

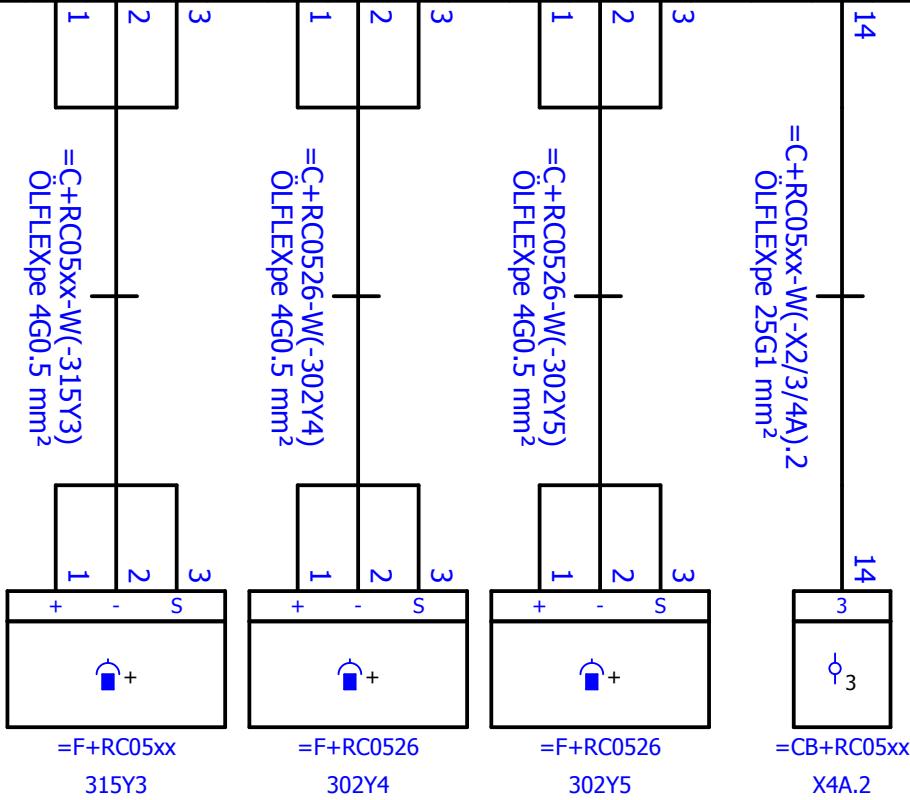

TERMINAL-CONNECTION DIAGRAM


PLACEMENT			+RC05xx/401.7	+RC05xx/401.7	+RC05xx/401.8	+RC05xx/401.8	+RC05xx/401.8																																																																																																																																																																																																																																																																																																																																																																																																																																																																																																																																																																																																																																																																																																																																																																																																																																																																																																																																																																																																																																																																																																																																																																																																																																																																																																																																																																																																								
-----------	--	--	---------------	---------------	---------------	---------------	---------------	--	--	
GENERAL REMARK:

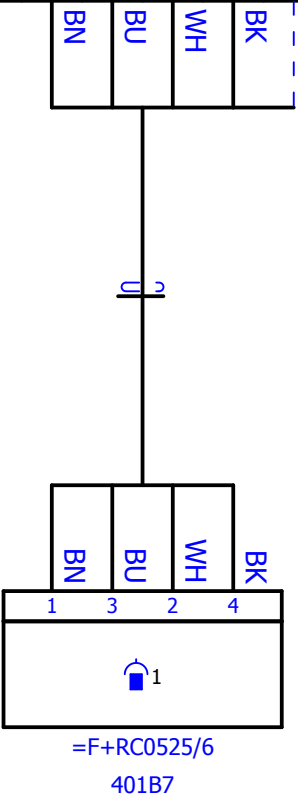

PIN-CONNECTION DIAGRAM

PLACEMENT		PLUG NAME	=CB+RC05xx-4X3.1	CONNECTOR 4X3 CONTROL BOX SERVICE	FUNCTION TEXT	PLC-DESIGNATION										PIN NUMBER																																																																																																																																																																																																																																																																																																																																																																																																																																																																																																																																																																																																																																																																																																																																																																																																																																																																																																																																																																																																																																																																																																																																																																																																																																																																																																																																																																							
																																																																																																																																																																																																																																																																																																																																																																																																																																																																																																																																																																																																																																																																																																																																																																																																																																																																																																																																																																																																																																																																																																																																																																																																																																																																																																																																																																																							</

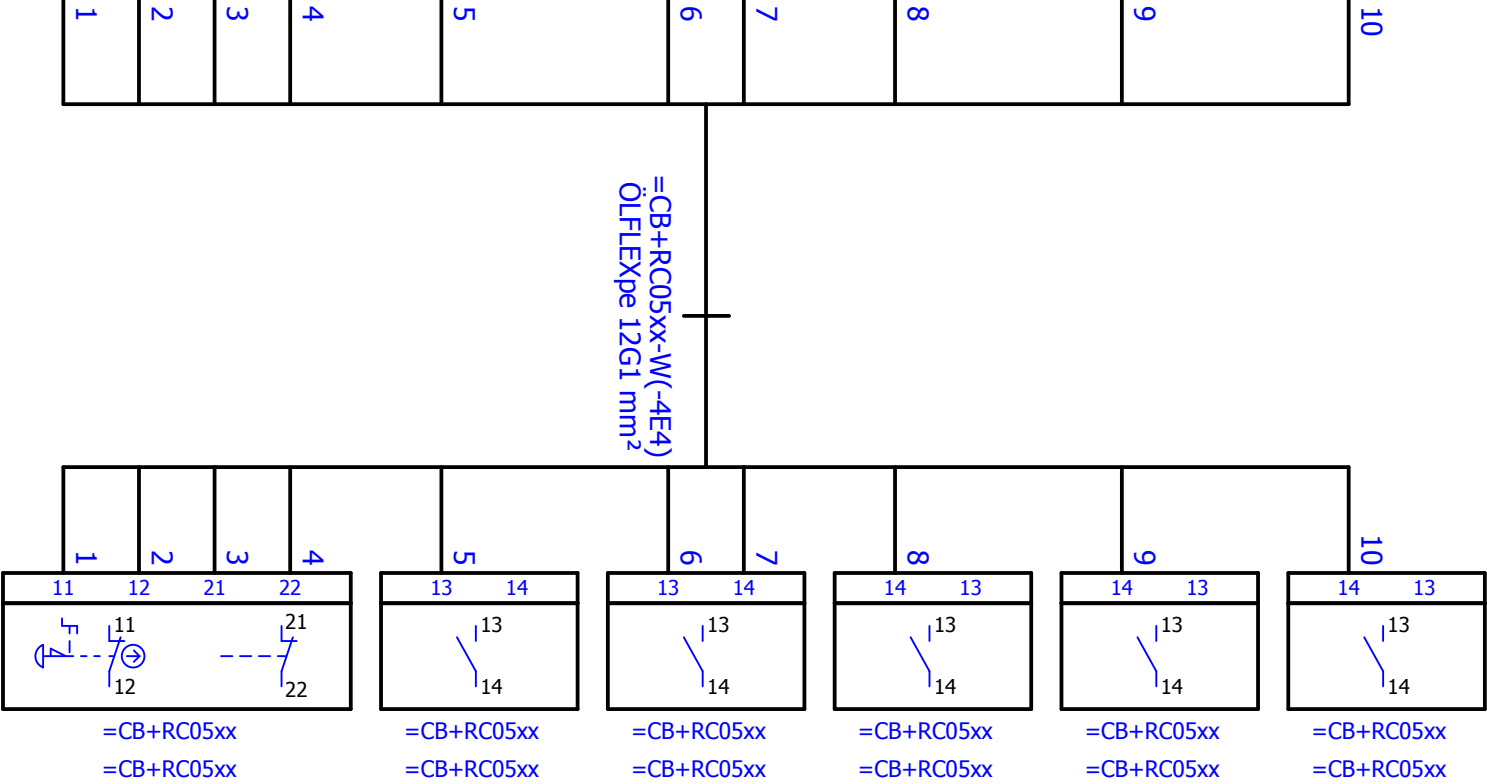

CABLE OVERVIEW

CABLE NAME	SOURCE (FROM)	TARGET (TO)	CABLE TYPE	ALL CON- DUCTORS	CON- DUCTORS USED	CROSS- SECTION mm	LENGTH [m]	REMARK	PLACEMENT
=+RC0221-W(-8Q3)			ÖLFLEXpe	4G	0	2.5			+RC05xx/8.3
=+RC0311-W(2/3B).1					0				+RC05xx/204.3
=+RC0311-W(2/3C).1					0				+RC05xx/204.6
=+RC0311-W(-8Q5)			ÖLFLEXpe	4G	0	2.5			+RC05xx/8.5
=+RC0311-W(-X2/3B).1					0				+RC05xx/100.9
=+RC0311-W(-X4B).1					0				+RC05xx/104.4
=+RC0311-102W4	=CP+RC05xx-X2C	=TB+RC0311-X2C.1	ÖLFLEXpe	18G	8	1			+RC05xx/102.A.4
=+RC0216-W(-8Q7)			ÖLFLEXpe	4G	0	2.5	20		+RC05xx/8.7
=CP+RC05xx-W(-9H1)	=CP+RC05xx-X91	=CP+RC05xx-9H1	ÖLFLEXpe	3G	3	1		INTERNAL	+RC05xx/9.1
=CB+RC05xx-W(-4E4)	=CB+RC05xx-4X3.1	=CB+RC05xx-101S5	ÖLFLEXpe	12G	10	1	5		+RC05xx/101.4
		=CB+RC05xx-203S4							
		=CB+RC05xx-203S1							
		=CB+RC05xx-203S2							
		=CB+RC05xx-203S3							
=C+RC05xx-W(-4X3)	=CB+RC05xx-4X3.1	=TB+RC05xx-X3A.1	ÖLFLEXpe	18G	15	1	1,5		=PRSP+RC05xx/1004.6
	=TB+RC05xx-X2A.1	=F+RC05xx-4X3							
=C+RC05xx-W(-6E3)	=CP+RC05xx-6PE2	=F+RC05xx-PE	H07V-K	1x	1	25.0	18		=PRSP+RC05xx/1001.0
=C+RC05xx-W(-7M3)	=F+RC05xx-7M3	=F+RC05xx-7Q3	ÖLFLEXpe	4G	4	1.5	2		=PRSP+RC05xx/1001.7
=C+RC05xx-W(-7M5)	=F+RC05xx-7Q5	=F+RC05xx-7M5	ÖLFLEXpe	4G	4	1.5	5		=PRSP+RC05xx/1001.5
=C+RC05xx-W(-7Q3)	=CP+RC05xx-X1A	=F+RC05xx-7Q3	ÖLFLEXpe	4G	4	1.5	20		=PRSP+RC05xx/1001.7
=C+RC05xx-W(-7Q5)	=CP+RC05xx-X1A	=F+RC05xx-7Q5	ÖLFLEXpe	4G	4	1.5	18		=PRSP+RC05xx/1001.5
=C+RC05xx-W(-103S1)	=CP+RC05xx-X2D	=F+RC05xx-103S1	ÖLFLEXpe	5G	4	1.5	18		=PRSP+RC05xx/1001.4
=C+RC05xx-W(-105Y6)	=CP+RC05xx-X6A	=F+RC05xx-105Y6	ÖLFLEX	2X	2	1	20		=PRSP+RC05xx/1002.7
=C+RC05xx-W(-201S3)	=TB+RC05xx-X3A.1	=F+RC05xx-201S3	ÖLFLEX	2X	2	1	3		=PRSP+RC05xx/1005.1
=C+RC05xx-W(-203S6)	=TB+RC05xx-X3A.1	=F+RC05xx-203S6	ÖLFLEX	2X	2	1	4		=PRSP+RC05xx/1005.2
=C+RC05xx-W(-301Y5)	=TB+RC05xx-X4A.1	=F+RC05xx-301Y5	ÖLFLEXpe	4G	4	0.5	4,5		=PRSP+RC05xx/1005.4
	=TB+RC05xx-PE1								
=C+RC05xx-W(-301Y6)	=TB+RC05xx-X4A.1	=F+RC05xx-301Y6	ÖLFLEXpe	4G	4	0.5	4,5		=PRSP+RC05xx/1005.5
	=TB+RC05xx-PE1								
=C+RC05xx-W(-301Y7)	=TB+RC05xx-X4A.1	=F+RC05xx-301Y7	ÖLFLEXpe	4G	4	0.5	3,5		=PRSP+RC05xx/1005.6
	=TB+RC05xx-PE1								
=C+RC05xx-W(-303Y6)	=TB+RC05xx-X4A.1	=F+RC05xx-303Y6	ÖLFLEXpe	4G	4	0.5	2		=PRSP+RC05xx/1006.2
	=TB+RC05xx-PE1								
=C+RC05xx-W(-303Y7)	=TB+RC05xx-X4A.1	=F+RC05xx-303Y7	ÖLFLEXpe	4G	4	0.5	2		=PRSP+RC05xx/1006.3
	=TB+RC05xx-PE1								
=C+RC05xx-W(-315Y3)	=TB+RC05xx-X4A.1	=F+RC05xx-315Y3	ÖLFLEXpe	4G	4	0.5	4,5		=PRSP+RC05xx/1008.3
	=TB+RC05xx-PE1								
=C+RC05xx-W(-401R3)	=CP+RC05xx-X5A	=F+RC05xx-401R3			4	0.75	18		+RC05xx/401.3
	=C+RC05xx-W(-401R3)								
=C+RC05xx-W(-401S1)	=CP+RC05xx-X5A	=F+RC05xx-401S1			4	0.75	18		+RC05xx/401.1
	=C+RC05xx-W(-401S1)								
=C+RC05xx-W(-X2/3/4A).2	=CB+RC05xx-X2A.2	=TB+RC05xx-X2A.1	ÖLFLEXpe	25G	20	1	5		=PRSP+RC05xx/1004.1
	=CB+RC05xx-X3A.2	=TB+RC05xx-X3A.1							
	=CB+RC05xx-X4A.2	=TB+RC05xx-X4A.1							
=C+RC05xx-W(-X2/3A).3	=TB+RC05xx-X2A.1	=TB+RC05xx-X2A.3	ÖLFLEXpe	25G	24	1	5		=PRSP+RC05xx/1004.5
	=TB+RC05xx-X3A.1	=TB+RC05xx-X3A.3							

CABLE OVERVIEW

[illegible]

previous:
800

```
next:
  901
```



THIS DRAWING REMAINS PROPERTY OF MAREL ENTITY,
SPECIFIED ON PAGE 1 AND MAY NOT BE COPIED OR
REPRODUCED IN WHATEVER FORM WITHOUT PRIOR WRITTEN
CONSENT OF MAREL. FURTHER THIS DRAWING MAY NOT BE
DISCLOSED OR GIVEN TO ANY OTHER PARTY FOR INFORMATION
OR USE WITHOUT PRIOR WRITTEN CONSENT OF MAREL.

PROJ. TYPE: RC05xx
CUSTOMER:
COUNTRY:

PAGE DESCR.: CABLE OVERVIEW
=REP REPORTS

PAGE REV. DATE:	PAGE REV.	
	PROJ. REV.	D
EDITED ON: 2013.07.11	BY:	
CREATED ON: 2012.11.16	BY: JEL	

SCALE: 1:1 PAGE: 800.A

DWG. NO. 9667279

SHEET / TOTAL : (80 / 117)

PARTS LIST

DEVICE TAG	FUNCTION GROUP	QTY	LENGTH	DESIGNATION	TYPE NUMBER	STORK PART NUMBER	DESCRIPTION	SERVICE
=C+RC05xx-W(-4X3)	C	1	1,5 m	CABLE 18G1,0/AWG18		9562762		
=C+RC05xx-W(-4X3)	C	1		CABLE GLAND BODY PVDF-FLUOR M25X1.5		9560764		
=C+RC05xx-W(-4X3)	C	2		SEALING INSERT PVC PG16/M25 1X16 WH		9560814		
=C+RC05xx-W(-4X3)	C	2		CABLE CODING		400002858		
=C+RC05xx-W(-6E3)	C	1	18 m	SINGLE CORE 25.0MM²/4AWG GREEN/YELLOW		9562738		
=C+RC05xx-W(-6E3)	C	1		LOCK NUT M25X1.5		002515595		
=C+RC05xx-W(-6E3)	C	1		CABLE GLAND BODY PVDF-FLUOR M25X1.5		9560764		
=C+RC05xx-W(-6E3)	C	1		SEALING INSERT PVC PG16/M25 1X13 RD		9560813		
=C+RC05xx-W(-6E3)	C	2		CABLE CODING		400002858		
=C+RC05xx-W(-7M3)	C	1	2 m	CABLE 4G1,5/AWG16		500074409		
=C+RC05xx-W(-7M3)	C	1		CABLE GLAND BODY PVDF-FLUOR M25X1.5		9560764		
=C+RC05xx-W(-7M3)	C	1		SEALING INSERT PVC PG16/M25 1X11 GN		9560812		
=C+RC05xx-W(-7M3)	C	1		CABLE GLAND BODY PVDF-FLUOR M20X1.5		9560763		
=C+RC05xx-W(-7M3)	C	1		SEALING INSERT PVC M20 1X11 GN		9560833		
=C+RC05xx-W(-7M3)	C	2		CABLE CODING		400002858		
=C+RC05xx-W(-7M5)	C	1	5 m	CABLE 4G1,5/AWG16		500074409		
=C+RC05xx-W(-7M5)	C	1		CABLE GLAND BODY PVDF-FLUOR M25X1.5		9560764		
=C+RC05xx-W(-7M5)	C	1		SEALING INSERT PVC PG16/M25 1X11 GN		9560812		
=C+RC05xx-W(-7M5)	C	1		CABLE GLAND BODY PVDF-FLUOR M20X1.5		9560763		
=C+RC05xx-W(-7M5)	C	1		SEALING INSERT PVC M20 1X11 GN		9560833		
=C+RC05xx-W(-7M5)	C	2		CABLE CODING		400002858		
=C+RC05xx-W(-7Q3)	C	1	20 m	CABLE 4G1,5/AWG16		500074409		
=C+RC05xx-W(-7Q3)	C	1		LOCK NUT M25X1.5		002515595		
=C+RC05xx-W(-7Q3)	C	2		CABLE GLAND BODY PVDF-FLUOR M25X1.5		9560764		
=C+RC05xx-W(-7Q3)	C	1		SEALING INSERT PVC PG16/M25 1X11 GN		9560812		
=C+RC05xx-W(-7Q3)	C	2		CABLE CODING		400002858		
=C+RC05xx-W(-7Q5)	C	1	18 m	CABLE 4G2,5/AWG14		500074401		
=C+RC05xx-W(-7Q5)	C	1		LOCK NUT M25X1.5		002515595		
=C+RC05xx-W(-7Q5)	C	2		CABLE GLAND BODY PVDF-FLUOR M25X1.5		9560764		
=C+RC05xx-W(-7Q5)	C	2		SEALING INSERT PVC PG16/M25 1X13 RD		9560813		
=C+RC05xx-W(-7Q5)	C	2		CABLE CODING		400002858		
=C+RC05xx-W(-103S1)	C	1	18 m	CABLE 5G1,5/AWG16		9562768		
=C+RC05xx-W(-103S1)	C	1		LOCK NUT M25X1.5		002515595		
=C+RC05xx-W(-103S1)	C	2		CABLE GLAND BODY PVDF-FLUOR M25X1.5		9560764		
=C+RC05xx-W(-103S1)	C	2		SEALING INSERT PVC PG16/M25 1X9 BK		9560811		
=C+RC05xx-W(-103S1)	C	2		CABLE CODING		400002858		
=C+RC05xx-W(-105Y6)	C	1	20 m	CABLE 2X1,0/AWG 18		9562756		
=C+RC05xx-W(-105Y6)	C	1		SEALING INSERT PVC PG16/M25 1X8 GY		9560810		

PARTS LIST

DEVICE TAG	FUNCTION GROUP	QTY	LENGTH	DESIGNATION	TYPE NUMBER	STORK PART NUMBER	DESCRIPTION	SERVICE
=C+RC05xx-W(-105Y6)	C	2		CABLE CODING		400002858		
=C+RC05xx-W(-201S3)	C	1	3 m	CABLE 2X1,0/AWG 18		9562756		
=C+RC05xx-W(-201S3)	C	1		SEALING INSERT PVC PG16/M25 3X7 WH		9560786		
=C+RC05xx-W(-201S3)	C	1		CABLE GLAND SEALING PLUG 7MM		9560791		
=C+RC05xx-W(-201S3)	C	2		CABLE CODING		400002858		
=C+RC05xx-W(-203S6)	C	1	4 m	CABLE 2X1,0/AWG 18		9562756		
=C+RC05xx-W(-203S6)	C	2		CABLE CODING		400002858		
=C+RC05xx-W(-301Y5)	C	1	4,5 m	CABLE 4G0,5/AWG 20		9562742		
=C+RC05xx-W(-301Y5)	C	1		SEALING INSERT PVC PG16/M25 3X7 WH		9560786		
=C+RC05xx-W(-301Y5)	C	2		CABLE CODING		400002858		
=C+RC05xx-W(-301Y6)	C	1	4,5 m	CABLE 4G0,5/AWG 20		9562742		
=C+RC05xx-W(-301Y6)	C	2		CABLE CODING		400002858		
=C+RC05xx-W(-301Y7)	C	1	3,5 m	CABLE 4G0,5/AWG 20		9562742		
=C+RC05xx-W(-301Y7)	C	2		CABLE CODING		400002858		
=C+RC05xx-W(-303Y6)	C	1	2 m	CABLE 4G0,5/AWG 20		9562742		
=C+RC05xx-W(-303Y6)	C	1		SEALING INSERT PVC PG16/M25 3X7 WH		9560786		
=C+RC05xx-W(-303Y6)	C	2		CABLE CODING		400002858		
=C+RC05xx-W(-303Y7)	C	1	2 m	CABLE 4G0,5/AWG 20		9562742		
=C+RC05xx-W(-303Y7)	C	2		CABLE CODING		400002858		
=C+RC05xx-W(-315Y3)	C	1	4,5 m	CABLE 4G0,5/AWG 20		9562742		
=C+RC05xx-W(-315Y3)	C	2		CABLE CODING		400002858		
=C+RC05xx-W(-401R3)	C	2	18 m	COLOUR CABLE SHIELDED 4X0.75		9562595		
=C+RC05xx-W(-401R3)	C	2		SEALING INSERT PVC PG16/M25 3X7 WH		9560786		
=C+RC05xx-W(-401R3)	C	4		CABLE CODING		400002858		
=C+RC05xx-W(-401R3)	C	2		CABLE GLAND SEALING PLUG 7MM		9560791		
=C+RC05xx-W(-401S1)	C	2	18 m	COLOUR CABLE SHIELDED 4X0.75		9562595		
=C+RC05xx-W(-401S1)	C	4		CABLE CODING		400002858		
=C+RC05xx-W(-X2/3/4A).2	C	1	5 m	CABLE 25G1,0/AWG18		9562763		
=C+RC05xx-W(-X2/3/4A).2	C	2		SEALING INSERT PVC PG21/M32 1X18 BU		9560818		
=C+RC05xx-W(-X2/3/4A).2	C	2		CABLE CODING		400002858		
=C+RC05xx-W(-X2/3A).3	C;TB02	2		SEALING INSERT PVC PG21/M32 1X18 BU		9560818		
=C+RC05xx-W(-X2/3A).3	C	2		CABLE CODING		400002858		
=C+RC05xx-W(-X2A).1	C	1	18 m	CABLE 25G1,0/AWG18		9562763		
=C+RC05xx-W(-X2A).1	C	1		LOCK NUT M32X1.5		002515596		
=C+RC05xx-W(-X2A).1	C	1		CABLE GLAND BODY PVDF-FLUOR M32X1.5		9560765		
=C+RC05xx-W(-X2A).1	C	2		SEALING INSERT PVC PG21/M32 1X18 BU		9560818		
=C+RC05xx-W(-X2A).1	C	2		CABLE CODING		400002858		
=C+RC05xx-W(-X3A).1	C	1	18 m	CABLE 25G1,0/AWG18		9562763		

PARTS LIST

[illegible]

previous:
902

next:
904



THIS DRAWING REMAINS PROPERTY OF MAREL ENTITY,
SPECIFIED ON PAGE 1 AND MAY NOT BE COPIED OR
REPRODUCED IN WHATEVER FORM WITHOUT PRIOR WRITTEN
CONSENT OF MAREL. FURTHER THIS DRAWING MAY NOT BE
DISCLOSED OR GIVEN TO ANY OTHER PARTY FOR INFORMATION
OR USE WITHOUT PRIOR WRITTEN CONSENT OF MAREL.

PROJ. TYPE: RC05xx
CUSTOMER:
COUNTRY:

PAGE DESCR.: PARTS LIST
=REP REPORTS

PAGE REV. DATE:	PAGE REV.	
	PROJ. REV.	D
EDITED ON: 2013.07.11	BY:	
CREATED ON: 2012.11.16	BY: JEL	

SCALE: 1:1 PAGE: 903

DWG. NO. 9667279

SHEET / TOTAL : (83 / 117)

PARTS LIST

DEVICE TAG	FUNCTION GROUP	QTY	LENGTH	DESIGNATION	TYPE NUMBER	STORK PART NUMBER	DESCRIPTION	SERVICE
=CB+RC05xx-4E0.1	CB01	1		PLATE STICKER, CONTOL BOX RC04 & RC05		9562882	DRAWING NUMBER 9651043_A	
=CB+RC05xx-4E0.1	CB01	1		OPERATOR CONTROL PANEL 230X200X128MM		9558427		
=CB+RC05xx-4E0.1	CB01	1		FRONT PANEL		095239031		
=CB+RC05xx-4E0.1	CB01	1		CABLE GLAND BODY PVDF-FLUOR M32X1.5		9560765		
=CB+RC05xx-4E0.1	CB01	1		SEALING INSERT PVC PG21/M32 1X16 WH		9560817		
=CB+RC05xx-100H8	CB01	1		INDICATOR RED LED (24V)		095260056		
=CB+RC05xx-101S3	CB01	1		MUSHROOM HEAD BUTTON RED 40MM		095252293		
=CB+RC05xx-101S3	CB01	0		LEGEND FOR EMERGENCY STOP PUSH BUTTON YE 60MM		9560178		
=CB+RC05xx-101S3	CB01	1		FIXING COLLAR		095300971		
=CB+RC05xx-101S3	CB01	2		SCREW TERMINAL CONTACT 1 NC		095252328	SCREW TERMINAL CONTACT 1 NC	B
=CB+RC05xx-101S3	CB01	1		RED BELLOW FOR E-STOP PUSHBUTTON		400001053		
=CB+RC05xx-201S8	CB01	1		PUSHBUTTON, BLUE 1XNO		095250317		
=CB+RC05xx-202S1	CB01	1		SWITCH, SELECTOR 1XNO		095040119		
=CB+RC05xx-202S2	CB01	1		SWITCH, SELECTOR 1XNO		095040119		
=CB+RC05xx-202S3	CB01	1		SWITCH, SELECTOR 3POS. 2XNO		095040129		
=CB+RC05xx-301H1	CB01	1		INDICATOR WHITE LED (24V)		095260054	WHITE LED 24VAC/DC	
=CB+RC05xx-301H2	CB01	1		INDICATOR YELLOW LED (24V)		095260057		
=CB+RC05xx-301H3	CB01	1		INDICATOR WHITE LED (24V)		095260054	WHITE LED 24VAC/DC	
=CB+RC05xx-X2A.2	CB01	1		END CLAMP		9559470		
=CB+RC05xx-X2A.2	CB01	1		TERMINAL STRIP MARKER		9559630		
=CB+RC05xx-X2A.2	CB01	6		TERMINAL BLOCK 2,5 MM		9559658	Voorheen UK3, bestelnr.: 30 02 01 8	
=CB+RC05xx-X2A.2	CB01	1		GROUND TERMINAL BLOCK 4MM		9559663	Voorheen USLKG4, bestelnr.: 04 41 01 2	
=CB+RC05xx-X3A.2	CB01	1		END CLAMP		9559470		
=CB+RC05xx-X3A.2	CB01	1		TERMINAL STRIP MARKER		9559630		
=CB+RC05xx-X3A.2	CB01	1		COVER		9559551		
=CB+RC05xx-X3A.2	CB01	1		SPACER PLATE, COMPENSATES FOR LEVEL OFFSET		9559548		
=CB+RC05xx-X3A.2	CB01	4		DOUBLE LEVEL TERMINAL BLOCK 4MM 1 FIXED BR.		9559544		
=CB+RC05xx-X4A.2	CB01	2		END CLAMP		9559470		
=CB+RC05xx-X4A.2	CB01	1		TERMINAL STRIP MARKER		9559630		
=CB+RC05xx-X4A.2	CB01	1		COVER		9559551		
=CB+RC05xx-X4A.2	CB01	1		SPACER PLATE, COMPENSATES FOR LEVEL OFFSET		9559548		
=CB+RC05xx-X4A.2	CB01	4		DOUBLE LEVEL TERMINAL BLOCK 4MM 1 FIXED BR.		9559544		

PARTS LIST

[illegible]

previous:
904

next:
906



THIS DRAWING REMAINS PROPERTY OF MAREL ENTITY,
SPECIFIED ON PAGE 1 AND MAY NOT BE COPIED OR
REPRODUCED IN WHATEVER FORM WITHOUT PRIOR WRITTEN
CONSENT OF MAREL. FURTHER THIS DRAWING MAY NOT BE
DISCLOSED OR GIVEN TO ANY OTHER PARTY FOR INFORMATION
OR USE WITHOUT PRIOR WRITTEN CONSENT OF MAREL.

PROJ. TYPE: RC05xx
CUSTOMER:
COUNTRY:

PAGE DESCR.: PARTS LIST
=REP REPORTS

PAGE REV. DATE:	PAGE REV.	
	PROJ. REV.	D
EDITED ON: 2013.07.11	BY:	
CREATED ON: 2012.11.16	BY: JEL	

SCALE: 1:1 PAGE: 905

DWG. NO. 9667279

SHEET / TOTAL : (85 / 117)

PARTS LIST

DEVICE TAG	FUNCTION GROUP	QTY	LENGTH	DESIGNATION	TYPE NUMBER	STORK PART NUMBER	DESCRIPTION	SERVICE
=CP+RC05xx-4E0	CP	1		ENCLOSURE EMPTY 1400X800X400		9562386		
=CP+RC05xx-4E0	CP	3		LOCK NUT M25X1.5		002515595		
=CP+RC05xx-4E0	CP	3		CABLE GLAND BODY PVDF-FLUOR M25X1.5		9560764		
=CP+RC05xx-4E0	CP	3		SEALING INSERT PVC M25/PG16 CLOSED		9560917		
=CP+RC05xx-4E0	CP	1		CAM LOCK 24MM SS ASSEMBLED		400002111	MAREL KEY, PART NUMBER 400002525	
=CP+RC05xx-6F5	CP	3		FUSE HOLDER 00		9558696		
=CP+RC05xx-6PE2	CP	1		EARTHRAIL 63A (59XM6)		9559770		
=CP+RC05xx-6Q1	CP	1		SWITCH DMV250N/4		095215137	250A 3P+N	
=CP+RC05xx-6Q1	CP	1		HAND GRIP K3KDB/P BLUE		090500361	for main swich DMV250/400	
=CP+RC05xx-6Q1	CP	1		SHAFT sq.10X10, L=400mm		091400051	FOR DMV250/400 WITH HANDEL K3	
=CP+RC05xx-6X6	CP	4		TERMINAL BLOCK BUSBAR 63A 3P		095320046		
=CP+RC05xx-6X6	CP	2		COMPACT BUSBAR 3 PHASE 4X45MM		095147527		
=CP+RC05xx-7	CP	1		THERM. MAGN. MOTOR CIRCUIT BREAKER		095201212		B
=CP+RC05xx-7	CP	1		AUXILLIARY CONTACT 1NO+1NC		095320042		
=CP+RC05xx-7F3	CP	1		THERM. MAGN. MOTOR CIRCUIT BREAKER		095201212		B
=CP+RC05xx-7F3	CP	1		AUXILLIARY CONTACT 1NO+1NC		095320042		
=CP+RC05xx-7F5	CP	1		THERM. MAGN. MOTOR CIRCUIT BREAKER		095201220		B
=CP+RC05xx-7F5	CP	1		AUXILLIARY CONTACT 1NO+1NC		095320042		
=CP+RC05xx-8F3	CP	1		THERM. MAGN. MOTOR CIRCUIT BREAKER		095201218		B
=CP+RC05xx-8F3	CP	1		AUXILLIARY CONTACT 1NO+1NC		095320042		
=CP+RC05xx-8F5	CP	1		THERM. MAGN. MOTOR CIRCUIT BREAKER		095201236		B
=CP+RC05xx-8F5	CP	1		AUXILLIARY CONTACT 1NO+1NC		095320042		
=CP+RC05xx-8F7	CP	1		THERM. MAGN. MOTOR CIRCUIT BREAKER		095201212		B
=CP+RC05xx-8F7	CP	1		AUXILLIARY CONTACT 1NO+1NC		095320042		
=CP+RC05xx-9F2	CP	1		THERM. MAGN. MOTOR CIRCUIT BREAKER		095201220		B
=CP+RC05xx-9F2.1	CP	1		MINIATURE CIRCUIT BREAKER 1P+N 4A		9558773		B
=CP+RC05xx-9H1	CP	1		ENCLOSURE LIGHT		9559836		
=CP+RC05xx-9T2	CP	1		TRANSFORMER PR.400-480-575V/SEC.230V-500VA		400001004		B
=CP+RC05xx-10F1	CP	1		THERM. MAGN. MOTOR CIRCUIT BREAKER		095201220		B
=CP+RC05xx-10F1.2	CP	1		FUSE TERM.BLOCK FOR CARTRIDGE FUSE 24V LED		9559557		
=CP+RC05xx-10F1.2	CP	1		GLASS BODY FUSE 1AMP		9558712		B
=CP+RC05xx-10F2	CP	1		FUSE TERM.BLOCK FOR CARTRIDGE FUSE 24V LED		9559557		
=CP+RC05xx-10F2	CP	1		GLASS BODY FUSE 2AMP		9558715		B
=CP+RC05xx-10F2.1	CP	1		FUSE TERM.BLOCK FOR CARTRIDGE FUSE 24V LED		9559557		
=CP+RC05xx-10F2.1	CP	1		GLASS BODY FUSE 4AMP		9558717		B
=CP+RC05xx-10F3	CP	1		FUSE TERM.BLOCK FOR CARTRIDGE FUSE 24V LED		9559557		
=CP+RC05xx-10F3	CP	1		GLASS BODY FUSE 6AMP		9558718		B
=CP+RC05xx-10F5	CP	1		FUSE TERM.BLOCK FOR CARTRIDGE FUSE 24V LED		9559557		

PARTS LIST

DEVICE TAG	FUNCTION GROUP	QTY	LENGTH	DESIGNATION	TYPE NUMBER	STORK PART NUMBER	DESCRIPTION	SERVICE
=CP+RC05xx-10F5	CP	1		GLASS BODY FUSE 1AMP		9558712		B
=CP+RC05xx-10G1	CP	1		DC POWER SUPPLY		400001446		B
=CP+RC05xx-100H7	CP	1		INDICATOR RED LED (24V)		095260056		
=CP+RC05xx-100K0	CP	1		SAFETY RELAY 24VAC/DC		095300831		B
=CP+RC05xx-100K6	CP	1		RELAY AUXILIARY 3XNO, 2XNC		095300808		B
=CP+RC05xx-100K7	CP	1		RELAY AUXILIARY 3XNO, 2XNC		095300808		B
=CP+RC05xx-100S4	CP	1		PUSHBUTTON, BLUE 1XNO		095250317		
=CP+RC05xx-101S2	CP	1		MUSHROOM HEAD BUTTON RED 40MM		095252293		
=CP+RC05xx-101S2	CP	1		LEGEND FOR EMERGENCY STOP PUSH BUTTON YE 60MM		9560178		
=CP+RC05xx-101S2	CP	1		FIXING COLLAR		095300971		
=CP+RC05xx-101S2	CP	2		SCREW TERMINAL CONTACT 1 NC		095252328	SCREW TERMINAL CONTACT 1 NC	B
=CP+RC05xx-102F1	CP	1		FUSE TERM.BLOCK FOR CARTRIDGE FUSE 24V LED		9559557		
=CP+RC05xx-102F1	CP	1		GLASS BODY FUSE 800MAMP		9558711		B
=CP+RC05xx-102F1.1	CP	1		FUSE TERM.BLOCK FOR CARTRIDGE FUSE 24V LED		9559557		
=CP+RC05xx-102F1.1	CP	1		GLASS BODY FUSE 800MAMP		9558711		B
=CP+RC05xx-102K1	CP	1		CONTROL SAFETY RELAY		9562825		B
=CP+RC05xx-102K1.1	CP	1		CONTROL SAFETY RELAY		9562825		B
=CP+RC05xx-102K2	CP	1		RELAY AUXILIARY 3XNO, 2XNC		095300808		B
=CP+RC05xx-102K2.1	CP	1		RELAY AUXILIARY 3XNO, 2XNC		095300808		B
=CP+RC05xx-102K3	CP	1		RELAY AUXILIARY 3XNO, 2XNC		095300808		B
=CP+RC05xx-102K3.1	CP	1		RELAY AUXILIARY 3XNO, 2XNC		095300808		B
=CP+RC05xx-102U3	CP	1		INTERFACE FOR CONTROL UNIT 4X LED INDICATION		9562823		
=CP+RC05xx-102U3.1	CP	1		INTERFACE FOR CONTROL UNIT 4X LED INDICATION		9562823		
=CP+RC05xx-103K1.SB	CP	1		CONTACTOR 3P/40A 230VAC		400004194		B
=CP+RC05xx-103K2.MB	CP	1		CONTACTOR 3P/50A 230VAC		400004195		B
=CP+RC05xx-103K2.MB	CP	1		MOUNTING KIT STAR DELTA		400004196		
=CP+RC05xx-103K3.DB	CP	1		CONTACTOR 3P/50A 230VAC		400004195		B
=CP+RC05xx-103K3.DB	CP	1		FRONT MOUNTING ADD-ON CONTACT BLOCK 1NO		9559308	7049893	
=CP+RC05xx-103K5	CP	1		CONTACTOR 3P/9A 230VAC		095200206		B
=CP+RC05xx-103K6	CP	1		CONTACTOR 3P/9A 230VAC		095200206		B
=CP+RC05xx-103K7	CP	1		CONTACTOR 3P/9A 230VAC		095200206		B
=CP+RC05xx-103K8	CP	1		CONTACTOR 3P/25A 230VAC		9558982		B
=CP+RC05xx-103K9	CP	1		CONTACTOR 3P/9A 230VAC		095200206		B
=CP+RC05xx-105U4	CP	1		AMPLIFIER PRESSURE CONTROL CARD 24VDC		9559855		
=CP+RC05xx-105U4	CP	1		CARD HOLDER		9559601		
=CP+RC05xx-200A1	CP	1		MODLUE CPU NOT PROGRAMMED		400004327		B
=CP+RC05xx-200A3	CP	1		MODULE INPUT 32-POINT 24VDC		400004325		B
=CP+RC05xx-200A4	CP	1		MODULE OUTPUT 32-POINT 24VDC/2A		9793362		B

PARTS LIST

DEVICE TAG	FUNCTION GROUP	QTY	LENGTH	DESIGNATION	TYPE NUMBER	STORK PART NUMBER	DESCRIPTION	SERVICE
=CP+RC05xx-200A5	CP	1		MODULE ANALOG 4 INPUT/ 2 OUTPUT FAST		400004322		B
=CP+RC05xx-200A6	CP	1		MODULE INPUT 32-POINT 24VDC		400004325		B
=CP+RC05xx-200A7	CP	1		BUSH LOCKING		095500078		
=CP+RC05xx-200X2	CP	1		MODULE INTERFACE 40-POS.		9559608		
=CP+RC05xx-200X3	CP	1		MODULE INTERFACE 40-POS.		9559608		
=CP+RC05xx-200X6	CP	1		MODULE INTERFACE 40-POS.		9559608		
=CP+RC05xx-201W0	CP	1		CABLE RIBBON 26AWG 40		095147080		
=CP+RC05xx-201W0	CP	2		CONNECTOR 40-POLE FEMALE		095500491		
=CP+RC05xx-205W0	CP	1		CABLE RIBBON 26AWG 40		095147080		
=CP+RC05xx-205W0	CP	2		CONNECTOR 40-POLE FEMALE		095500491		
=CP+RC05xx-301K4	CP	1		STANDARD PLUG-IN RELAY 4P 24VDC + DIODE		9559057		
=CP+RC05xx-301K4	CP	1		SOCKET FOR RELAY C9		9559059		
=CP+RC05xx-301K8	CP	1		STANDARD PLUG-IN RELAY 4P 24VDC + DIODE		9559057		
=CP+RC05xx-301K8	CP	1		SOCKET FOR RELAY C9		9559059		
=CP+RC05xx-301W0	CP	1		CABLE RIBBON 26AWG 40		095147080		
=CP+RC05xx-301W0	CP	2		CONNECTOR 40-POLE FEMALE		095500491		
=CP+RC05xx-302K7	CP	1		STANDARD PLUG-IN RELAY 4P 24VDC + DIODE		9559057		
=CP+RC05xx-302K7	CP	1		SOCKET FOR RELAY C9		9559059		
=CP+RC05xx-302K8	CP	1		STANDARD PLUG-IN RELAY 4P 24VDC + DIODE		9559057		
=CP+RC05xx-302K8	CP	1		SOCKET FOR RELAY C9		9559059		
=CP+RC05xx-303K1	CP	1		STANDARD PLUG-IN RELAY 4P 24VDC + DIODE		9559057		
=CP+RC05xx-303K1	CP	1		SOCKET FOR RELAY C9		9559059		
=CP+RC05xx-303K3	CP	1		STANDARD PLUG-IN RELAY 4P 24VDC + DIODE		9559057		
=CP+RC05xx-303K3	CP	1		SOCKET FOR RELAY C9		9559059		
=CP+RC05xx-304K6	CP	1		STANDARD PLUG-IN RELAY 4P 24VDC + DIODE		9559057		
=CP+RC05xx-304K6	CP	1		SOCKET FOR RELAY C9		9559059		
=CP+RC05xx-304K7	CP	1		STANDARD PLUG-IN RELAY 4P 24VDC + DIODE		9559057		
=CP+RC05xx-304K7	CP	1		SOCKET FOR RELAY C9		9559059		
=CP+RC05xx-304K8	CP	1		STANDARD PLUG-IN RELAY 4P 24VDC + DIODE		9559057		
=CP+RC05xx-304K8	CP	1		SOCKET FOR RELAY C9		9559059		
=CP+RC05xx-305K1	CP	1		STANDARD PLUG-IN RELAY 4P 24VDC + DIODE		9559057		
=CP+RC05xx-305K1	CP	1		SOCKET FOR RELAY C9		9559059		
=CP+RC05xx-315P4	CP	1		ELECTROMECHANICAL HOUR COUNTER RAILMOUNTING		9559192		
=CP+RC05xx-401U3	CP	1		TEMPERATURE TRANSDUCER, OUTPUT 0-10V		9561965		
=CP+RC05xx-451F1	CP	1		MINIATURE CIRCUIT BREAKER 1P 0,5A/C		095190221		B
=CP+RC05xx-451G1	CP	1		POWER SUPPLY UNIT 240W 24VDC / 3.4A		9558614		B
=CP+RC05xx-451H4	CP	1		HMI NOT PROGRAMMED, DC		400004329		B
=CP+RC05xx-451H4	CP	1		F/UTP CABLE FLEXIBLE 2X RJ45 2MTR		9563280		

PARTS LIST

DEVICE TAG	FUNCTION GROUP	QTY	LENGTH	DESIGNATION	TYPE NUMBER	STORK PART NUMBER	DESCRIPTION	SERVICE
=CP+RC05xx-451H4	CP	1		WATER DRAINAGE COVER		9667417	MOUNT INSIDE DOOR ABOVE HMI	
=CP+RC05xx-SH1	CP	4		SUPPORT MADE OF INSULATING MATERIAL 10X3/6X6		9559520		
=CP+RC05xx-SH1	CP	1		PEN CONDUCTOR BUSBAR 3MMX10MM LENGTH 1MTR.		9559511		
=CP+RC05xx-SH1	CP	25		SHIELD CONNECTION TERMINAL BLOCK SK8		9559506		
=CP+RC05xx-W(-9H1)	CP	1		CABLE 3G1,0/AWG 18		500074403		
=CP+RC05xx-X0	CP	2		GROUND TERMINAL BLOCK 95MM		9559500		
=CP+RC05xx-X1	CP	4		GROUND TERMINAL BLOCK 50MM		9559499		
=CP+RC05xx-X1	CP	1		GROUND TERMINAL BLOCK 95MM		9559500		
=CP+RC05xx-X1A	CP	1		COVER		9559551		
=CP+RC05xx-X1A	CP	2		END CLAMP		9559470		
=CP+RC05xx-X1A	CP	1		TERMINAL STRIP MARKER		9559630		
=CP+RC05xx-X1A	CP	36		FLAT BRACKET FOR FIXING MOUNTING RAIL 15MM		9559632		
=CP+RC05xx-X1A	CP	1		COVER 1.8MM GRAY		9559468		
=CP+RC05xx-X1A	CP	1		SPACER PLATE, COMPENSATES FOR LEVEL OFFSET		9559548		
=CP+RC05xx-X1A	CP	6		TWO LEVEL TERMINAL BLOCK 4MM		9559552		
=CP+RC05xx-X1A	CP	3		TERMINAL BLOCK 4 MM		9559659	Voorheen, UK5, bestelnr.: 30 04 1 6	
=CP+RC05xx-X1A	CP	2		TWO LEVEL GROUND TERMINAL BLOCK		9559554		
=CP+RC05xx-X1A	CP	1		GROUND TERMINAL BLOCK 4MM		9559663	Voorheen USLKG4, bestelnr.: 04 41 01 2	
=CP+RC05xx-X2A	CP	1		END CLAMP		9559470		
=CP+RC05xx-X2A	CP	1		TERMINAL STRIP MARKER		9559630		
=CP+RC05xx-X2A	CP	1		COVER		9559551		
=CP+RC05xx-X2A	CP	1		SPACER PLATE, COMPENSATES FOR LEVEL OFFSET		9559548		
=CP+RC05xx-X2A	CP	12		DOUBLE LEVEL TERMINAL BLOCK 4MM 1 FIXED BR.		9559544		
=CP+RC05xx-X2A	CP	1		TWO LEVEL GROUND TERMINAL BLOCK		9559554		
=CP+RC05xx-X2B	CP	1		END CLAMP		9559470		
=CP+RC05xx-X2B	CP	1		TERMINAL STRIP MARKER		9559630		
=CP+RC05xx-X2B	CP	1		COVER		9559551		
=CP+RC05xx-X2B	CP	1		SPACER PLATE, COMPENSATES FOR LEVEL OFFSET		9559548		
=CP+RC05xx-X2B	CP	3		DOUBLE LEVEL TERMINAL BLOCK 4MM 1 FIXED BR.		9559544		
=CP+RC05xx-X2C	CP	1		END CLAMP		9559470		
=CP+RC05xx-X2C	CP	1		TERMINAL STRIP MARKER		9559630		
=CP+RC05xx-X2C	CP	1		COVER		9559551		
=CP+RC05xx-X2C	CP	1		SPACER PLATE, COMPENSATES FOR LEVEL OFFSET		9559548		
=CP+RC05xx-X2C	CP	4		DOUBLE LEVEL TERMINAL BLOCK 4MM 1 FIXED BR.		9559544		
=CP+RC05xx-X2D	CP	1		END CLAMP		9559470		
=CP+RC05xx-X2D	CP	1		TERMINAL STRIP MARKER		9559630		
=CP+RC05xx-X2D	CP	1		COVER		9559551		
=CP+RC05xx-X2D	CP	1		SPACER PLATE, COMPENSATES FOR LEVEL OFFSET		9559548		

PARTS LIST

DEVICE TAG	FUNCTION GROUP	QTY	LENGTH	DESIGNATION	TYPE NUMBER	STORK PART NUMBER	DESCRIPTION	SERVICE
=CP+RC05xx-X2D	CP	2		DOUBLE LEVEL TERMINAL BLOCK 4MM 1 FIXED BR.		9559544		
=CP+RC05xx-X2E	CP	1		END CLAMP		9559470		
=CP+RC05xx-X2E	CP	1		TERMINAL STRIP MARKER		9559630		
=CP+RC05xx-X2E	CP	1		COVER		9559551		
=CP+RC05xx-X2E	CP	1		SPACER PLATE, COMPENSATES FOR LEVEL OFFSET		9559548		
=CP+RC05xx-X2E	CP	1		DOUBLE LEVEL TERMINAL BLOCK 4MM 1 FIXED BR.		9559544		
=CP+RC05xx-X3A	CP	1		END CLAMP		9559470		
=CP+RC05xx-X3A	CP	1		TERMINAL STRIP MARKER		9559630		
=CP+RC05xx-X3A	CP	1		COVER		9559551		
=CP+RC05xx-X3A	CP	1		SPACER PLATE, COMPENSATES FOR LEVEL OFFSET		9559548		
=CP+RC05xx-X3A	CP	11		DOUBLE LEVEL TERMINAL BLOCK 4MM 1 FIXED BR.		9559544		
=CP+RC05xx-X3B	CP	1		END CLAMP		9559470		
=CP+RC05xx-X3B	CP	1		TERMINAL STRIP MARKER		9559630		
=CP+RC05xx-X3B	CP	1		COVER		9559551		
=CP+RC05xx-X3B	CP	1		SPACER PLATE, COMPENSATES FOR LEVEL OFFSET		9559548		
=CP+RC05xx-X3B	CP	3		DOUBLE LEVEL TERMINAL BLOCK 4MM 1 FIXED BR.		9559544		
=CP+RC05xx-X3C	CP	1		END CLAMP		9559470		
=CP+RC05xx-X3C	CP	1		TERMINAL STRIP MARKER		9559630		
=CP+RC05xx-X3C	CP	1		COVER		9559551		
=CP+RC05xx-X3C	CP	1		SPACER PLATE, COMPENSATES FOR LEVEL OFFSET		9559548		
=CP+RC05xx-X3C	CP	3		DOUBLE LEVEL TERMINAL BLOCK 4MM 1 FIXED BR.		9559544		
=CP+RC05xx-X4A	CP	1		END CLAMP		9559470		
=CP+RC05xx-X4A	CP	1		TERMINAL STRIP MARKER		9559630		
=CP+RC05xx-X4A	CP	1		COVER		9559551		
=CP+RC05xx-X4A	CP	1		SPACER PLATE, COMPENSATES FOR LEVEL OFFSET		9559548		
=CP+RC05xx-X4A	CP	12		DOUBLE LEVEL TERMINAL BLOCK 4MM 1 FIXED BR.		9559544		
=CP+RC05xx-X4B	CP	1		END CLAMP		9559470		
=CP+RC05xx-X4B	CP	1		TERMINAL STRIP MARKER		9559630		
=CP+RC05xx-X4B	CP	1		COVER		9559551		
=CP+RC05xx-X4B	CP	1		SPACER PLATE, COMPENSATES FOR LEVEL OFFSET		9559548		
=CP+RC05xx-X4B	CP	5		DOUBLE LEVEL TERMINAL BLOCK 4MM 1 FIXED BR.		9559544		
=CP+RC05xx-X5A	CP	1		END CLAMP		9559470		
=CP+RC05xx-X5A	CP	1		TERMINAL STRIP MARKER		9559630		
=CP+RC05xx-X5A	CP	1		COVER		9559551		
=CP+RC05xx-X5A	CP	1		SPACER PLATE, COMPENSATES FOR LEVEL OFFSET		9559548		
=CP+RC05xx-X5A	CP	8		DOUBLE LEVEL TERMINAL BLOCK 4MM 1 FIXED BR.		9559544		
=CP+RC05xx-X6A	CP	1		END CLAMP		9559470		
=CP+RC05xx-X6A	CP	1		TERMINAL STRIP MARKER		9559630		

PARTS LIST

[illegible]

previous:
910

next:
912



THIS DRAWING REMAINS PROPERTY OF MAREL ENTITY,
SPECIFIED ON PAGE 1 AND MAY NOT BE COPIED OR
REPRODUCED IN WHATEVER FORM WITHOUT PRIOR WRITTEN
CONSENT OF MAREL. FURTHER THIS DRAWING MAY NOT BE
DISCLOSED OR GIVEN TO ANY OTHER PARTY FOR INFORMATION
OR USE WITHOUT PRIOR WRITTEN CONSENT OF MAREL.

PROJ. TYPE: RC05xx
CUSTOMER:
COUNTRY:

PAGE DESCR.: PARTS LIST
=REP REPORTS

PAGE REV. DATE:	PAGE REV.	
	PROJ. REV.	D
EDITED ON: 2013.07.11	BY:	
CREATED ON: 2012.11.16	BY: JEL	

SCALE: 1:1 PAGE: 911

DWG. NO. 9667279

SHEET / TOTAL : (91 / 117)

PARTS LIST

[illegible]

previous:
911

next:
913



THIS DRAWING REMAINS PROPERTY OF MAREL ENTITY,
SPECIFIED ON PAGE 1 AND MAY NOT BE COPIED OR
REPRODUCED IN WHATEVER FORM WITHOUT PRIOR WRITTEN
CONSENT OF MAREL. FURTHER THIS DRAWING MAY NOT BE
DISCLOSED OR GIVEN TO ANY OTHER PARTY FOR INFORMATION
OR USE WITHOUT PRIOR WRITTEN CONSENT OF MAREL.

PROJ. TYPE: RC05xx
CUSTOMER:
COUNTRY:

PAGE DESCR.: PARTS LIST
=REP REPORTS

PAGE REV. DATE:	PAGE REV.	
	PROJ. REV.	D
EDITED ON: 2013.07.11	BY:	
CREATED ON: 2012.11.16	BY: JEL	

SCALE: 1:1 PAGE: 912

DWG. NO. 9667279

SHEET / TOTAL : (92 / 117)

PARTS LIST

[illegible]

previous:
912

next:
914



THIS DRAWING REMAINS PROPERTY OF MAREL ENTITY,
SPECIFIED ON PAGE 1 AND MAY NOT BE COPIED OR
REPRODUCED IN WHATEVER FORM WITHOUT PRIOR WRITTEN
CONSENT OF MAREL. FURTHER THIS DRAWING MAY NOT BE
DISCLOSED OR GIVEN TO ANY OTHER PARTY FOR INFORMATION
OR USE WITHOUT PRIOR WRITTEN CONSENT OF MAREL.

PROJ. TYPE: RC05xx

CUSTOMER:

COUNTRY:

PAGE DESCR.:	PARTS LIST
=REP	REPORTS

PAGE REV. DATE:

PAGE REV.

07 11 PV:

SCALE:	PAGE:	913
1:1		

DWG. NO. 9667279

SHEET / TOTAL : (93 / 117)

PARTS LIST

DEVICE TAG	FUNCTION GROUP	QTY	LENGTH	DESIGNATION	TYPE NUMBER	STORK PART NUMBER	DESCRIPTION	SERVICE
=TB+RC05xx-4E1	TB01	1		ENCLOSURE 160X560X90		095700129	Polyester IP66	
=TB+RC05xx-4E1	TB01	7		CABLE GLAND BODY PVDF-FLUOR M25X1.5		9560764		
=TB+RC05xx-4E1	TB01	5		CABLE GLAND BODY PVDF-FLUOR M32X1.5		9560765		
=TB+RC05xx-X2A.1	TB01	1		END CLAMP		9559470		
=TB+RC05xx-X2A.1	TB01	1		TERMINAL STRIP MARKER		9559630		
=TB+RC05xx-X2A.1	TB01	1		COVER		9559551		
=TB+RC05xx-X2A.1	TB01	1		SPACER PLATE, COMPENSATES FOR LEVEL OFFSET		9559548		
=TB+RC05xx-X2A.1	TB01	15		DOUBLE LEVEL TERMINAL BLOCK 4MM 1 FIXED BR.		9559544		
=TB+RC05xx-X2A.1	TB01	2		TWO LEVEL GROUND TERMINAL BLOCK		9559554		
=TB+RC05xx-X3A.1	TB01	1		END CLAMP		9559470		
=TB+RC05xx-X3A.1	TB01	1		TERMINAL STRIP MARKER		9559630		
=TB+RC05xx-X3A.1	TB01	1		COVER		9559551		
=TB+RC05xx-X3A.1	TB01	1		SPACER PLATE, COMPENSATES FOR LEVEL OFFSET		9559548		
=TB+RC05xx-X3A.1	TB01	1		INSERTION BRIDGE DIVISIBLE 10-POS BLUE		9559535		
=TB+RC05xx-X3A.1	TB01	1		INSERTION BRIDGE DIVISIBLE 10-POS RED		9559534		
=TB+RC05xx-X3A.1	TB01	11		DOUBLE LEVEL TERMINAL BLOCK 4MM 1 FIXED BR.		9559544		
=TB+RC05xx-X3A.1	TB01	1		THREE LEVEL SENSOR TERMINAL BLOCK		9559491		
=TB+RC05xx-X3A.1	TB01	2		THREE LEVEL SENSOR TERMINAL BLOCK		9559492		
=TB+RC05xx-X4A.1	TB01	1		END CLAMP		9559470		
=TB+RC05xx-X4A.1	TB01	1		TERMINAL STRIP MARKER		9559630		
=TB+RC05xx-X4A.1	TB01	1		INSERTION BRIDGE DIVISIBLE 80-POS BLUE		9559533		
=TB+RC05xx-X4A.1	TB01	1		INSERTION BRIDGE DIVISIBLE 80-POS RED		9559532		
=TB+RC05xx-X4A.1	TB01	1		COVER		9559551		
=TB+RC05xx-X4A.1	TB01	1		SPACER PLATE, COMPENSATES FOR LEVEL OFFSET		9559548		
=TB+RC05xx-X4A.1	TB01	3		DOUBLE LEVEL TERMINAL BLOCK 4MM 1 FIXED BR.		9559544		
=TB+RC05xx-X4A.1	TB01	2		THREE LEVEL SENSOR TERMINAL BLOCK		9559491		
=TB+RC05xx-X4A.1	TB01	14		THREE LEVEL SENSOR TERMINAL BLOCK		9559492		
=TB+RC05xx-X5A.1	TB01	2		END CLAMP		9559470		
=TB+RC05xx-X5A.1	TB01	1		TERMINAL STRIP MARKER		9559630		
=TB+RC05xx-X5A.1	TB01	1		COVER		9559551		
=TB+RC05xx-X5A.1	TB01	1		SPACER PLATE, COMPENSATES FOR LEVEL OFFSET		9559548		
=TB+RC05xx-X5A.1	TB01	3		DOUBLE LEVEL TERMINAL BLOCK 4MM 1 FIXED BR.		9559544		

PARTS LIST

[illegible]

previous:
914

next:
916



THIS DRAWING REMAINS PROPERTY OF MAREL ENTITY,
SPECIFIED ON PAGE 1 AND MAY NOT BE COPIED OR
REPRODUCED IN WHATEVER FORM WITHOUT PRIOR WRITTEN
CONSENT OF MAREL. FURTHER THIS DRAWING MAY NOT BE
DISCLOSED OR GIVEN TO ANY OTHER PARTY FOR INFORMATION
OR USE WITHOUT PRIOR WRITTEN CONSENT OF MAREL.

PROJ. TYPE: RC05xx

CUSTOMER:

COUNTRY:

PAGE DESCR.: PARTS LIST
=REP REPORTS

PAGE REV. DATE:

PAGE REV.

PROJ. REV.

SCALE: 1:1 PAGE: 915

DWG. NO.	966/2/9
----------	---------

SHEET / TOTAL : (95 / 117)

PARTS LIST

[illegible]

previous:
915

next:
917



THIS DRAWING REMAINS PROPERTY OF MAREL ENTITY,
SPECIFIED ON PAGE 1 AND MAY NOT BE COPIED OR
REPRODUCED IN WHATEVER FORM WITHOUT PRIOR WRITTEN
CONSENT OF MAREL. FURTHER THIS DRAWING MAY NOT BE
DISCLOSED OR GIVEN TO ANY OTHER PARTY FOR INFORMATION
OR USE WITHOUT PRIOR WRITTEN CONSENT OF MAREL.

PROJ. TYPE:	RC05xx
CUSTOMER:	
COUNTRY:	

PAGE DESCR.:	PARTS LIST
=REP	REPORTS

PAGE REV. DATE:

PAGE REV.

PROJ REV

	SCALE:	PAGE:	916
	1:1		

D	DWG. NO.	9667279
---	----------	---------

SHEET / TOTAL : (96 / 117)

© MAREL 2010 ALL RIGHTS RESERVED WORLDWIDE.

www.marel.com

EDITED ON:	2013.07.11
------------	------------

BY:

CREATED ON: 2012.11.16

BY: JEL

SHEET / TOTAL : (96 / 117)

PARTS LIST

[illegible]

previous:
916

next:
919



THIS DRAWING REMAINS PROPERTY OF MAREL ENTITY,
SPECIFIED ON PAGE 1 AND MAY NOT BE COPIED OR
REPRODUCED IN WHATEVER FORM WITHOUT PRIOR WRITTEN
CONSENT OF MAREL. FURTHER THIS DRAWING MAY NOT BE
DISCLOSED OR GIVEN TO ANY OTHER PARTY FOR INFORMATION
OR USE WITHOUT PRIOR WRITTEN CONSENT OF MAREL.

PROJ. TYPE: RC05xx
CUSTOMER:
COUNTRY:

PAGE DESCR.: PARTS LIST
=REP REPORTS


PAGE REV. DATE:	PAGE REV.	
	PROJ. REV.	D
EDITED ON: 2013.07.11	BY:	
CREATED ON: 2012.11.16	BY: JEL	


SCALE: 1:1 PAGE: 917


DWG. NO. 9667279

SHEET / TOTAL : (97 / 117)




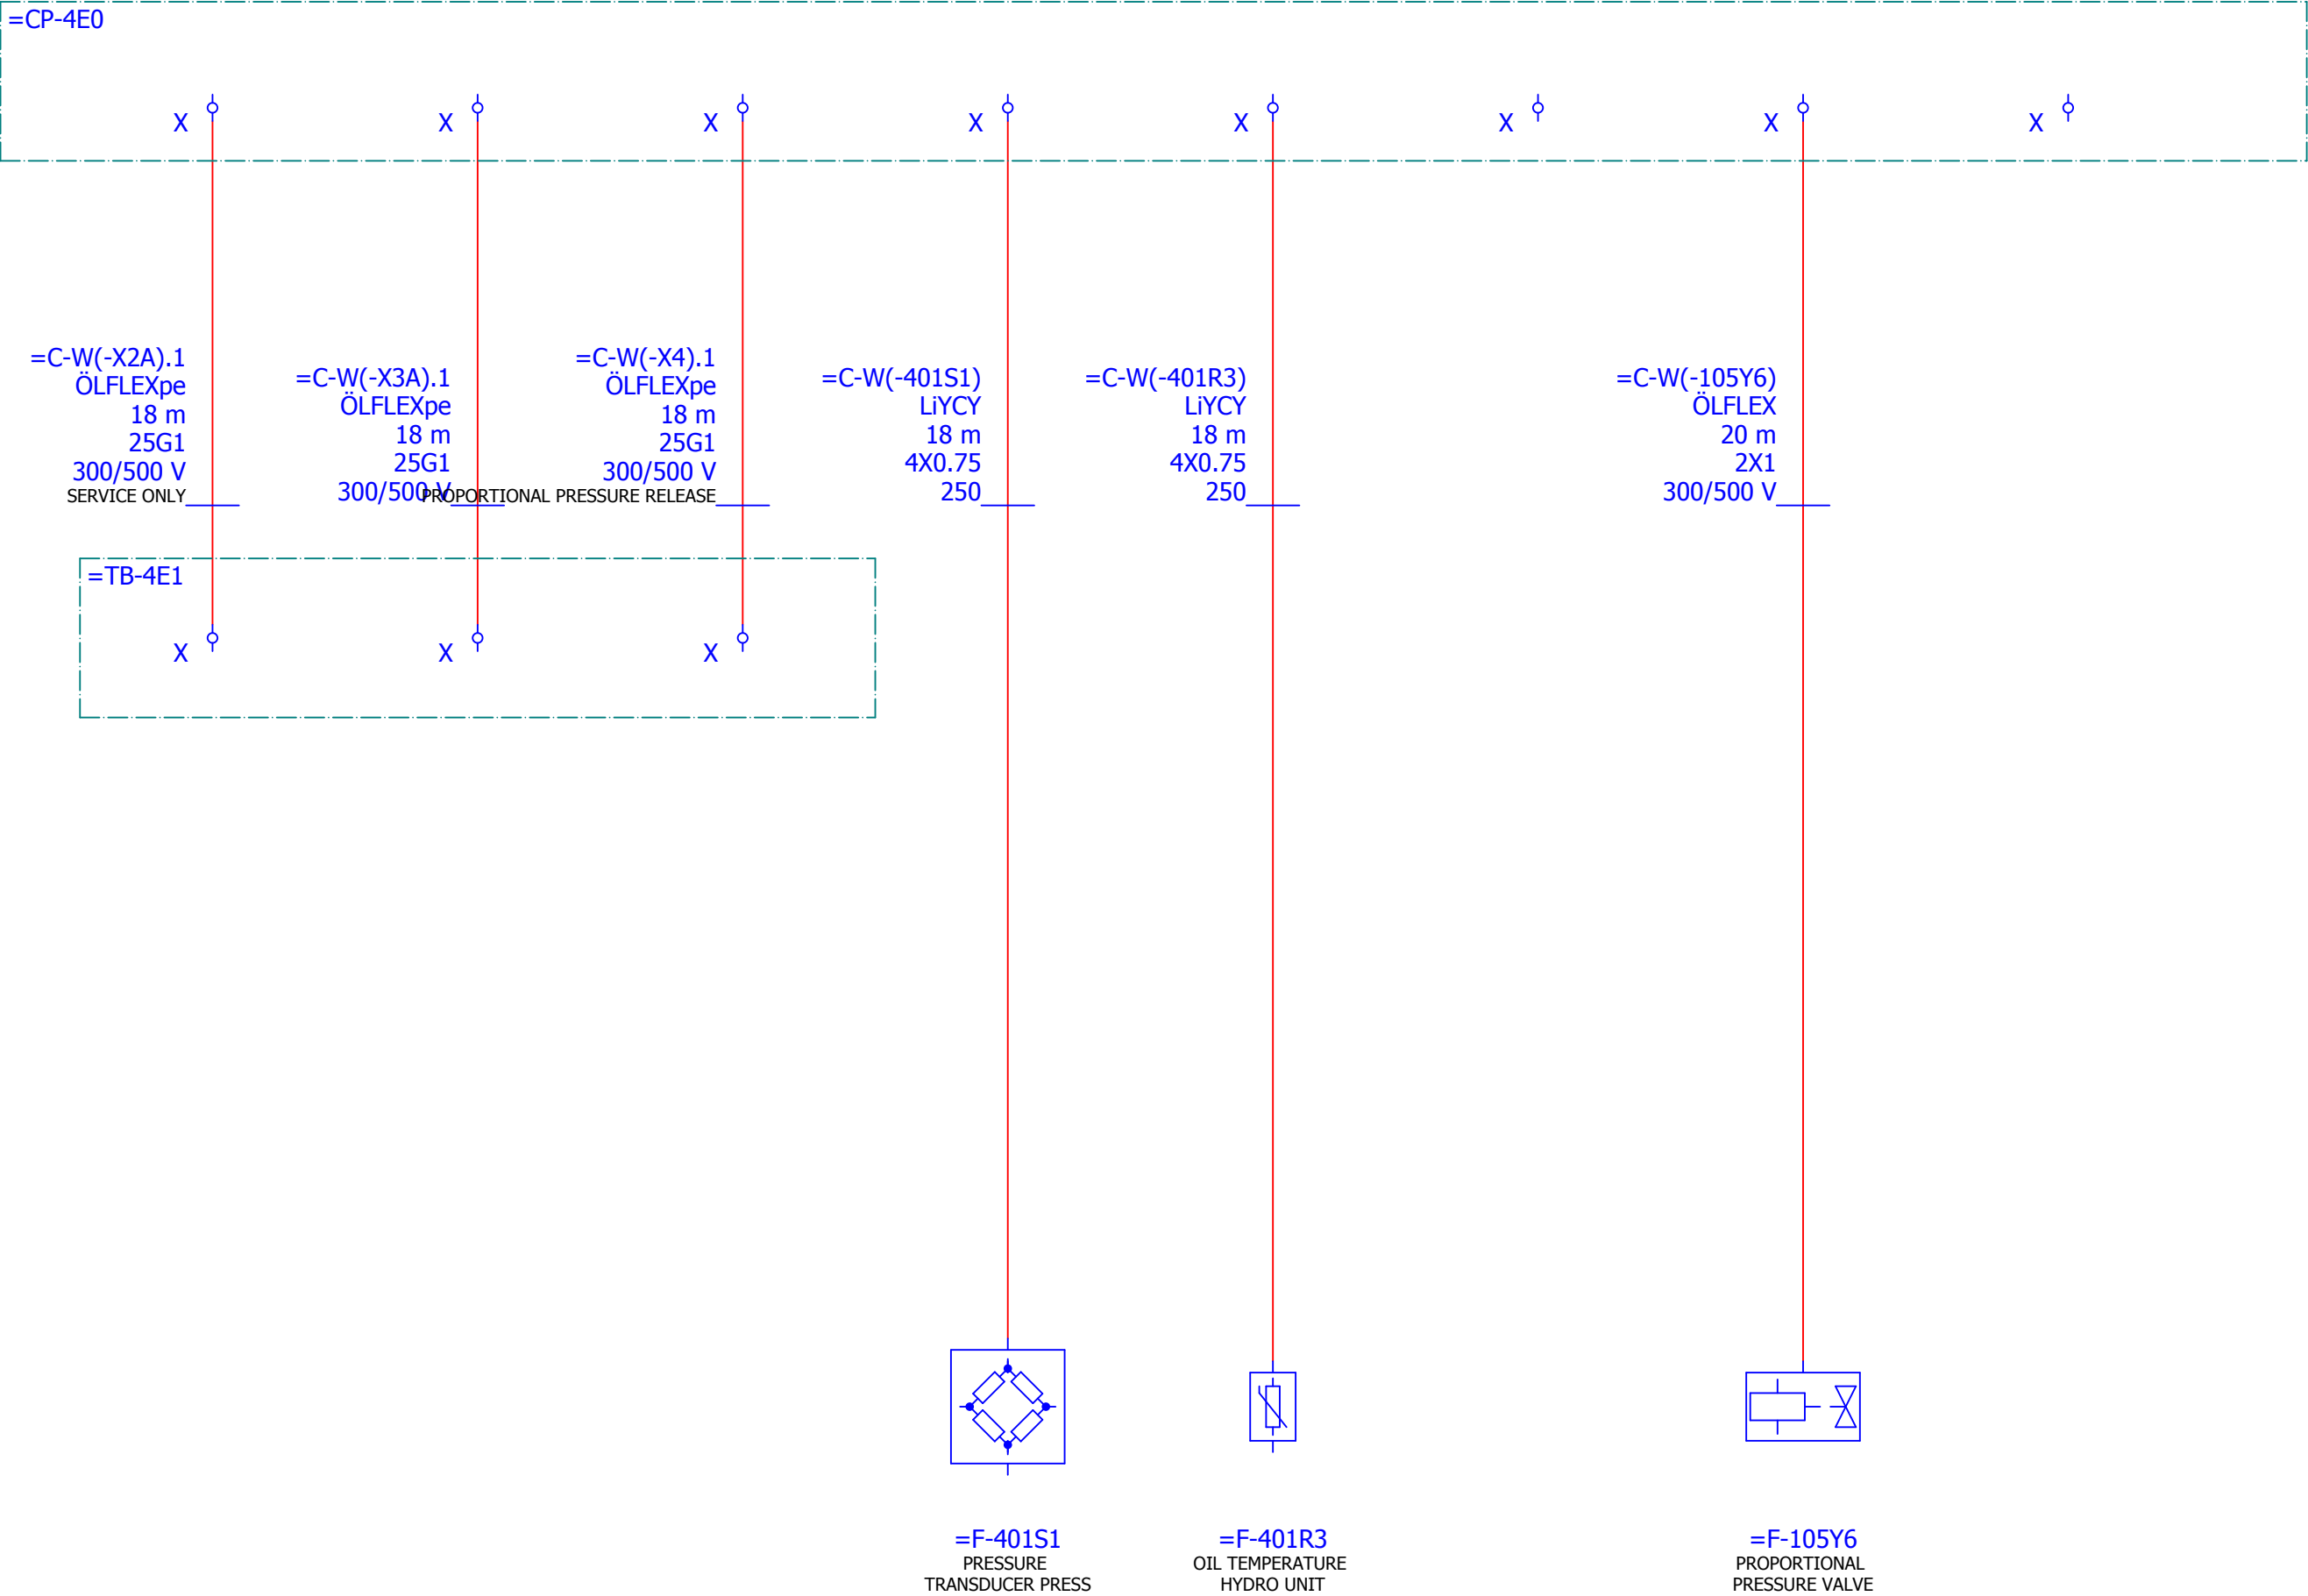

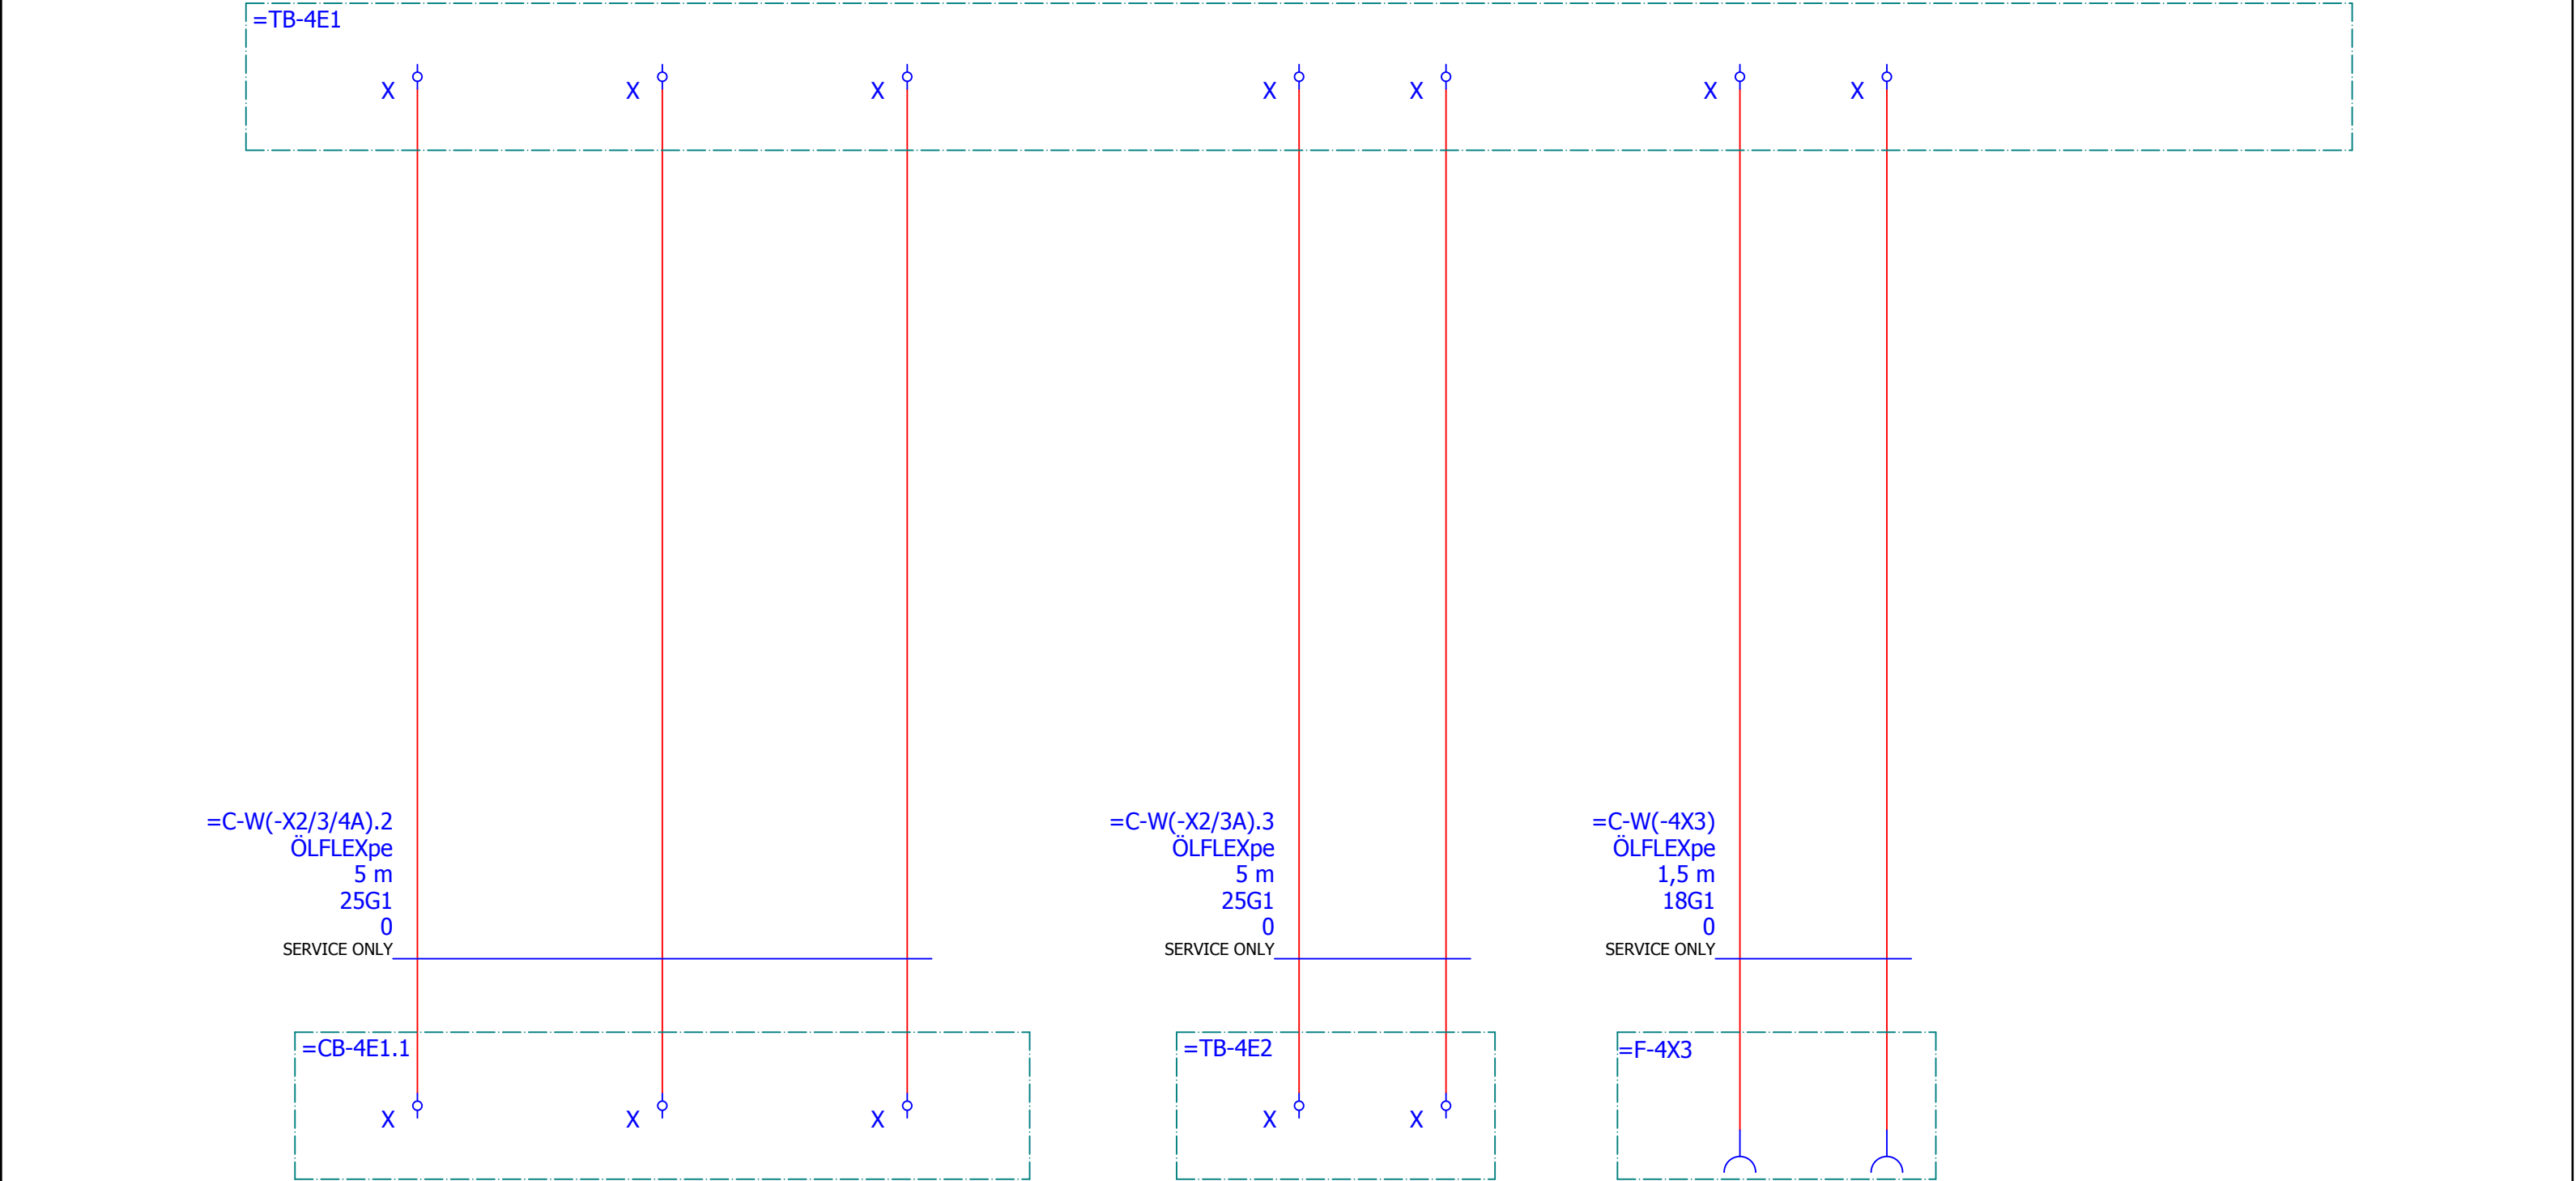

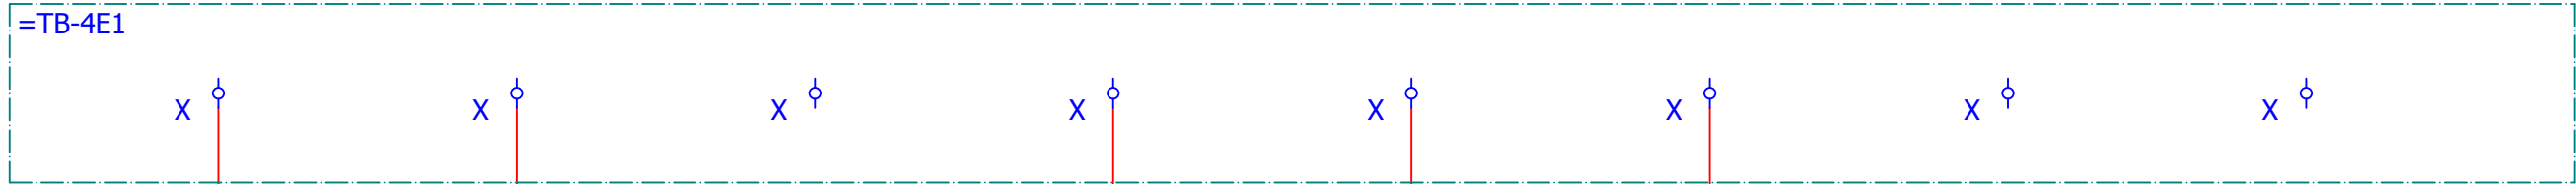

=C-W(-201S3)
ÖLFLEX
3 m
2X1
300/500 V

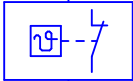


=F-201S3
OIL THERMOSTAT

=C-W(-203S6)
ÖLFLEX
4 m
2X1
300/500 V




=F-203S6
OIL FILTER PRESSURE
SIDE

=C-W(-301Y5)
ÖLFLEXpe
4,5 m
4G0.5
500

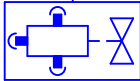


=F-301Y5
DMM PRESSING
CHAMBER / MRS SIDE
CYLINDER FORWARDS

=C-W(-301Y6)
ÖLFLEXpe
4,5 m
4G0.5
500

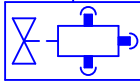

=F-301Y6
DMM PRESSING
CHAMBER / MRS SIDE
CYLINDER REVERSE


=C-W(-301Y7)
ÖLFLEXpe
3,5 m
4G0.5
500

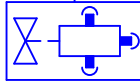

=F-301Y7
COOLING WATER SUPPLY



previous:
1004

next:
1006

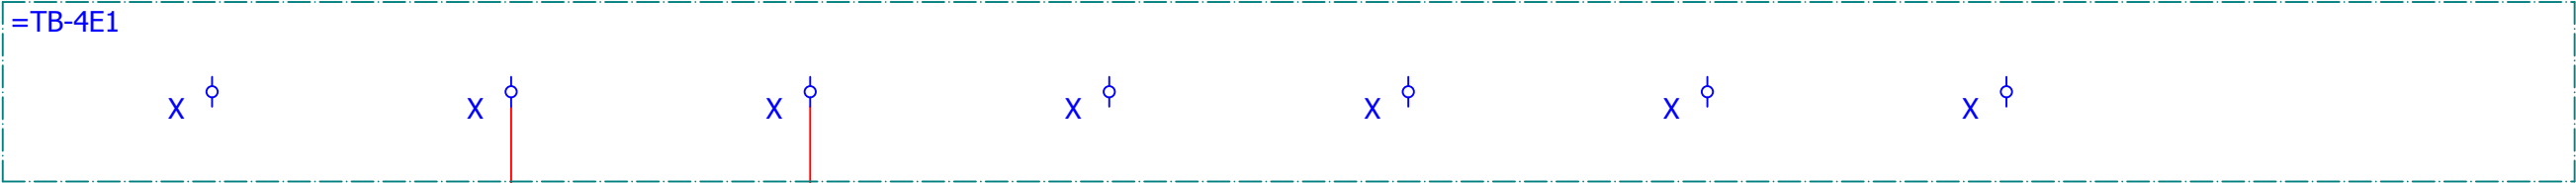

=C-W(-303Y6)
ÖLFLEXpe
2 m
4G0.5
500

=C-W(-303Y7)
ÖLFLEXpe
2 m
4G0.5
500

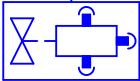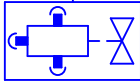


=F-303Y6
DMM PRESS CYLINDER
FORWARD / MRS PISTON
AREA TO TANK


=F-303Y7
DMM PRESS CYLINDER
REVERSE / MRS PUMP TO
PISTON AREA

previous:
1005

next:
1008

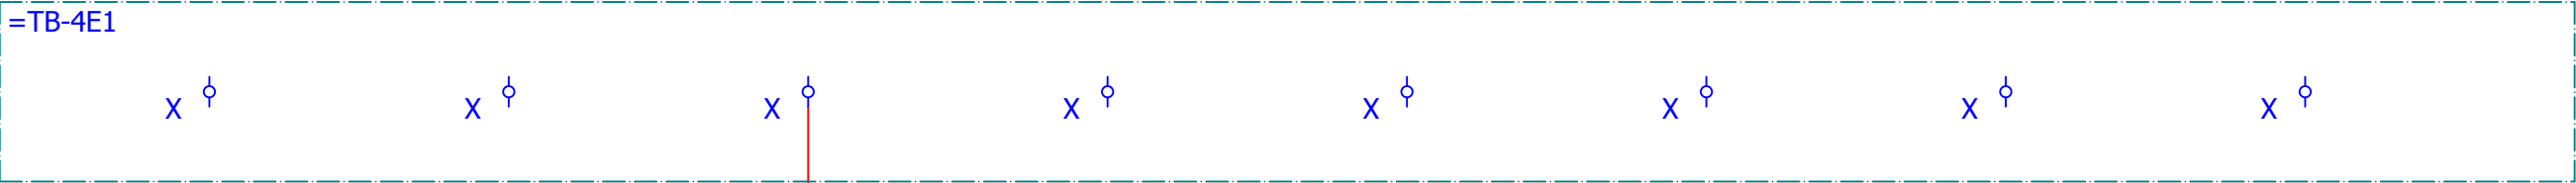

=C-W(-315Y3)
ÖLFLEXpe
4,5 m
4G0.5
500

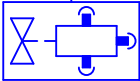


=F-315Y3
WATER SUPPLY
WASHRING



LiYff
9 m
4x0.34


=F-W(-206B6)
PVC
10 m
4x0.34

OUTFEED CONVEYOR B28

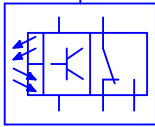

=F-202B9

BONECAKE FREE

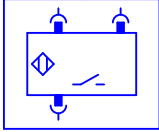

=F-206B6


OUTFEED CONVEYOR
B28

previous:

1009

next:

+RC0522/1011

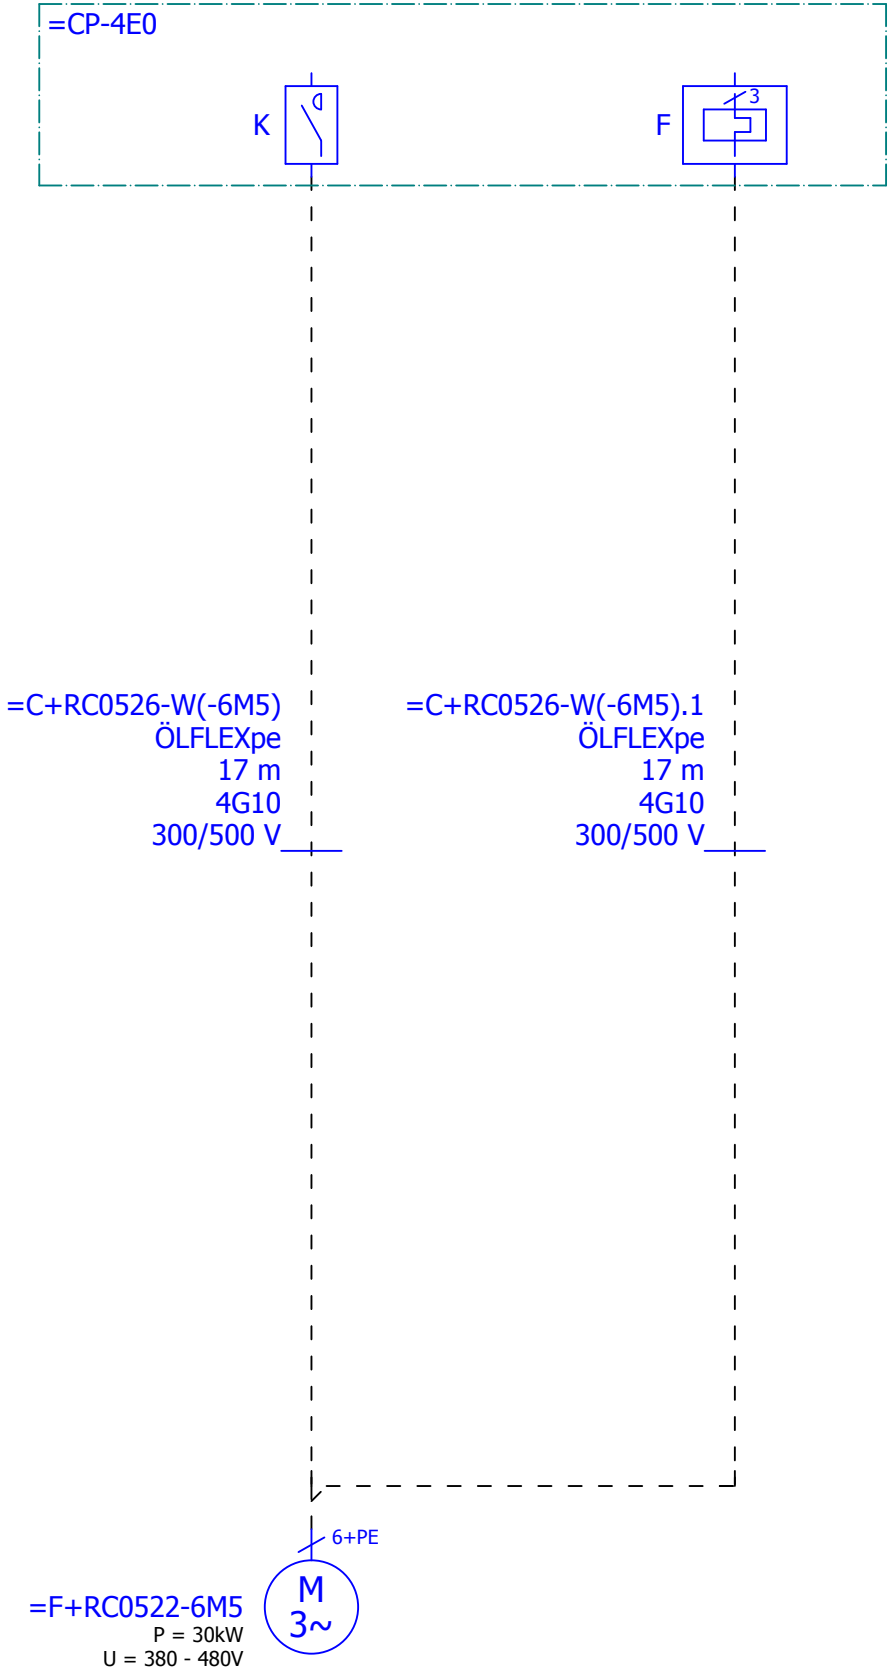

previous:
+RC05xx/1010

next:
1012

=TB-4E2


X ϕ

X ϕ


X ϕ

X ϕ

=F+RC0522
-W(-202B7)
LiYff
10 m
4x0.34

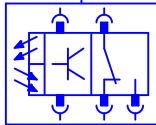

=F+RC0522-202B7
HOPPER EMPTY

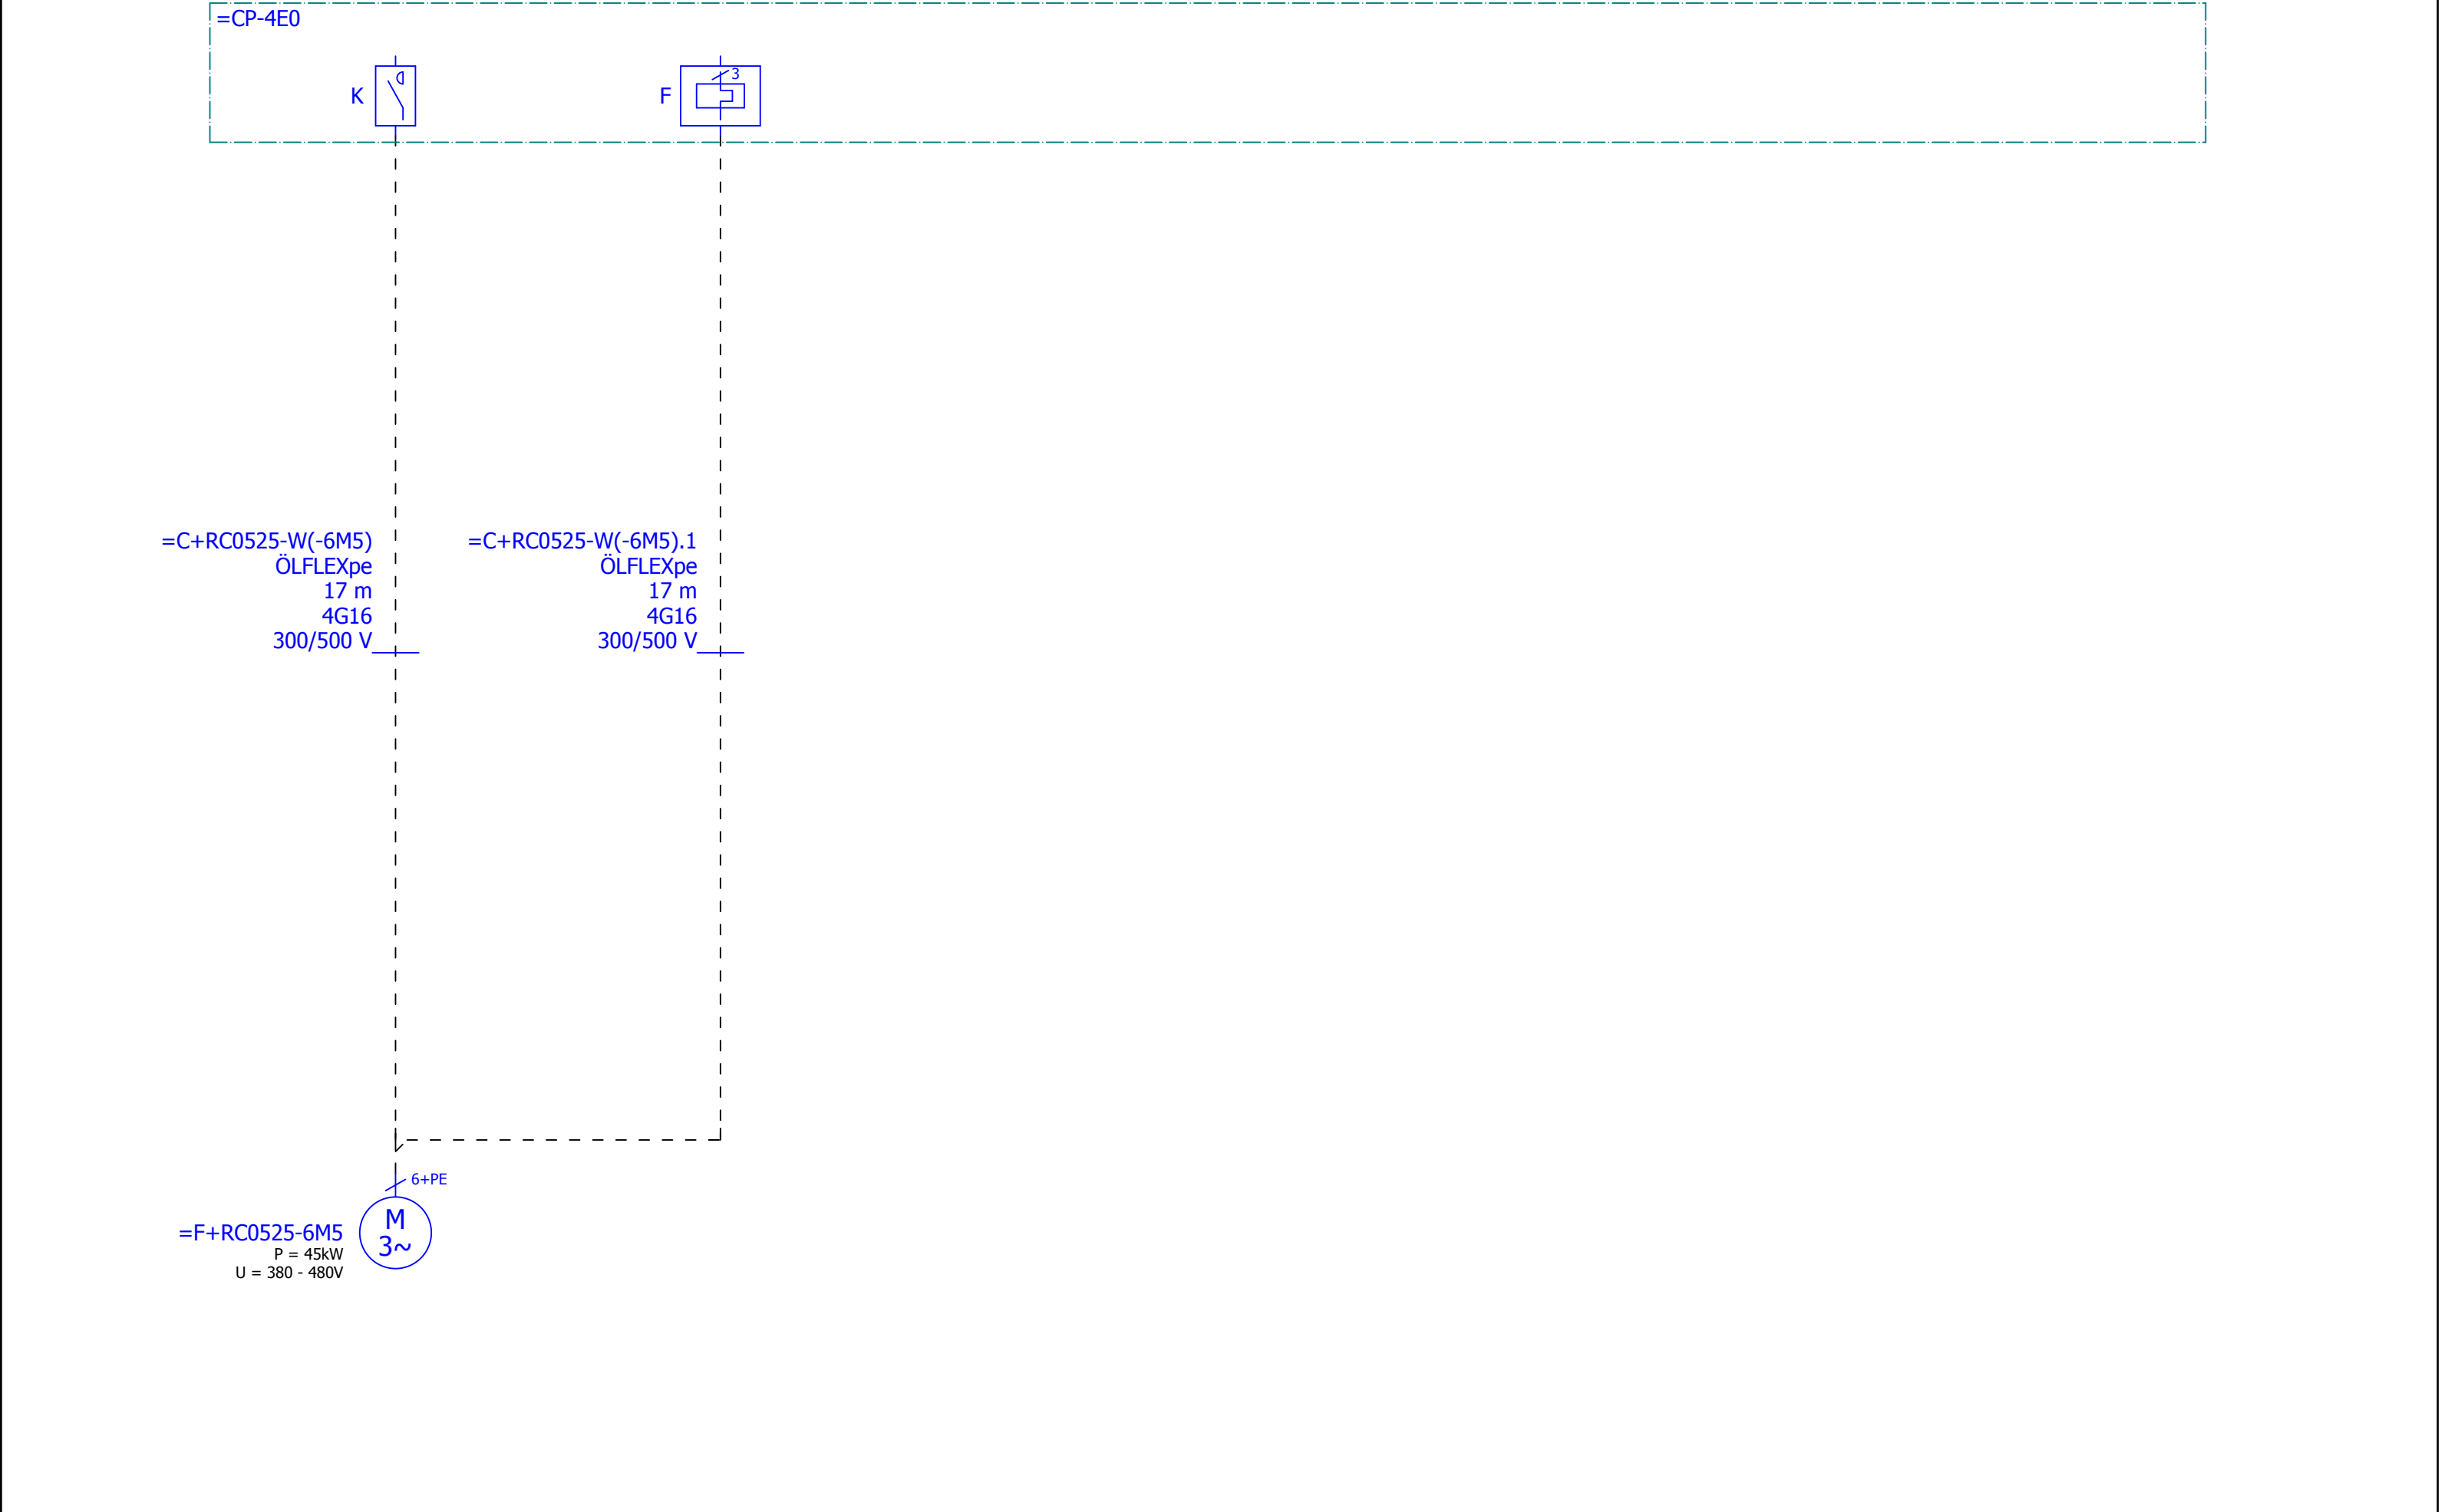




=C+RC0525-W(-401B7)
LIYCY
18 m
3X0.5



previous:
1021

next:
1023

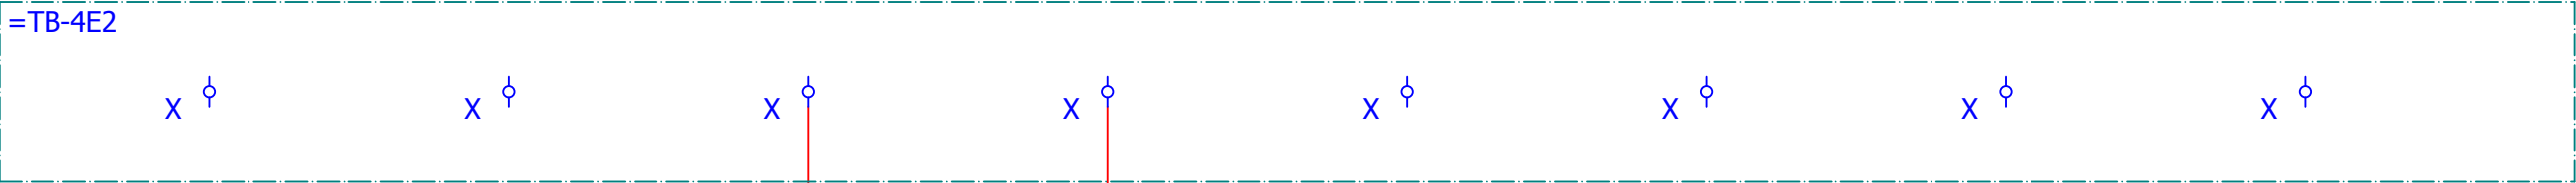

5 m

5 m



=F+RC0525-102S6

COVER LEFT

=F+RC0525-102S7


COVER RIGHT



LiYff


9 m

4x0.34

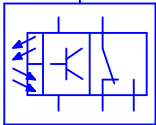

=F+RC0525-202B8

BONECAKE FREE

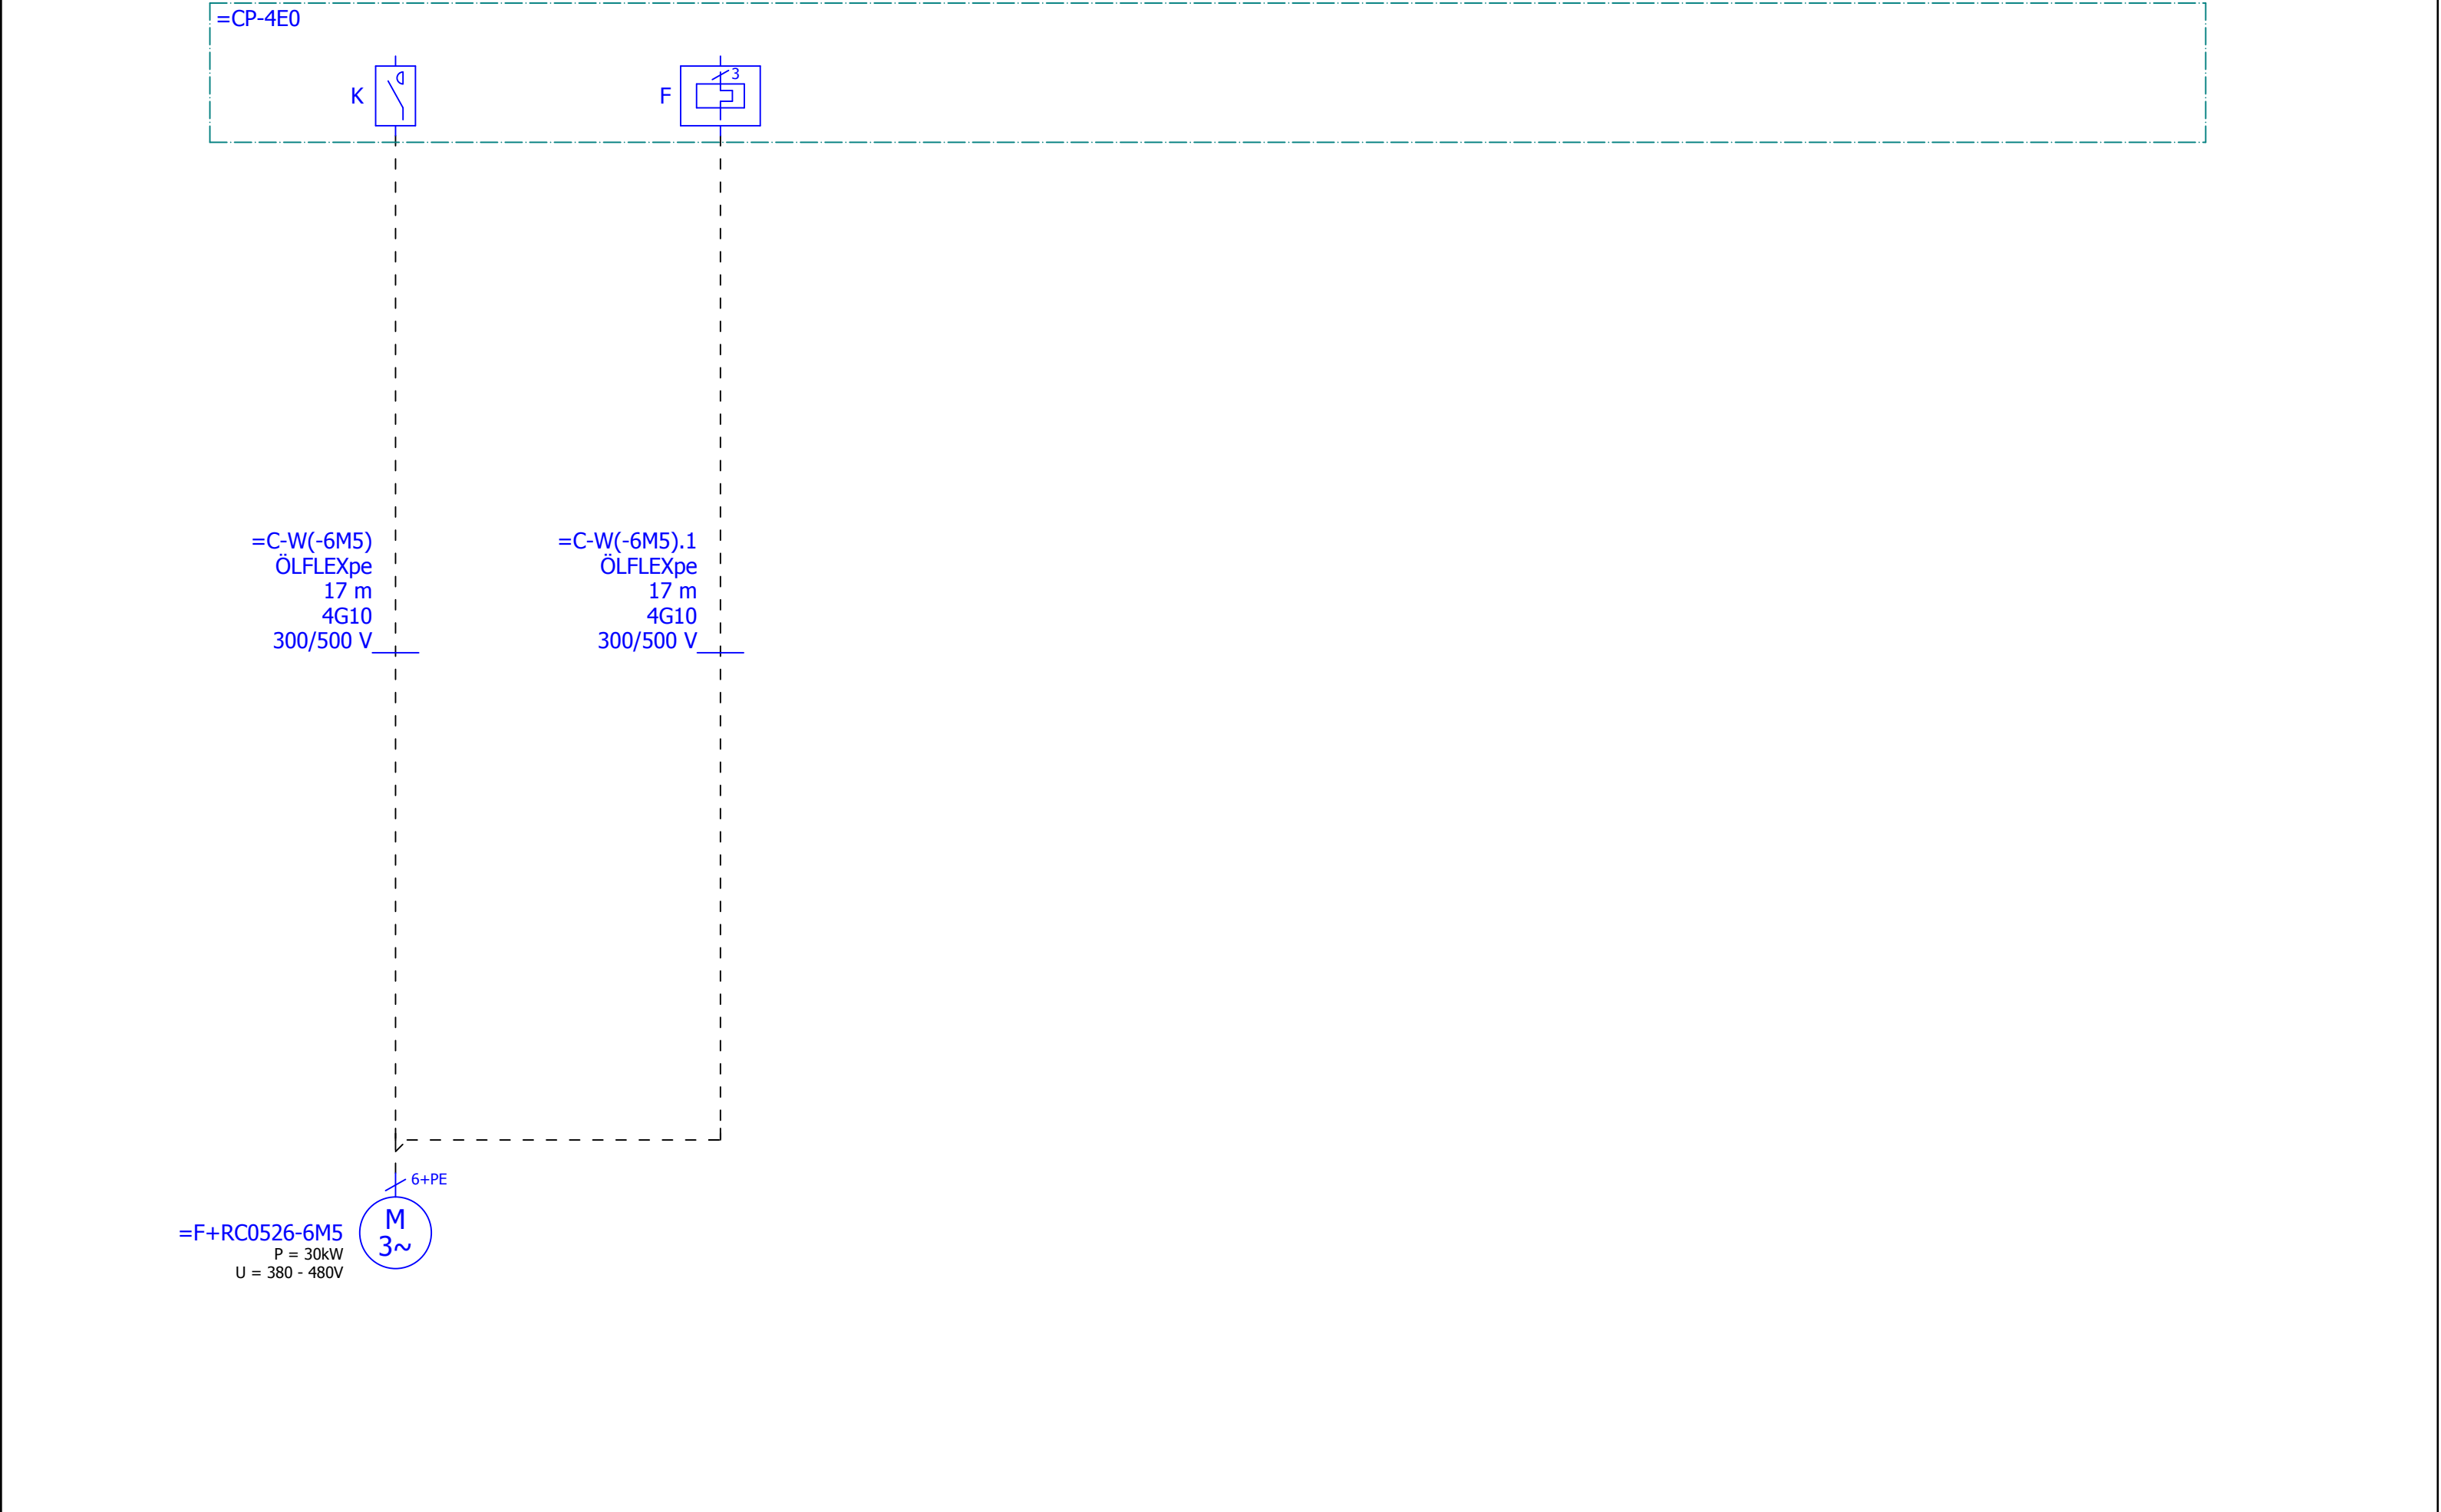

=CP-4E0

X



=C+RC0526-W(-401B7)
LiYCY
18 m
3X0.5


=TB-4E1

X



previous:
1031

next:
1033

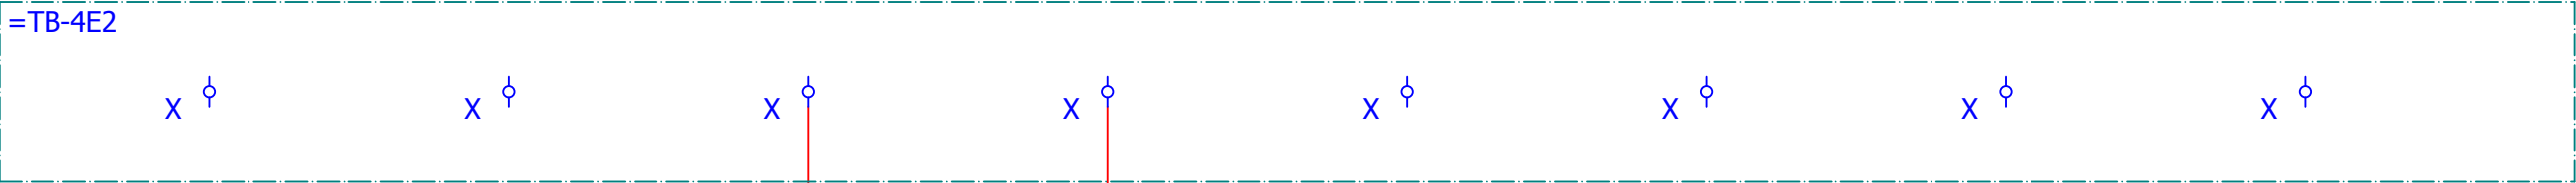

5 m

5 m



=F+RC0526-102S6

COVER LEFT

=F+RC0526-102S7

COVER RIGHT

previous:
1033

next: